




SECTION B

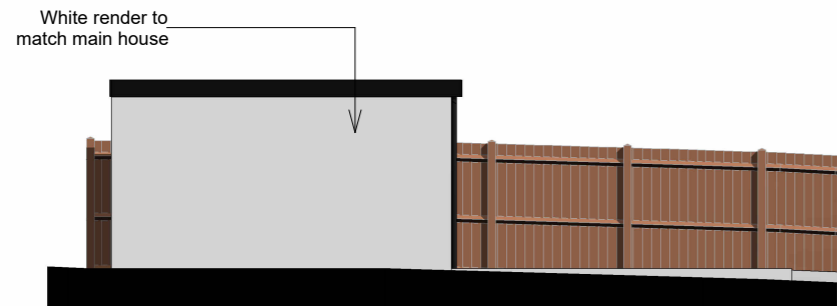


LEFT ELEVATION

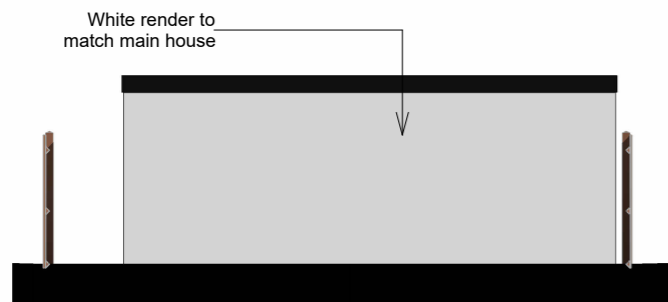


REAR ELEVATION

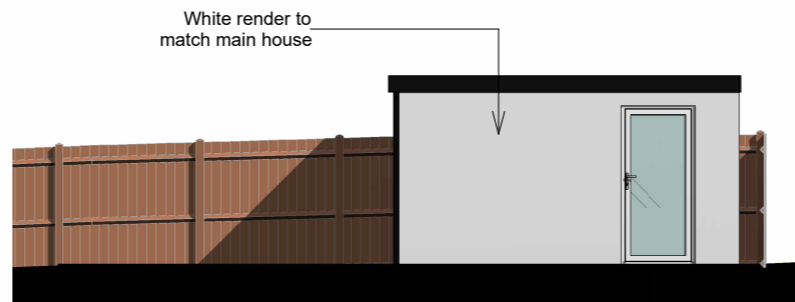


RIGHT ELEVATION

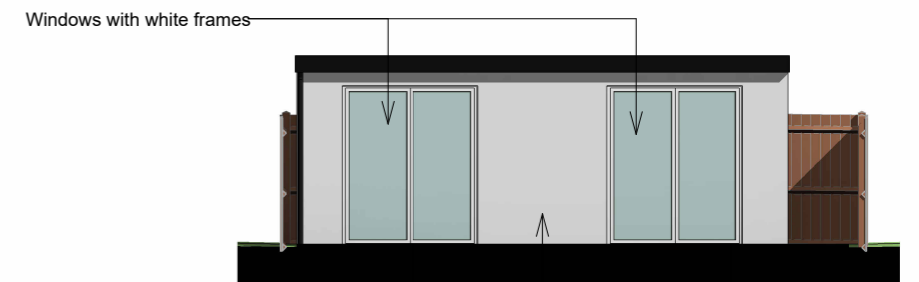


FRONT ELEVATION

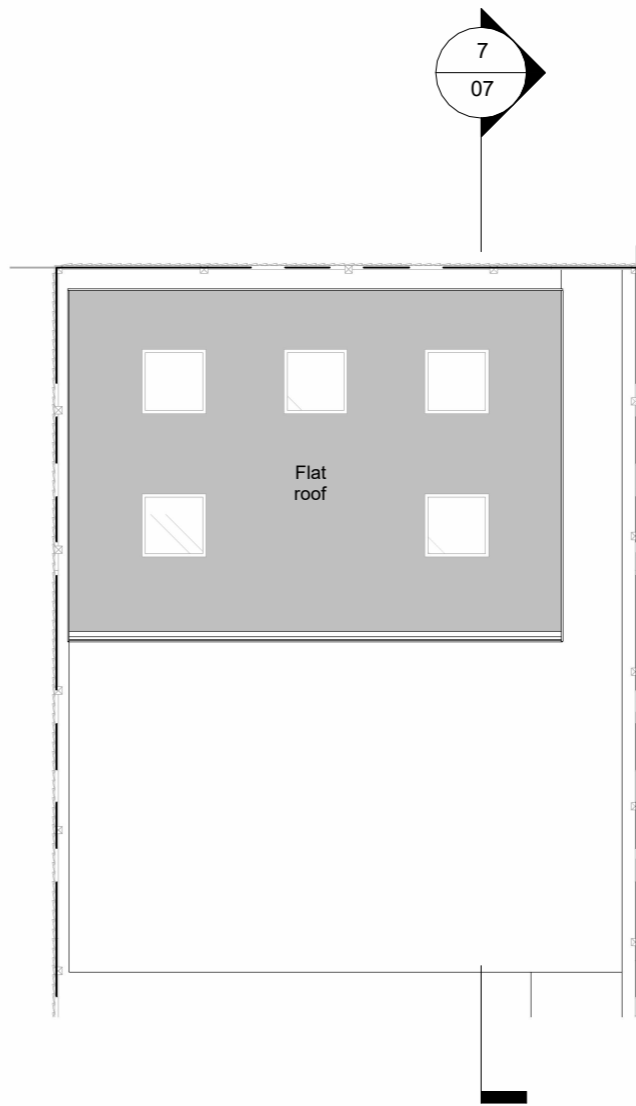

FIRST FLOOR PLAN

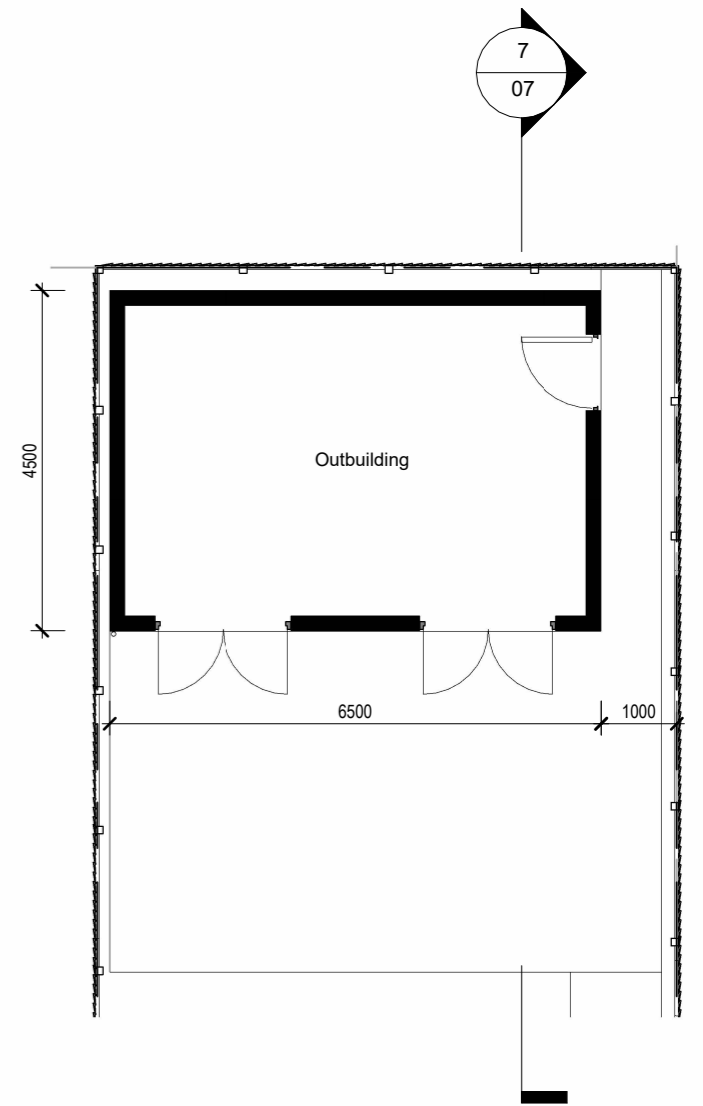

GROUND FLOOR PLAN

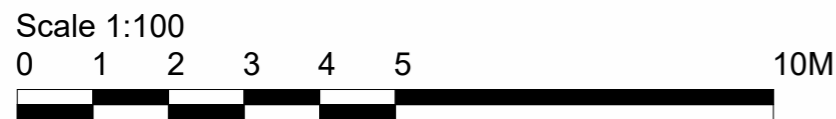

I am registered and regulated by ARB: <http://architects-register.org.uk/architect/079560G>

RUI COSTA, BA Arch  
 architect.costa@gmail.com  
 07926133184



PROJECT	LOFT CONVERSION, REAR DORMER, FRONT ROOFLIGHTS, AND SINGLE STOREY OUTBUILDING	DATE	25/02/2024
PROJECT ADDRESS	36 WILLOW WAY, RADLETT WD7 8DY	PROJECT NUMBER	12/2023
TITLE	AS BUILT OUTBUILDING	SCALE (@ A2)	1 : 100
		DRAWING NUMBER	07
		REV	