



Existing Roof Plan

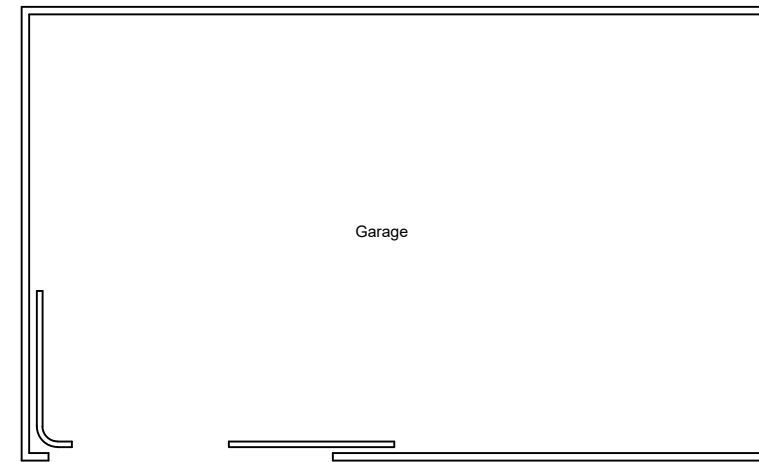


Existing Floor Plan

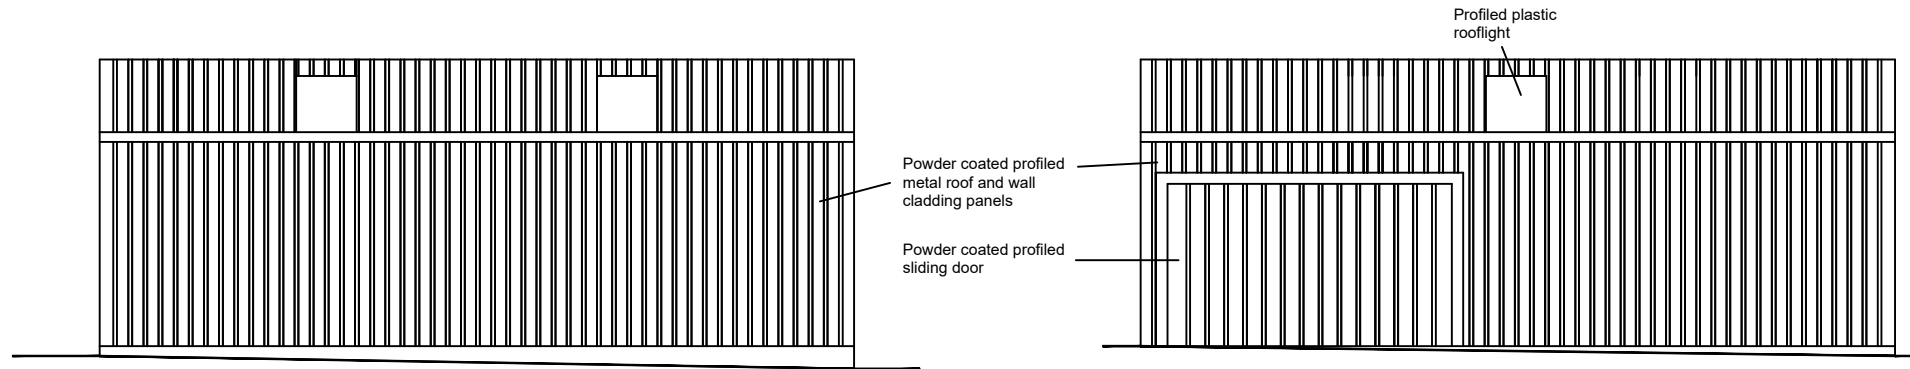


Existing West Elevation


Existing East Elevation

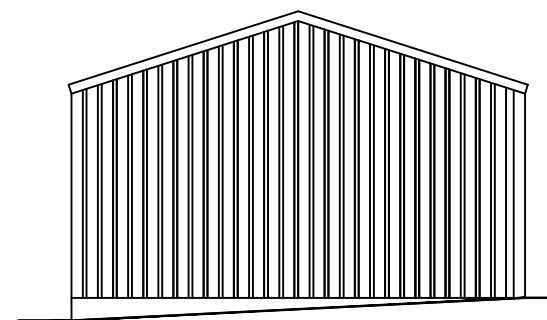

Existing South Elevation

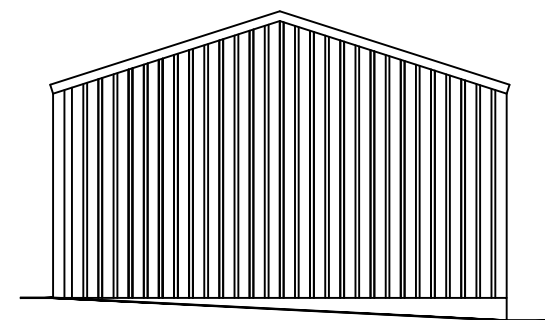

Existing North Elevation

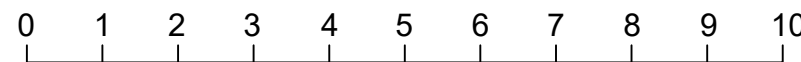

THIS DRAWING IS COPYRIGHT

	Scheme Detached Double Garage 7 Old Priory Barn Plympton PL7 1QS	STATUS		Drawn	NB	Original drawing size	A3
		PURPOSE OF ISSUE		Checked		Date	Feb 2024
	Drawing Title Existing (as built) Plan and Elevations	Preliminary	<input checked="" type="checkbox"/>		Project Number	PSS/7OPB	Scale 1:100
		Report	<input type="checkbox"/>		Drawing Number	03	Revision
		Committee	<input type="checkbox"/>				
		Tender	<input type="checkbox"/>				
		Construction	<input type="checkbox"/>				
		Other (specify)	<input type="checkbox"/>				