
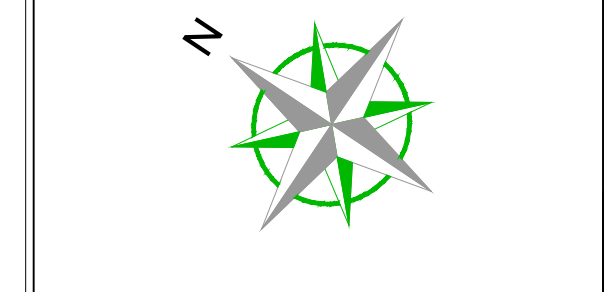


# Second Floor Plan.

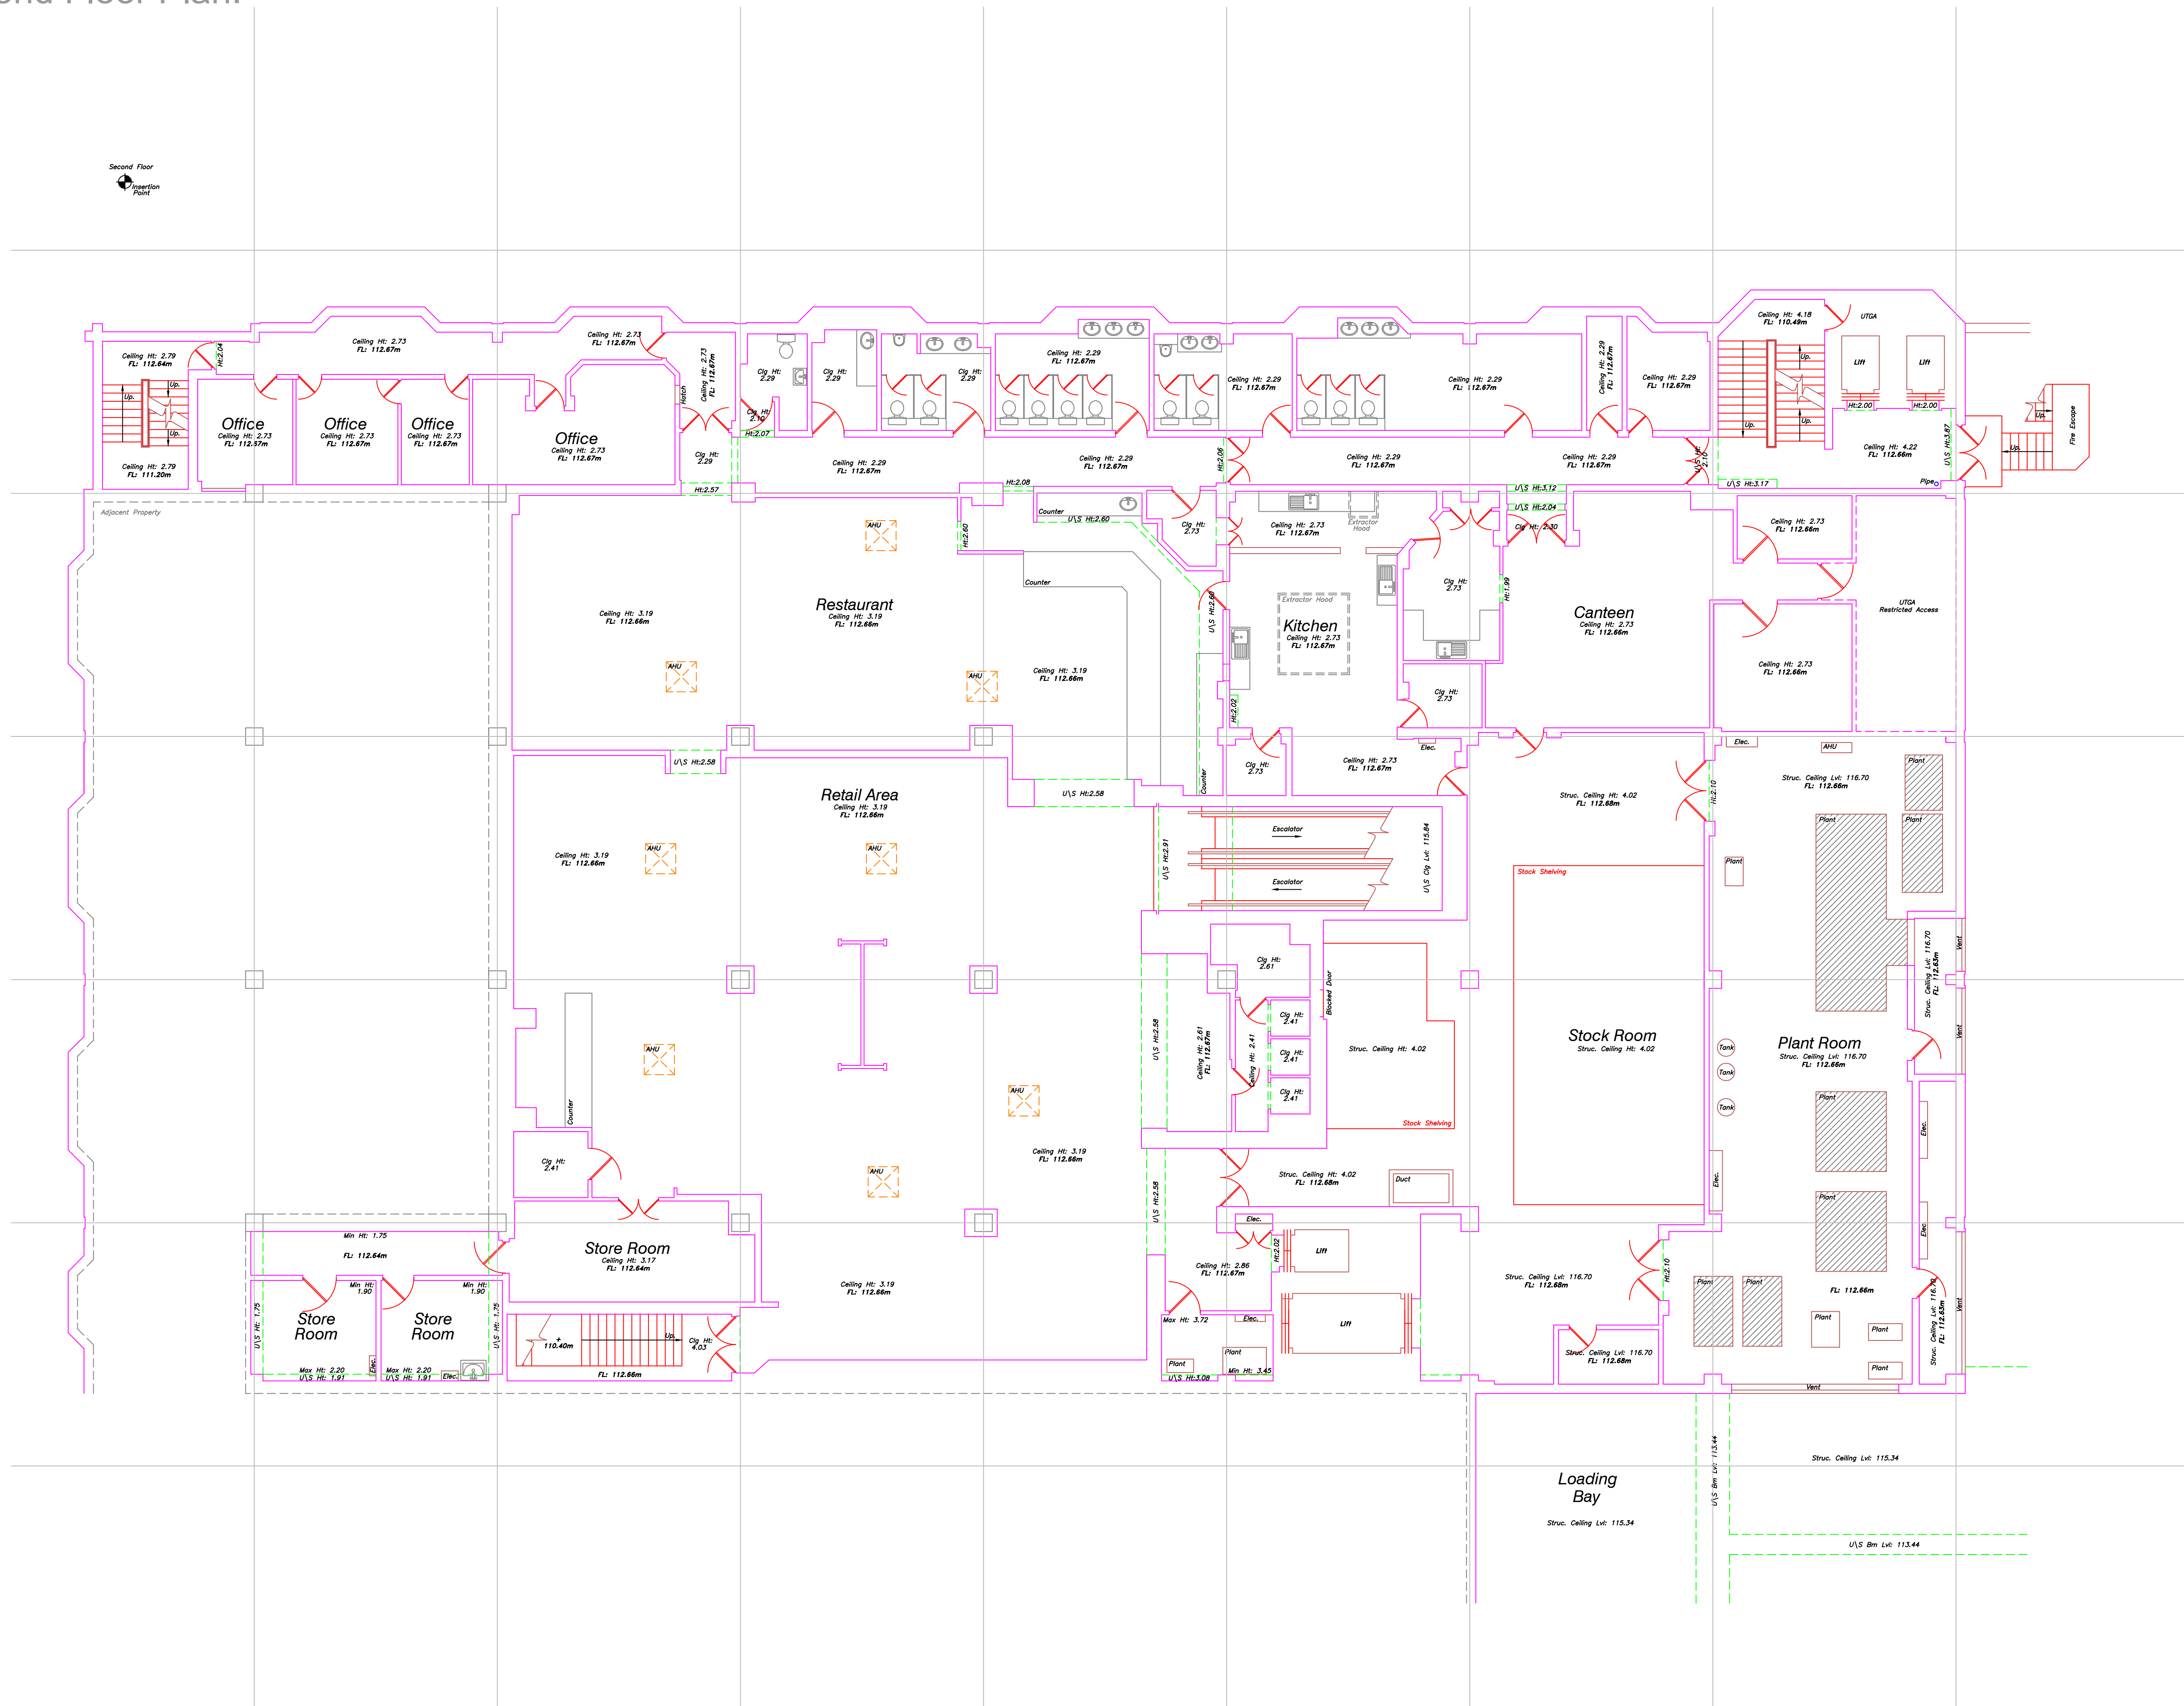

**Station Information:**

Station	Easting (m)	Northing (m)	Level (m)
S1	453663.924	361228.721	108.149
S2	453635.715	361219.099	108.120

**OS Note:**  
 The Ordnance Survey file is to be used as a guide only.  
**OS Buildings**  Surveyed Buildings   
 This survey has been orientated to the Ordnance Survey (O.S.) National Grid OSGB36 (15) via Global Navigational Satellite Systems (GNSS) and the O.S. Active Network (OS Net).  
 A true OSGB36 coordinate has been established near to the site centre via a transformation using the OSTN15GB & OSGM15GB transformation models.  
 The survey has been correlated to this point and a further one or more OSGB36(15) points established to create a true O.S. bearing for angle orientation.  
 No scale factor has been applied to the survey therefore the coordinates shown are arbitrary & not true O.S. Coordinates which have a scale factor applied.  
 Please refer to Survey Station Table to enable establishment of the on-site grid.

**Building Survey Legend:**

SH: 1.00	Sill Height from FFL
MH: 2.12	Head Height from FFL
SL: 51.03m	Sill Level from defined datum
HL: 52.82m	Head Level from defined datum
Susp. Cht: 2.00	Suspended Ceiling Height from FFL
Struct. Cht: 3.00	Structural Ceiling Height from FFL
Susp. Cht: 30.00m	Suspended Ceiling Level from datum
Struct. Cht: 31.00m	Structural Ceiling Level from datum
IFL: 100.00m	Internal Floor Level (General)
+100.00m	Internal Floor Level (Specific)

**Insertion Point**  
 Insertion Point for overlay drawings of other floors or details.

**Topographical Survey Legend:**

Boundary	Channel Centre	FC	Foundation marker	Ball	Ballot
Wall	Coloured edge	HC	Flag post	SB	Barbed wire
Red line	Terrace edge	GC	Gully	SB	Ballot box
Green line	Cliff edge	TC	Telephone post	Yp	Vertical pipe
Black line	Cliff top	DC	Down pipe	GA	Ground light
Blue line	Cliff bottom	PC	Pipe above ground	LH	Ladder
Orange line	Cliff face	MC	Mechanical	LP	Ladder
Yellow line	Cliff top	HC	Head level	SB	Ballot
Green line	Cliff bottom	GC	Gully	SB	Ballot
Blue line	Cliff face	TC	Telephone post	SB	Ballot
Orange line	Cliff top	DC	Down pipe	SB	Ballot
Yellow line	Cliff bottom	PC	Pipe above ground	SB	Ballot
Green line	Cliff face	MC	Mechanical	SB	Ballot

Rev	Date	Description	Drawn	C. Ref

**greenhatch group**

- Topographical Surveys
- Site Engineering
- Utility / CCTV Surveys
- Bathymetric Surveys
- Measured Buildings Surveys
- 3D Laser Scanning
- 3D Revit & BIM Models
- Area, Lease & Fire Plans

**Rowan House**  
 Duffield Road  
 Little Eaton  
 Derby  
 DE21 5DR

Tel: (01332) 830044 Fax: (01332) 830055  
 admin@greenhatch-group.co.uk  
 www.greenhatch-group.co.uk

CLIENT  
**Jones Lang LaSalle**

PROJECT  
**Former Debenhams, Four Seasons Shopping Ctr Mansfield, NG18 1SU.**

TITLE  
**Existing Survey. Second Floor Plan.**

SCALE	DATE
<b>A1@ 1: 100</b>	<b>03.11.21</b>
DRAWN	QUALITY REF
<b>LA</b>	<b>GH12031</b>

Level datum	GPS
Grid orientation	GPS
Job number	41875

Drawing No.	Rev.
<b>41875_03_P</b>	<b>0</b>

Comments  
 This plan should only be used for its original purpose. Greenhatch Group accepts no responsibility for this plan if supplied to any party other than the original client.  
 All dimensions should be checked on site prior to design and construction.  
 Some services may have been omitted due to parked vehicles.  
 Drainage information (where applicable) has been visually inspected from the surface and therefore should be treated as approximate only.  
 Notes: