

Brick Chimney

23° Roof Pitch

Outline of Previously Approved Application PA/10923

Conservation Rooflights

Natural Slate Roof

Vertical Timber Cladding

Timber Double Glazed Windows and doors

Metal Guarding

Treated Timber Balcony

Aluminium Bi-Fold Doors

White Render


Natural Granite walls

Red Lines Indicate Existing Apertures

1 Elevation 1 - South Elevation 1 : 100

2 Elevation 2 - West Elevation 1:100



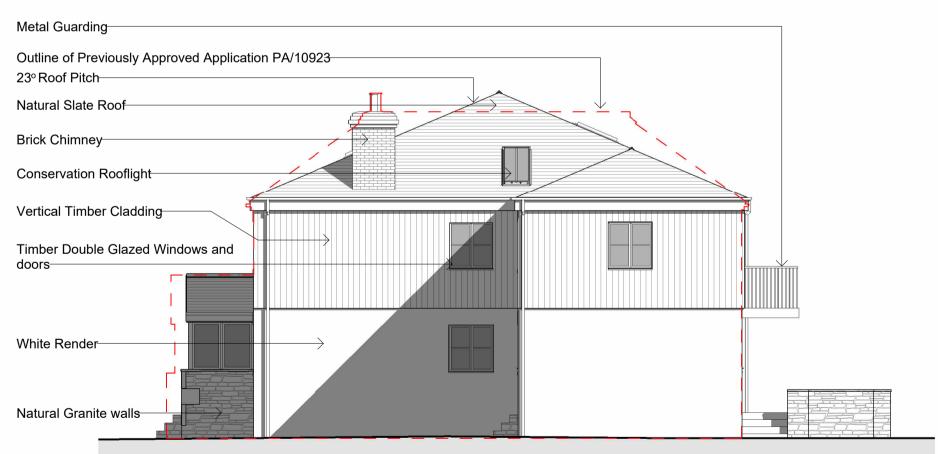

Blevation 3 - North Elevation
1:100

Elevation 4 - East Elevation
1:100



 This drawing is the copyright of Cornwall Planning Group and may not be reproduced without licence.
 The Contractor shall not scale off this drawing for construction purposes, only figured dimensions shall be worked from.

3. All dimensions and levels are to be checked on site by the Contractor before the commencement of any work and any discrepancies reported to the Architect.
4. No responsibility can be accepted for errors arising on site due to unauthorised variations from the Architects drawings.
5. The Contractor is recommended to visit the site

before tendering to ascertain all local conditions and restrictions likely to affect the works. No claims arising from failure to do so will be considered.


6. Tenders must include for all the works described or being apparent on the drawings or can reasonably inferred as being necessary for the proper execution of the works.

7. This drawing is for town planning and building regulations only and is not a complete working

8. Depth, size and design of foundations shown are preliminary only, actual foundation, depth, size and design may differ depending on site conditions.

9. On completion of the works, if a National Home Energy Rating Certificate is required by the client, contact the Local Authority Building Control Department.

10.L1 and L2 requirements for limiting thermal bridging & air leakage workmanship shall be executed by the Contractor in accordance with the appropriate sections and DEFRE/DTLR guidance document "Limiting Thermal Bridging & Air Leakage: Robust Construction Details for Dwellings and Similar Buildings" available from The Stationery Office Ltd.

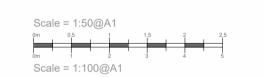

Cornwall Planning Group
Head Office: Chi Gallos,
Hayle Marine Renewables Business Park,
North Quay, Hayle,
Cornwall, TR27 4DD
Phone: +44 (0)1736 448 500
Email: office@cornwallplanninggroup.co.uk

Web: www.cornwallplanninggroup.co.uk

Client: Mr W lliffe

Project: Variation of Planning Condition Section 73,
Building Regulations, Retention and
completion of replacement dwelling
(amended design following approval
PA12/10523) | at Riverside Bungalow,
Noonvares Lane, Townshend, TR27 6AS

Title: Proposed Elevations

Stage: Pre-App

Scale: 1: 100

Date: 31/08/23

Draw: EB Checked: CM

Project No. 2468 Drawing: 004A Rev.