


EXISTING GROUND FLOOR



AS-BUILT GROUND FLOOR

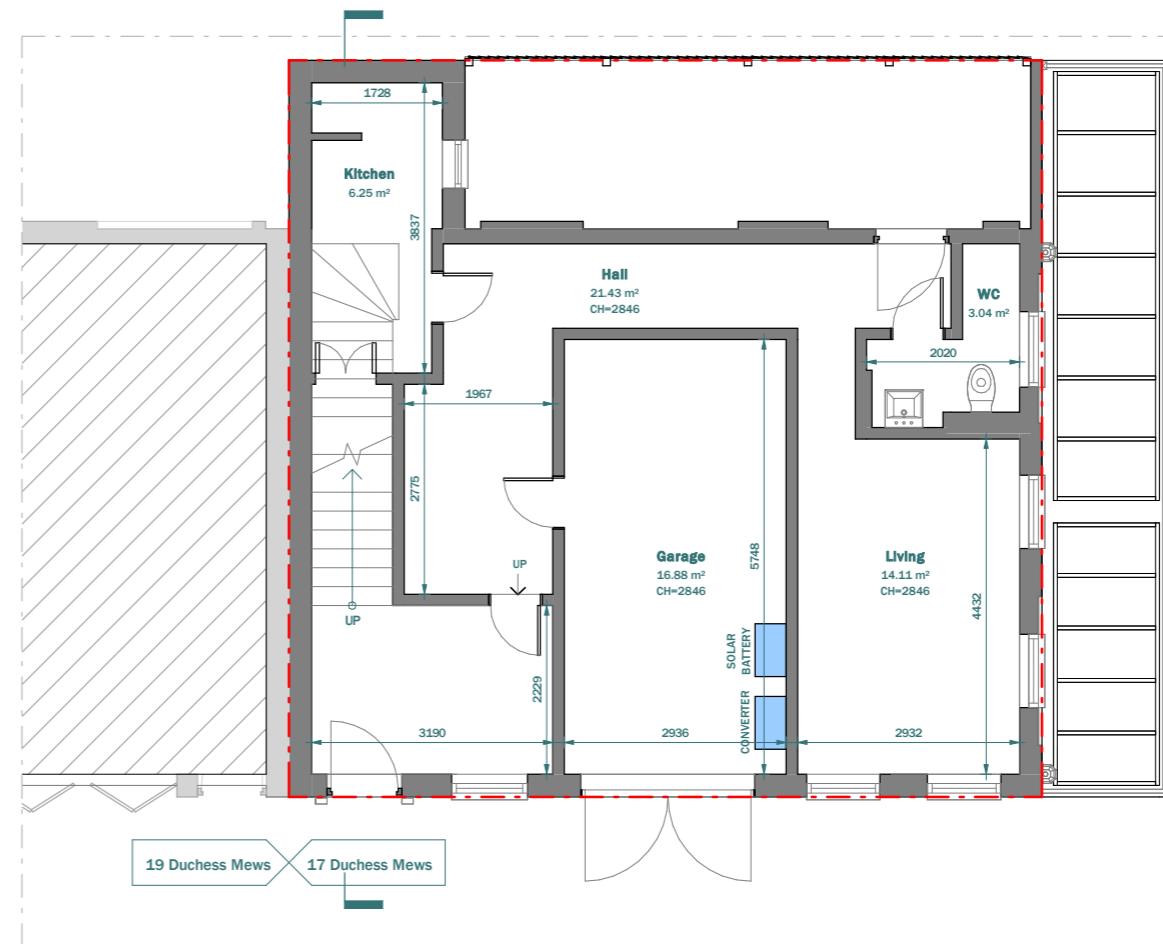

PHOTOGRAPH OF INSTALLED SOLAR BATTERY AND CONVERTER IN GROUND FLOOR GARAGE SPACE



LEGEND:

- EXISTING WALL
- PROPOSED WALL
- DEMOLISHED LINE
- INVISIBLE LINE


Scale 1:100
@A3



CLIENT Duncan Brown	NOTES			SCALE 1 : 100	DATE 22.09.2023
PROJECT 17 Duchess Mews, London W1G 9DU	VERSION	DESCRIPTION	DATE	DRAWN ZG	VERSION
TITLE Existing & As-Built Ground Floor				SHEET REF. NO 17DM -PL -01	

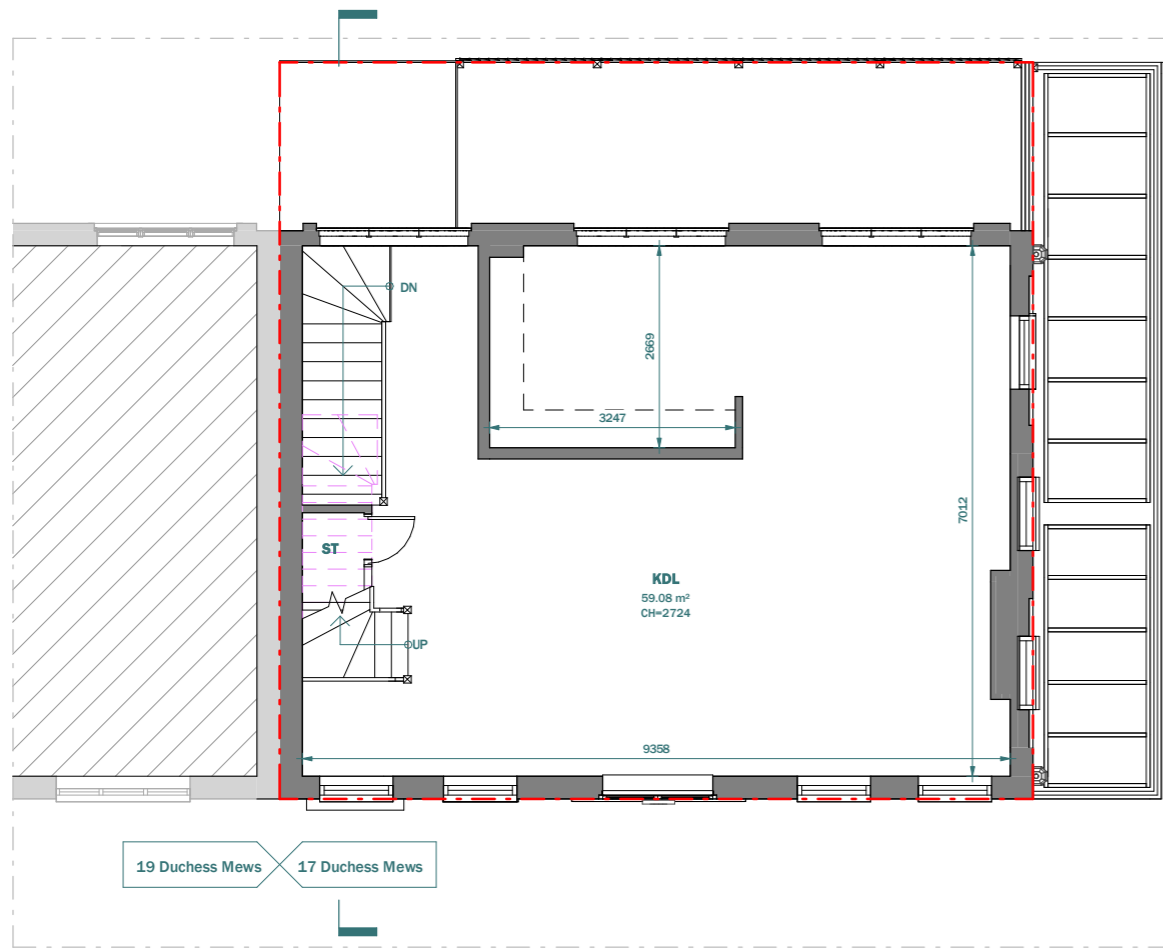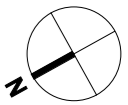

EXISTING FIRST FLOOR

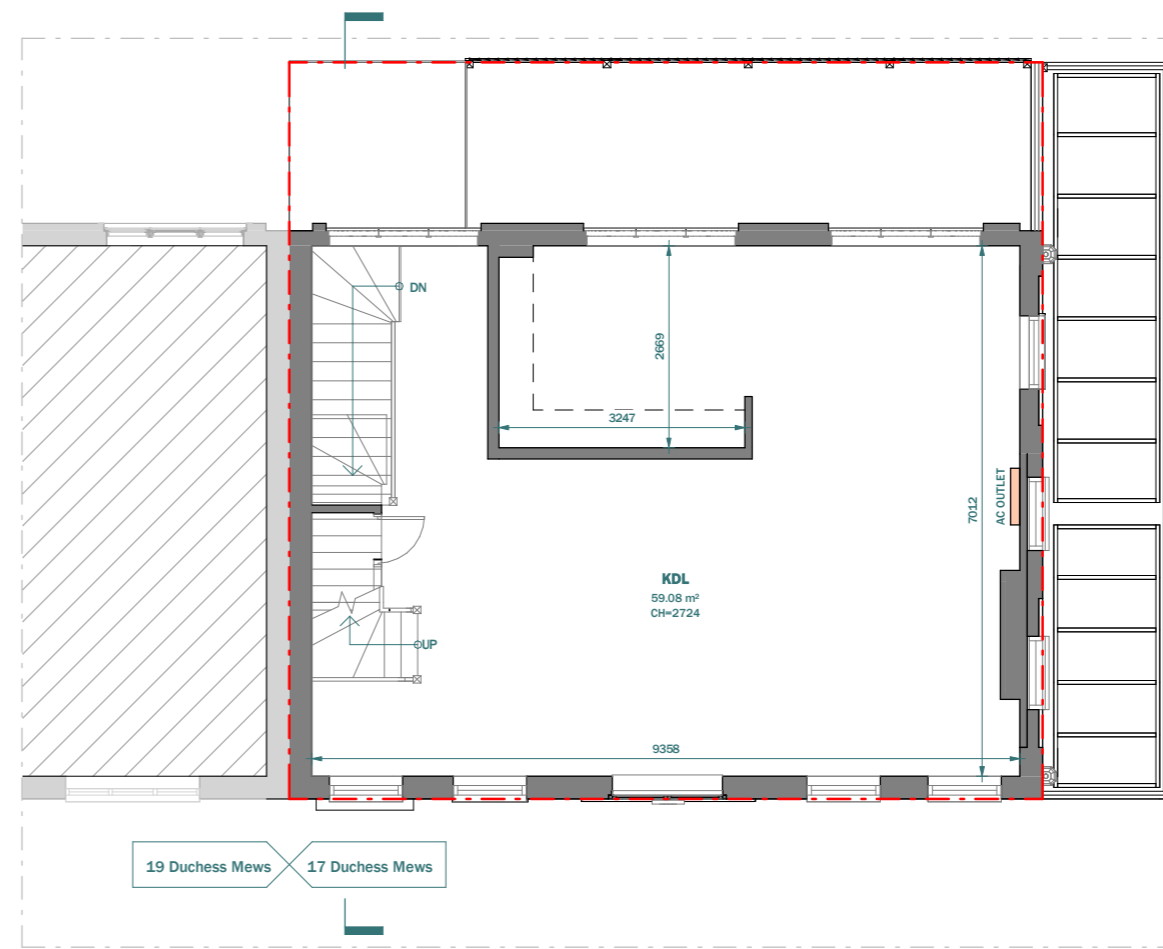

AS-BUILT FIRST FLOOR

LEGEND:

- EXISTING WALL
- PROPOSED WALL
- DEMOLISHED LINE
- INVISIBLE LINE



3 River Reach, Gartons Way,
Battersea
London SW11 3SX
Tel (0208) 288 8950 Fax (0871) 918 2798
www.extensionarchitecture.co.uk

This drawing is prepared solely for design and planning submission purposes. It is not intended or suitable for either building regulations or construction purposes and should not be used for such. All dimension shall be check and confirmed with site rep. and any discrepancies between the drawings and site shall be reported to PM. This drawing to be read in conjunction with engineers specification and details. For construction information please refer to all drawings and specification of works.



For any structural steelworks details please refer to structural engineer's drawings & calculations.

The copyright of the drawing and designs remains with Extension Architecture. All copies are only for information about the application, they may not be used for any other purpose without the express written permission of Extension Architecture.


Scale 1:100
@A3



CLIENT Duncan Brown	NOTES			SCALE 1 : 100	DATE 22.09.2023
PROJECT 17 Duchess Mews, London W1G 9DU	VERSION	DESCRIPTION	DATE	DRAWN ZG	VERSION
TITLE Existing & As-Built First Floor				SHEET REF. NO 17DM -PL -02	

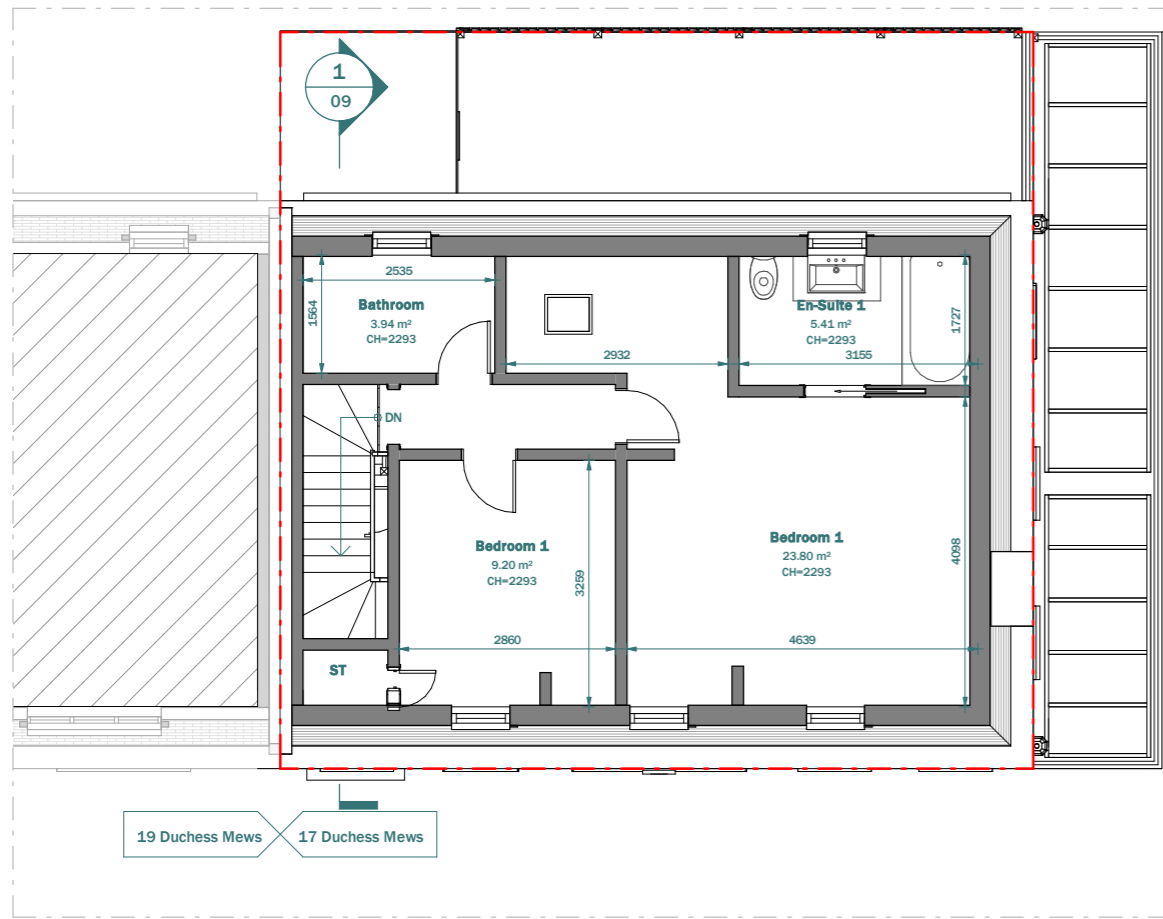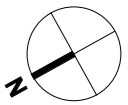

EXISTING SECOND FLOOR

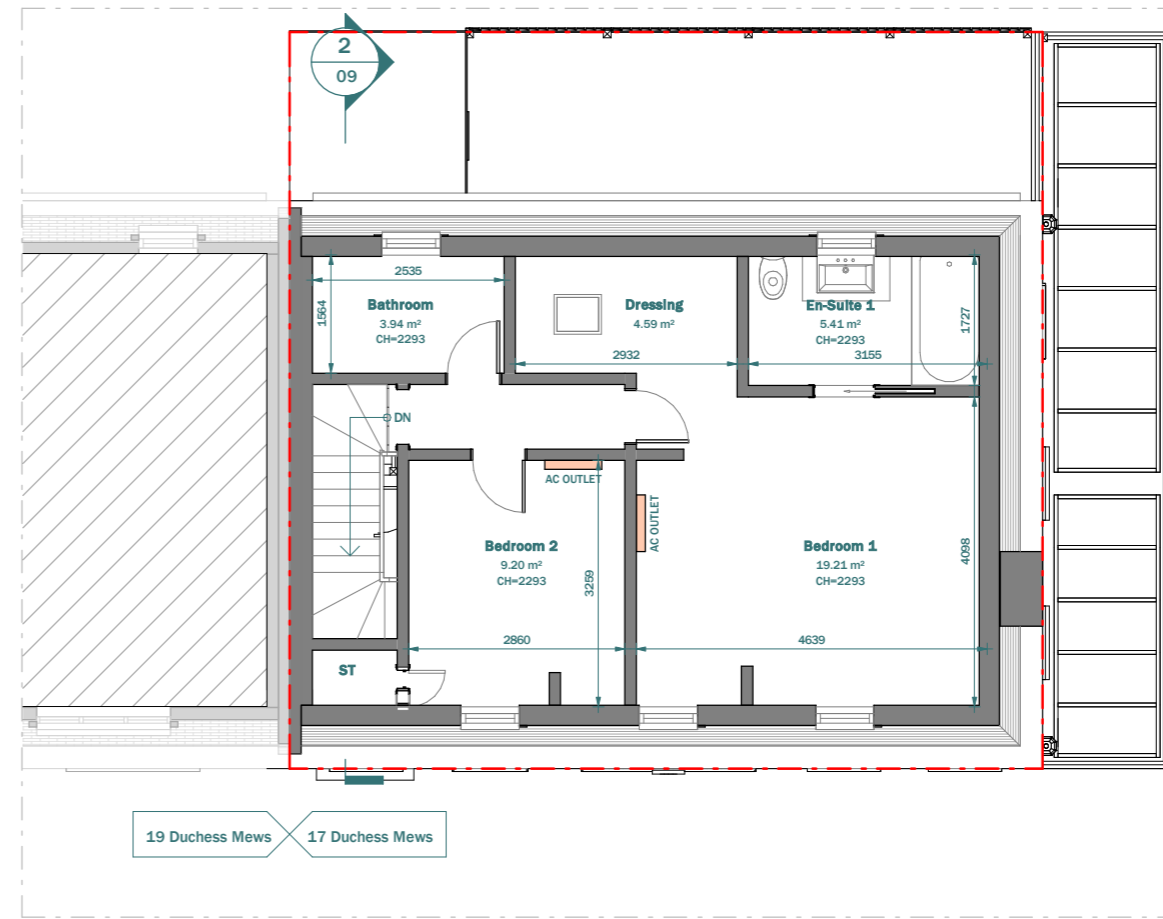

AS-BUILT SECOND FLOOR

LEGEND:

- EXISTING WALL
- PROPOSED WALL
- DEMOLISHED LINE
- INVISIBLE LINE

Scale 1:100
@A3





3 River Reach, Gartons Way,
Battersea
London SW11 3SX
Tel (0208) 288 8950 Fax (0871) 918 2798
www.extensionarchitecture.co.uk

This drawing is prepared solely for design and planning submission purposes. It is not intended or suitable for either building regulations or construction purposes and should not be used for such. All dimension shall be check and confirmed with site rep. and any discrepancies between the drawings and site shall be reported to PM. This drawing to be read in conjunction with engineers specification and details. For construction information please refer to all drawings and specification of works.


For any structural steelworks details please refer to structural engineer's drawings & calculations.

The copyright of the drawing and designs remains with Extension Architecture. All copies are only for information about the application, they may not be used for any other purpose without the express written permission of Extension Architecture.

CLIENT Duncan Brown	NOTES			SCALE 1 : 100	DATE 22.09.2023
PROJECT 17 Duchess Mews, London W1G 9DU	VERSION	DESCRIPTION	DATE	DRAWN ZG	VERSION
TITLE Existing & As-Built Loft Floor				SHEET REF. NO 17DM -PL -03	

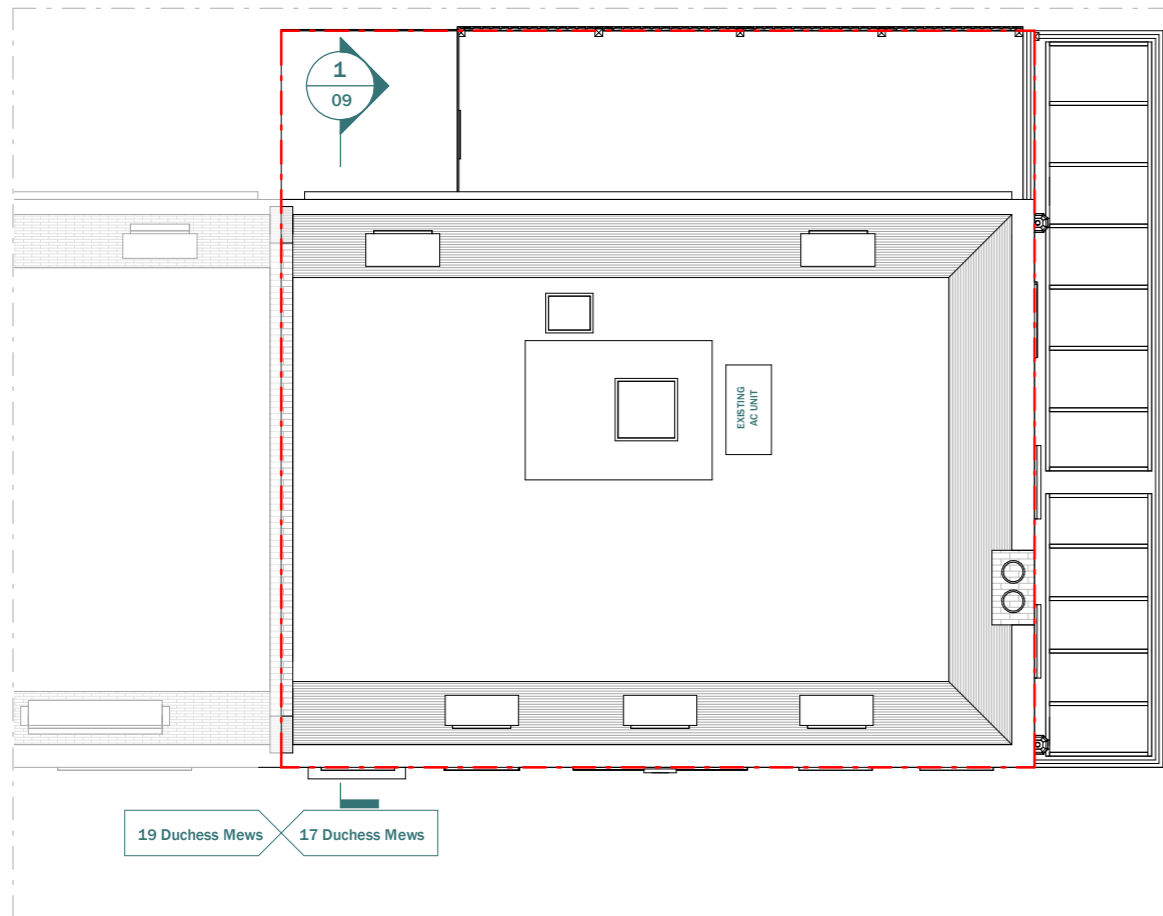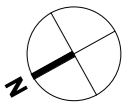

EXISTING ROOF FLOOR

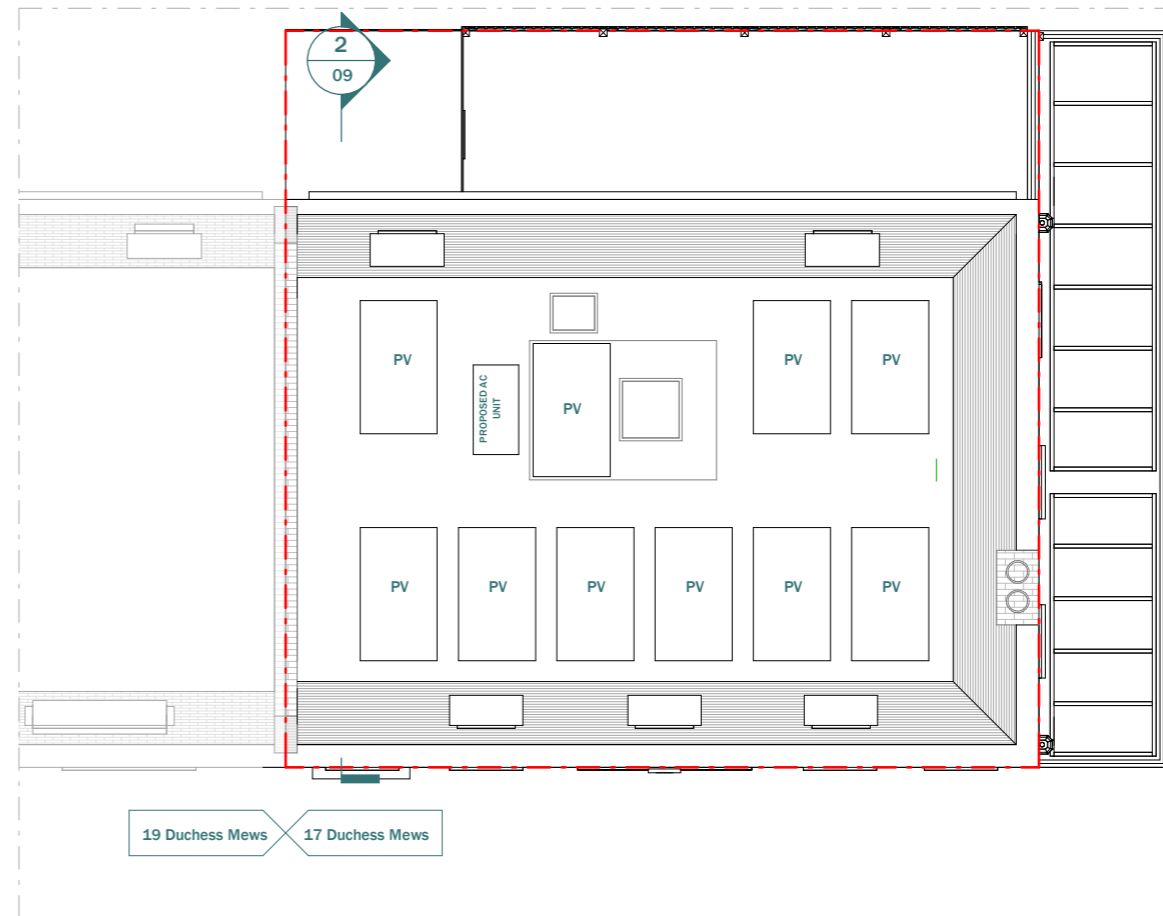

AS-BUILT ROOF FLOOR




PHOTOGRAPH OF INSTALLED PV UNITS & AIR CONDITIONING UNIT ON FLAT ROOF

CLIENT	Duncan Brown		
PROJECT	17 Duchess Mews, London W1G 9DU		
TITLE	Existing & As-Built Roof Plan		

NOTES		
VERSION	DESCRIPTION	DATE

SCALE	DATE
1 : 100	22.09.2023
DRAWN	VERSION
ZG	
SHEET REF. NO	
17DM -PL -04	



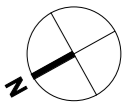

EXISTING FRONT ELEVATION





PROPOSED AS-BUILT ELEVATION

Scale 1:100
@A3



CLIENT Duncan Brown	NOTES			SCALE 1 : 100	DATE 22.09.2023
PROJECT 17 Duchess Mews, London W1G 9DU	VERSION	DESCRIPTION	DATE	DRAWN ZG	VERSION
TITLE Existing & As-Built Front Elevation				SHEET REF. NO 17DM -PL -05	

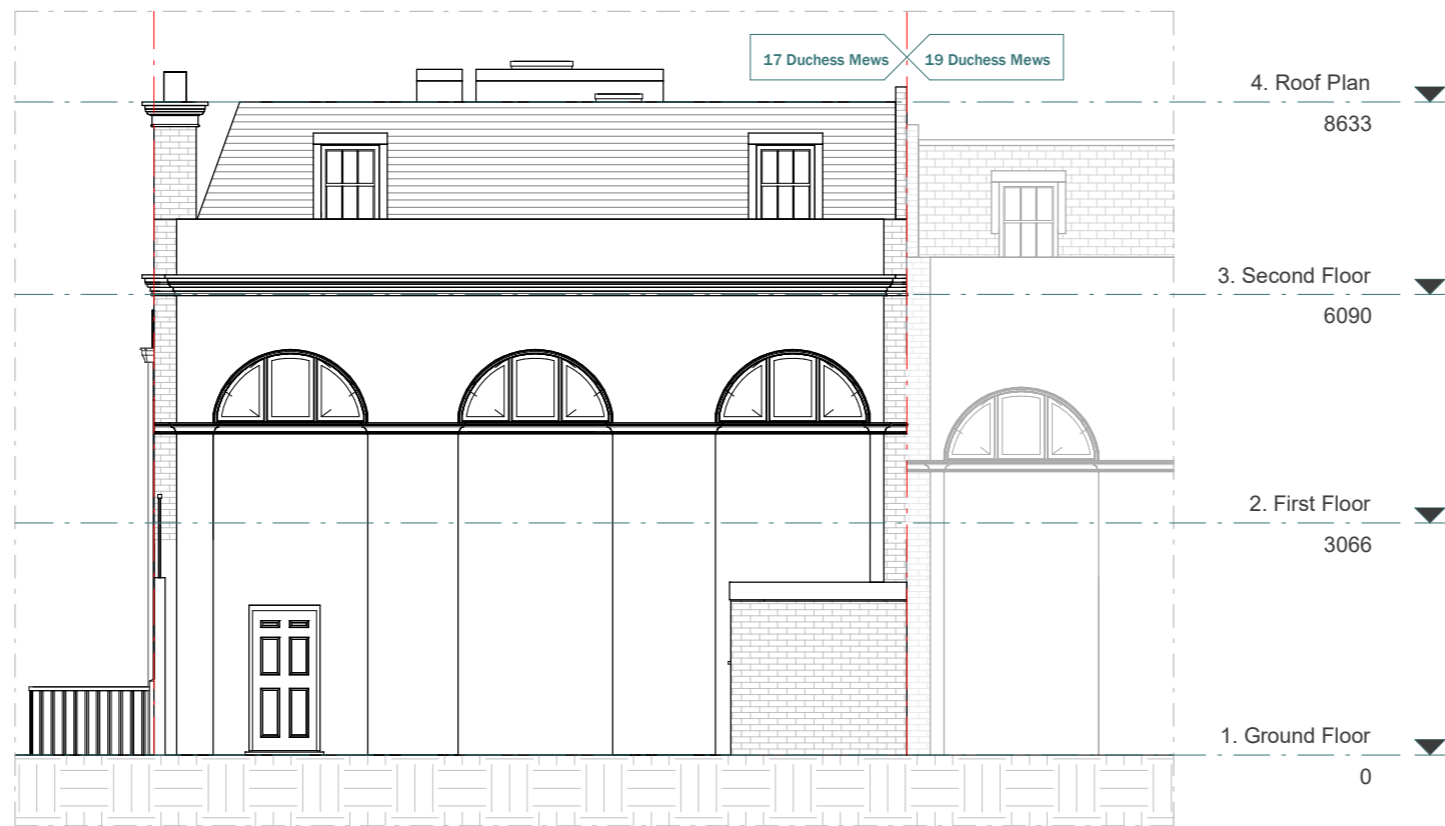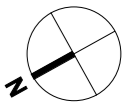

EXISTING REAR ELEVATION





AS-BUILT REAR ELEVATION


Scale 1:100
@A3



CLIENT Duncan Brown	NOTES			SCALE 1 : 100	DATE 22.09.2023
PROJECT 17 Duchess Mews, London W1G 9DU	VERSION	DESCRIPTION	DATE	DRAWN ZG	VERSION
TITLE Existing & As-Built Rear Elevation				SHEET REF. NO 17DM -PL -06	

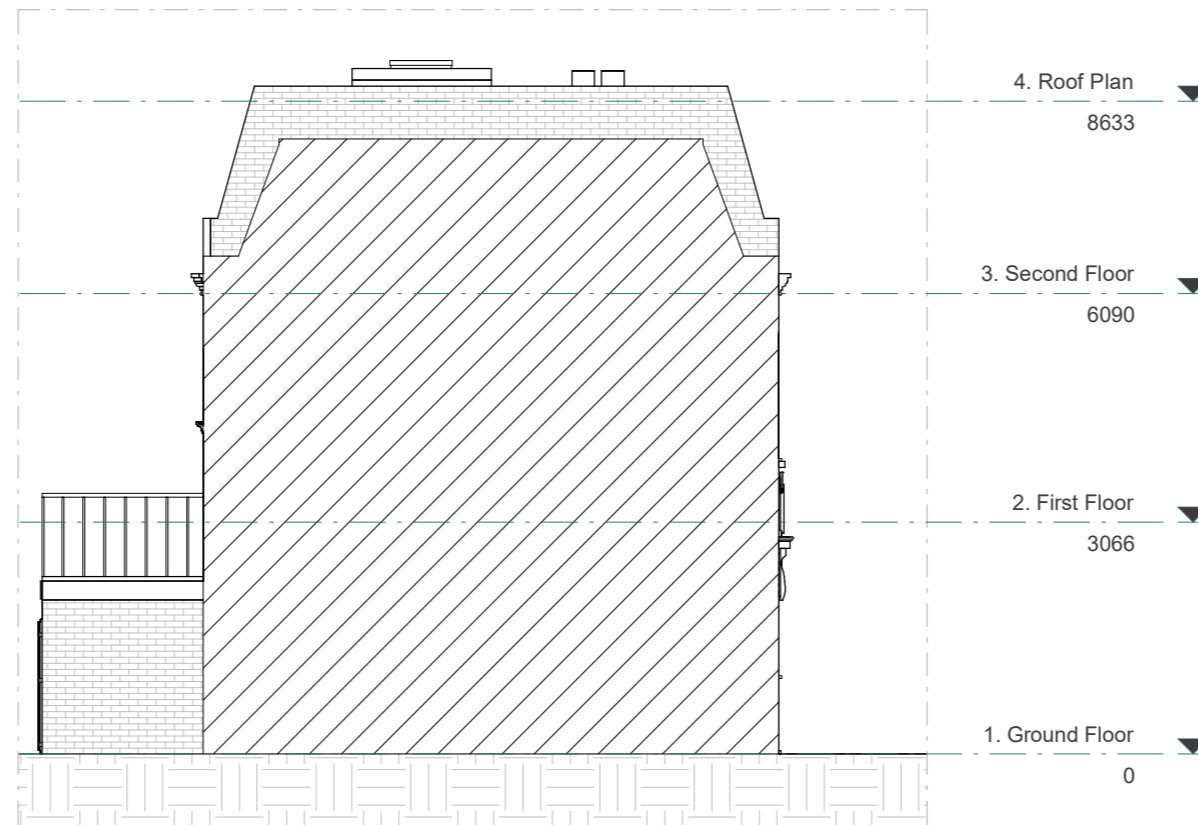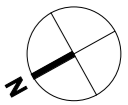

EXISTING LEFT ELEVATION


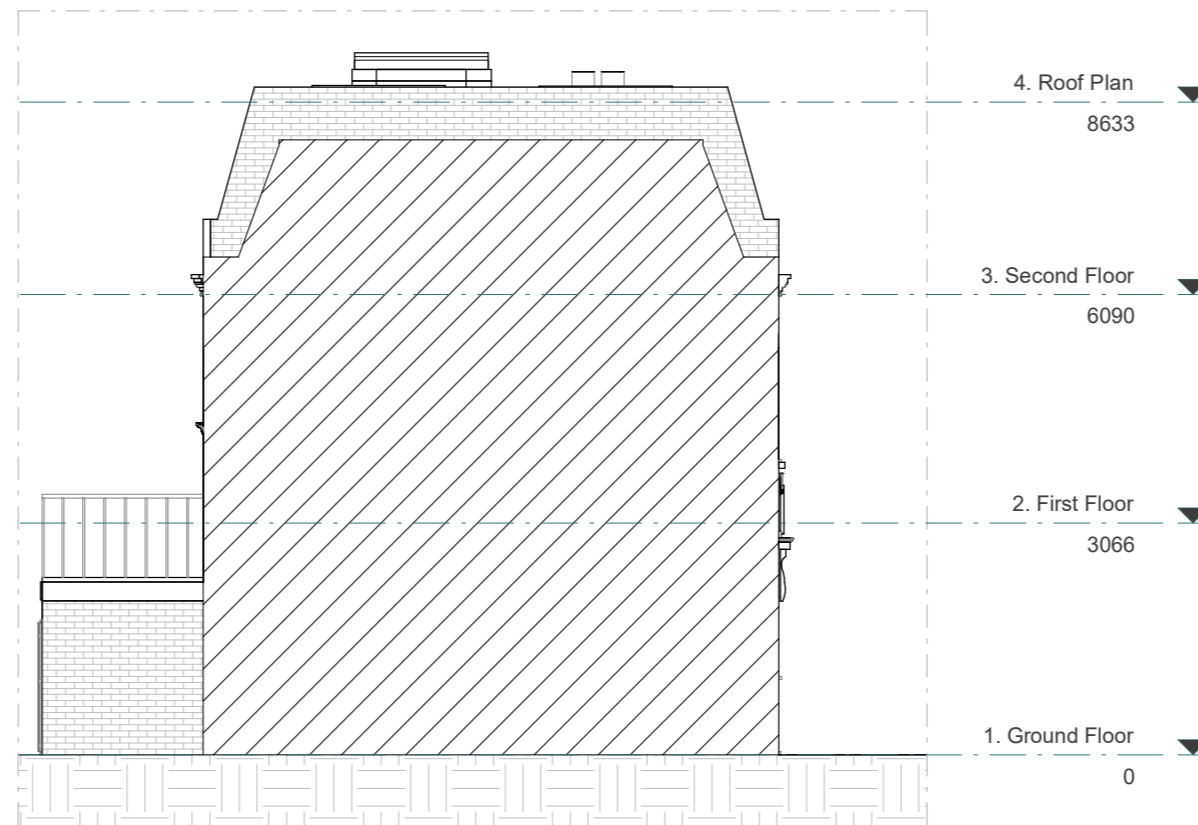


AS-BUILT LEFT ELEVATION


Scale 1:100
@A3



CLIENT Duncan Brown	NOTES			SCALE 1 : 100	DATE 22.09.2023
	PROJECT 17 Duchess Mews, London W1G 9DU	VERSION	DESCRIPTION	DATE	DRAWN ZG
TITLE Existing & As-Built Left Elevation					SHEET REF. NO 17DM -PL -07

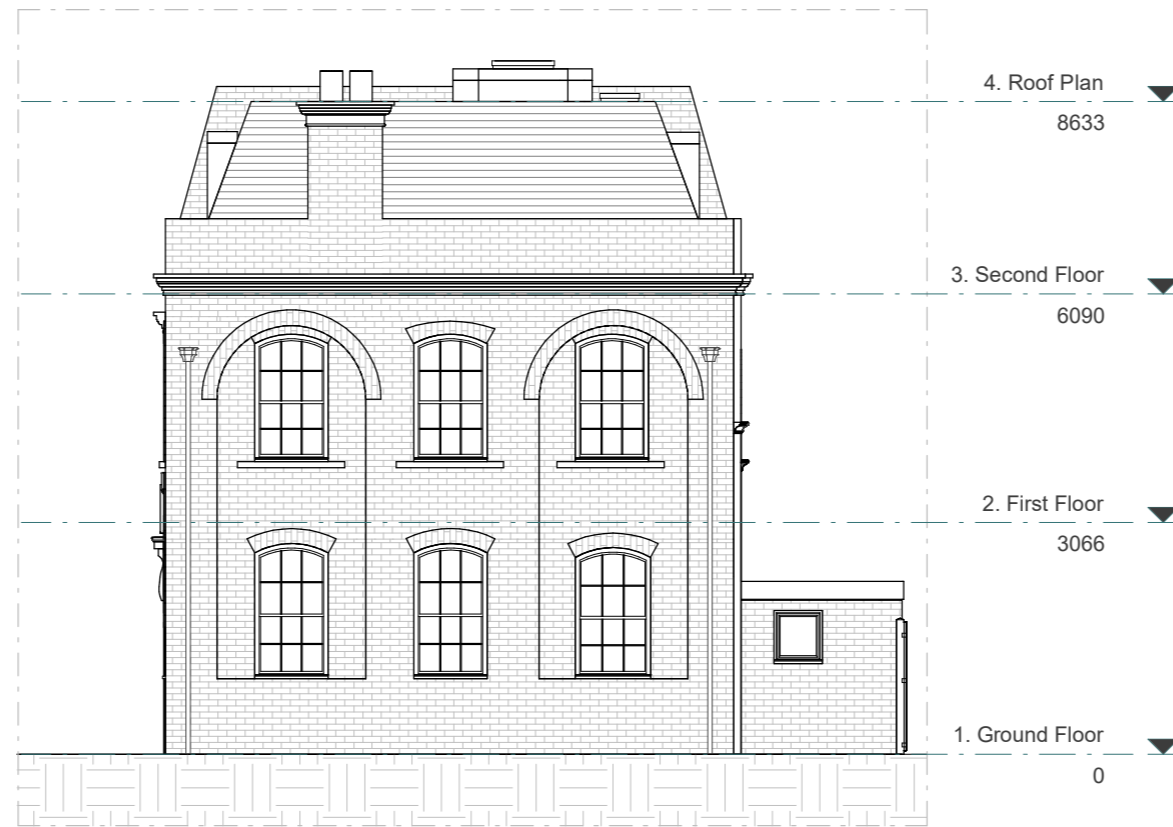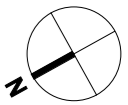

EXISTING RIGHT ELEVATION

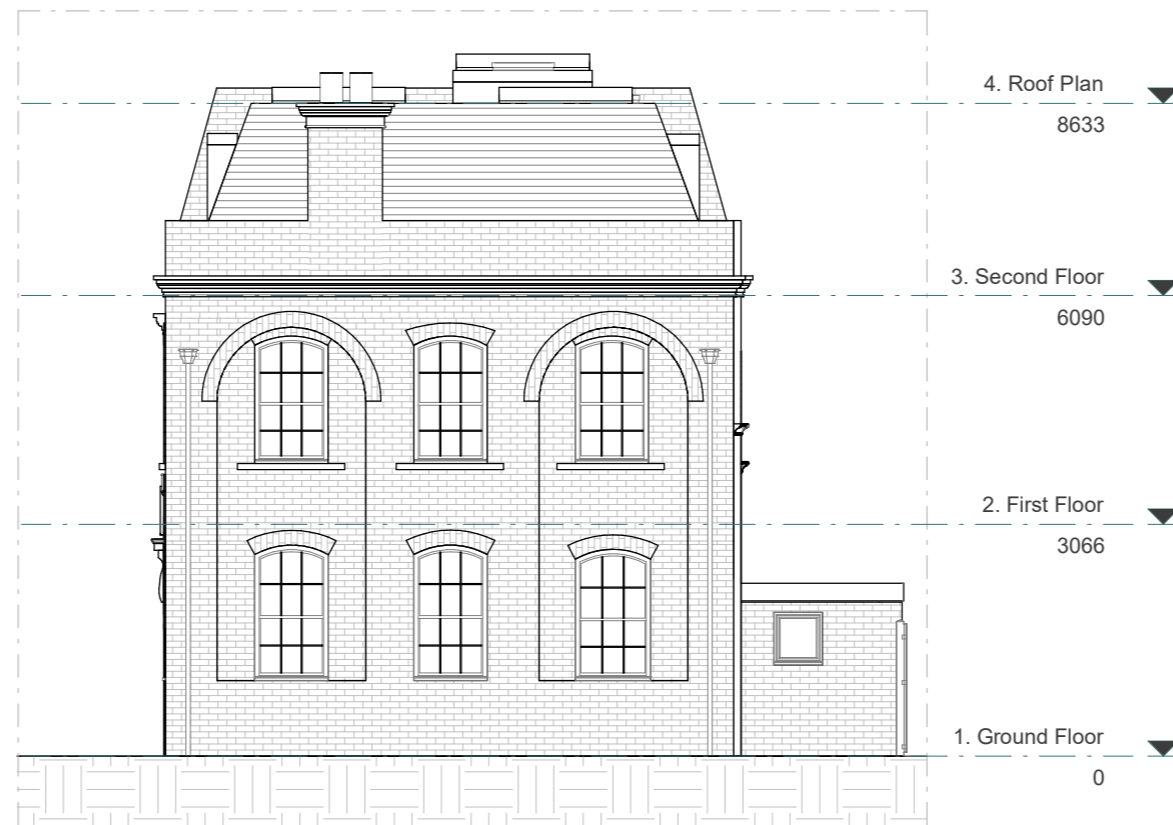

AS-BUILT RIGHT ELEVATION

Scale 1:100
@A3





3 River Reach, Gartons Way,
Battersea
London SW11 3SX
Tel (0208) 288 8950 Fax (0871) 918 2798
www.extensionarchitecture.co.uk

This drawing is prepared solely for design and planning submission purposes. It is not intended or suitable for either building regulations or construction purposes and should not be used for such. All dimension shall be check and confirmed with site rep. and any discrepancies between the drawings and site shall be reported to PM. This drawing to be read in conjunction with engineers specification and details. For construction information please refer to all drawings and specification of works.


For any structural steelworks details please refer to structural engineer's drawings & calculations.

The copyright of the drawing and designs remains with Extension Architecture. All copies are only for information about the application, they may not be used for any other purpose without the express written permission of Extension Architecture.

CLIENT Duncan Brown	NOTES			SCALE 1 : 100	DATE 22.09.2023
PROJECT 17 Duchess Mews, London W1G 9DU	VERSION	DESCRIPTION	DATE	DRAWN ZG	VERSION
TITLE Existing & As-Built Right Elevation				SHEET REF. NO 17DM -PL -08	

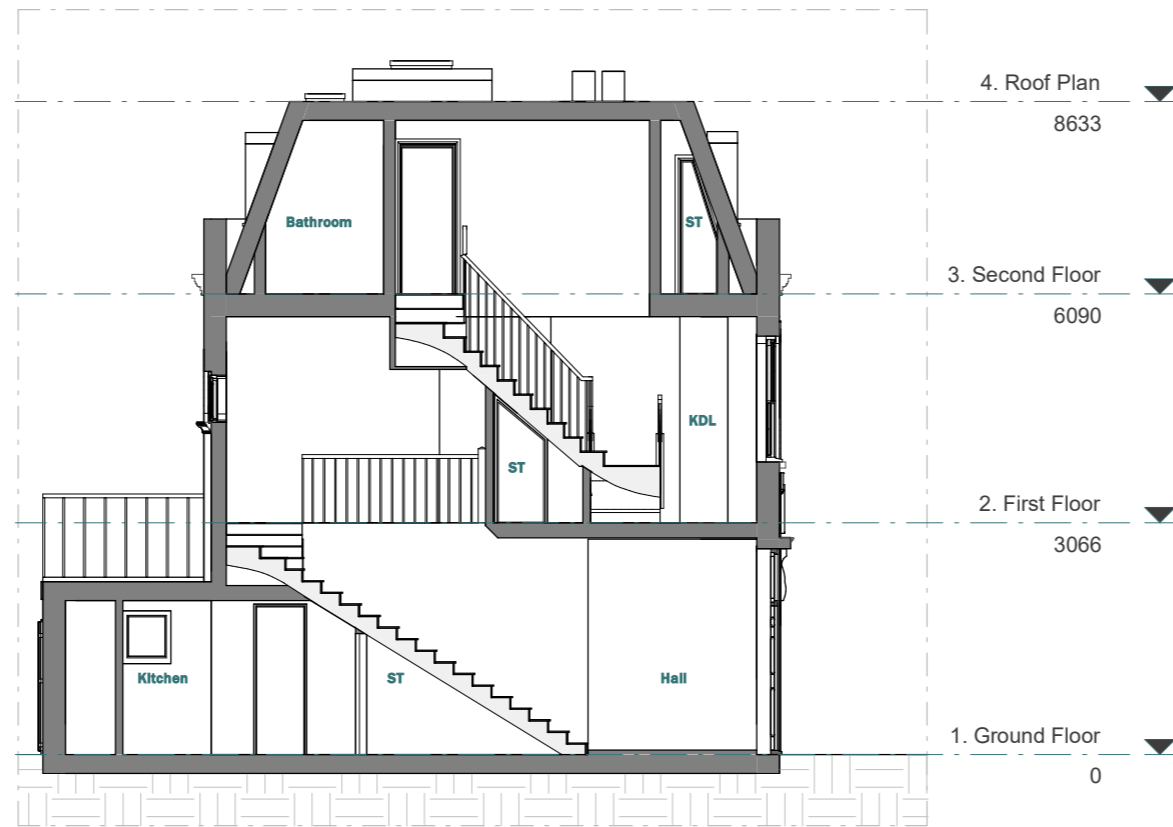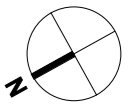

EXISTING SECTION A - A

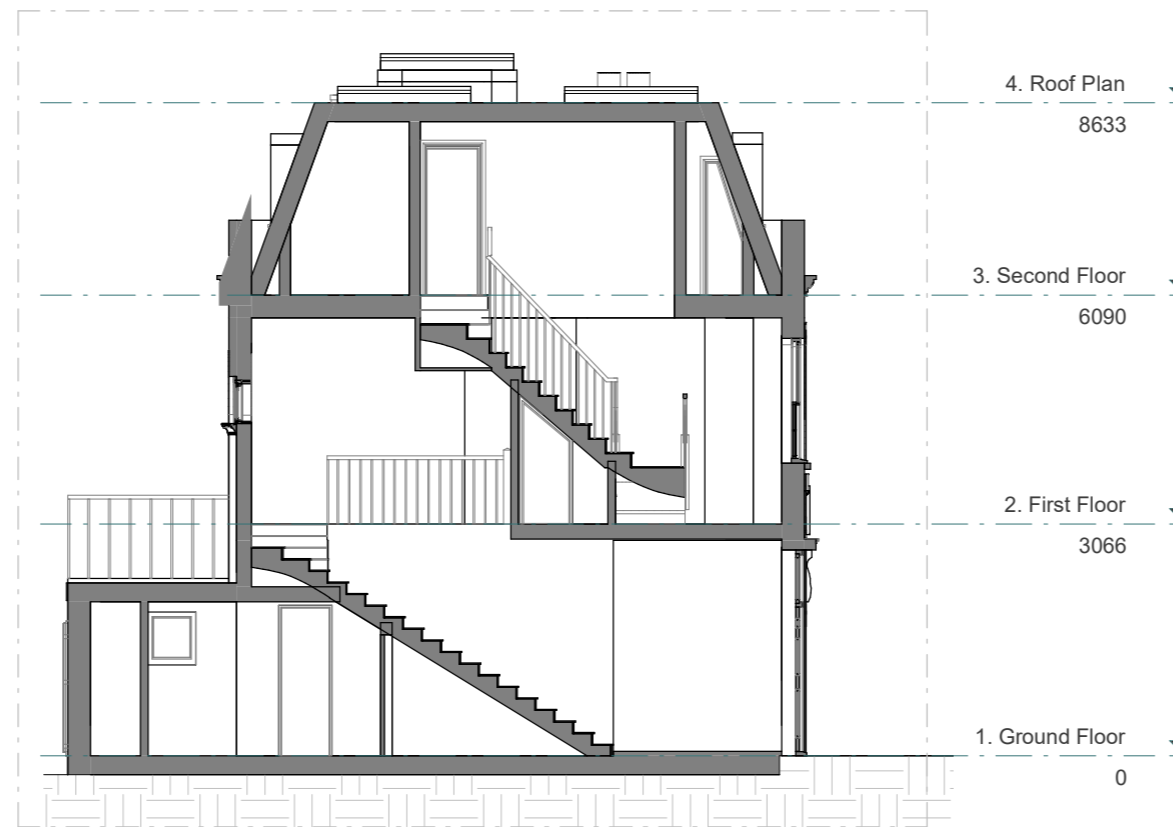

AS-BUILT SECTION A - A



LEGEND:

- EXISTING WALL
- PROPOSED WALL
- DEMOLISHED LINE
- INVISIBLE LINE

Scale 1:100
@A3



CLIENT Duncan Brown	NOTES			SCALE 1 : 100	DATE 22.09.2023
PROJECT 17 Duchess Mews, London W1G 9DU	VERSION	DESCRIPTION	DATE	DRAWN ZG	VERSION
TITLE Existing & As-Built Section A-A				SHEET REF. NO 17DM -PL -09	

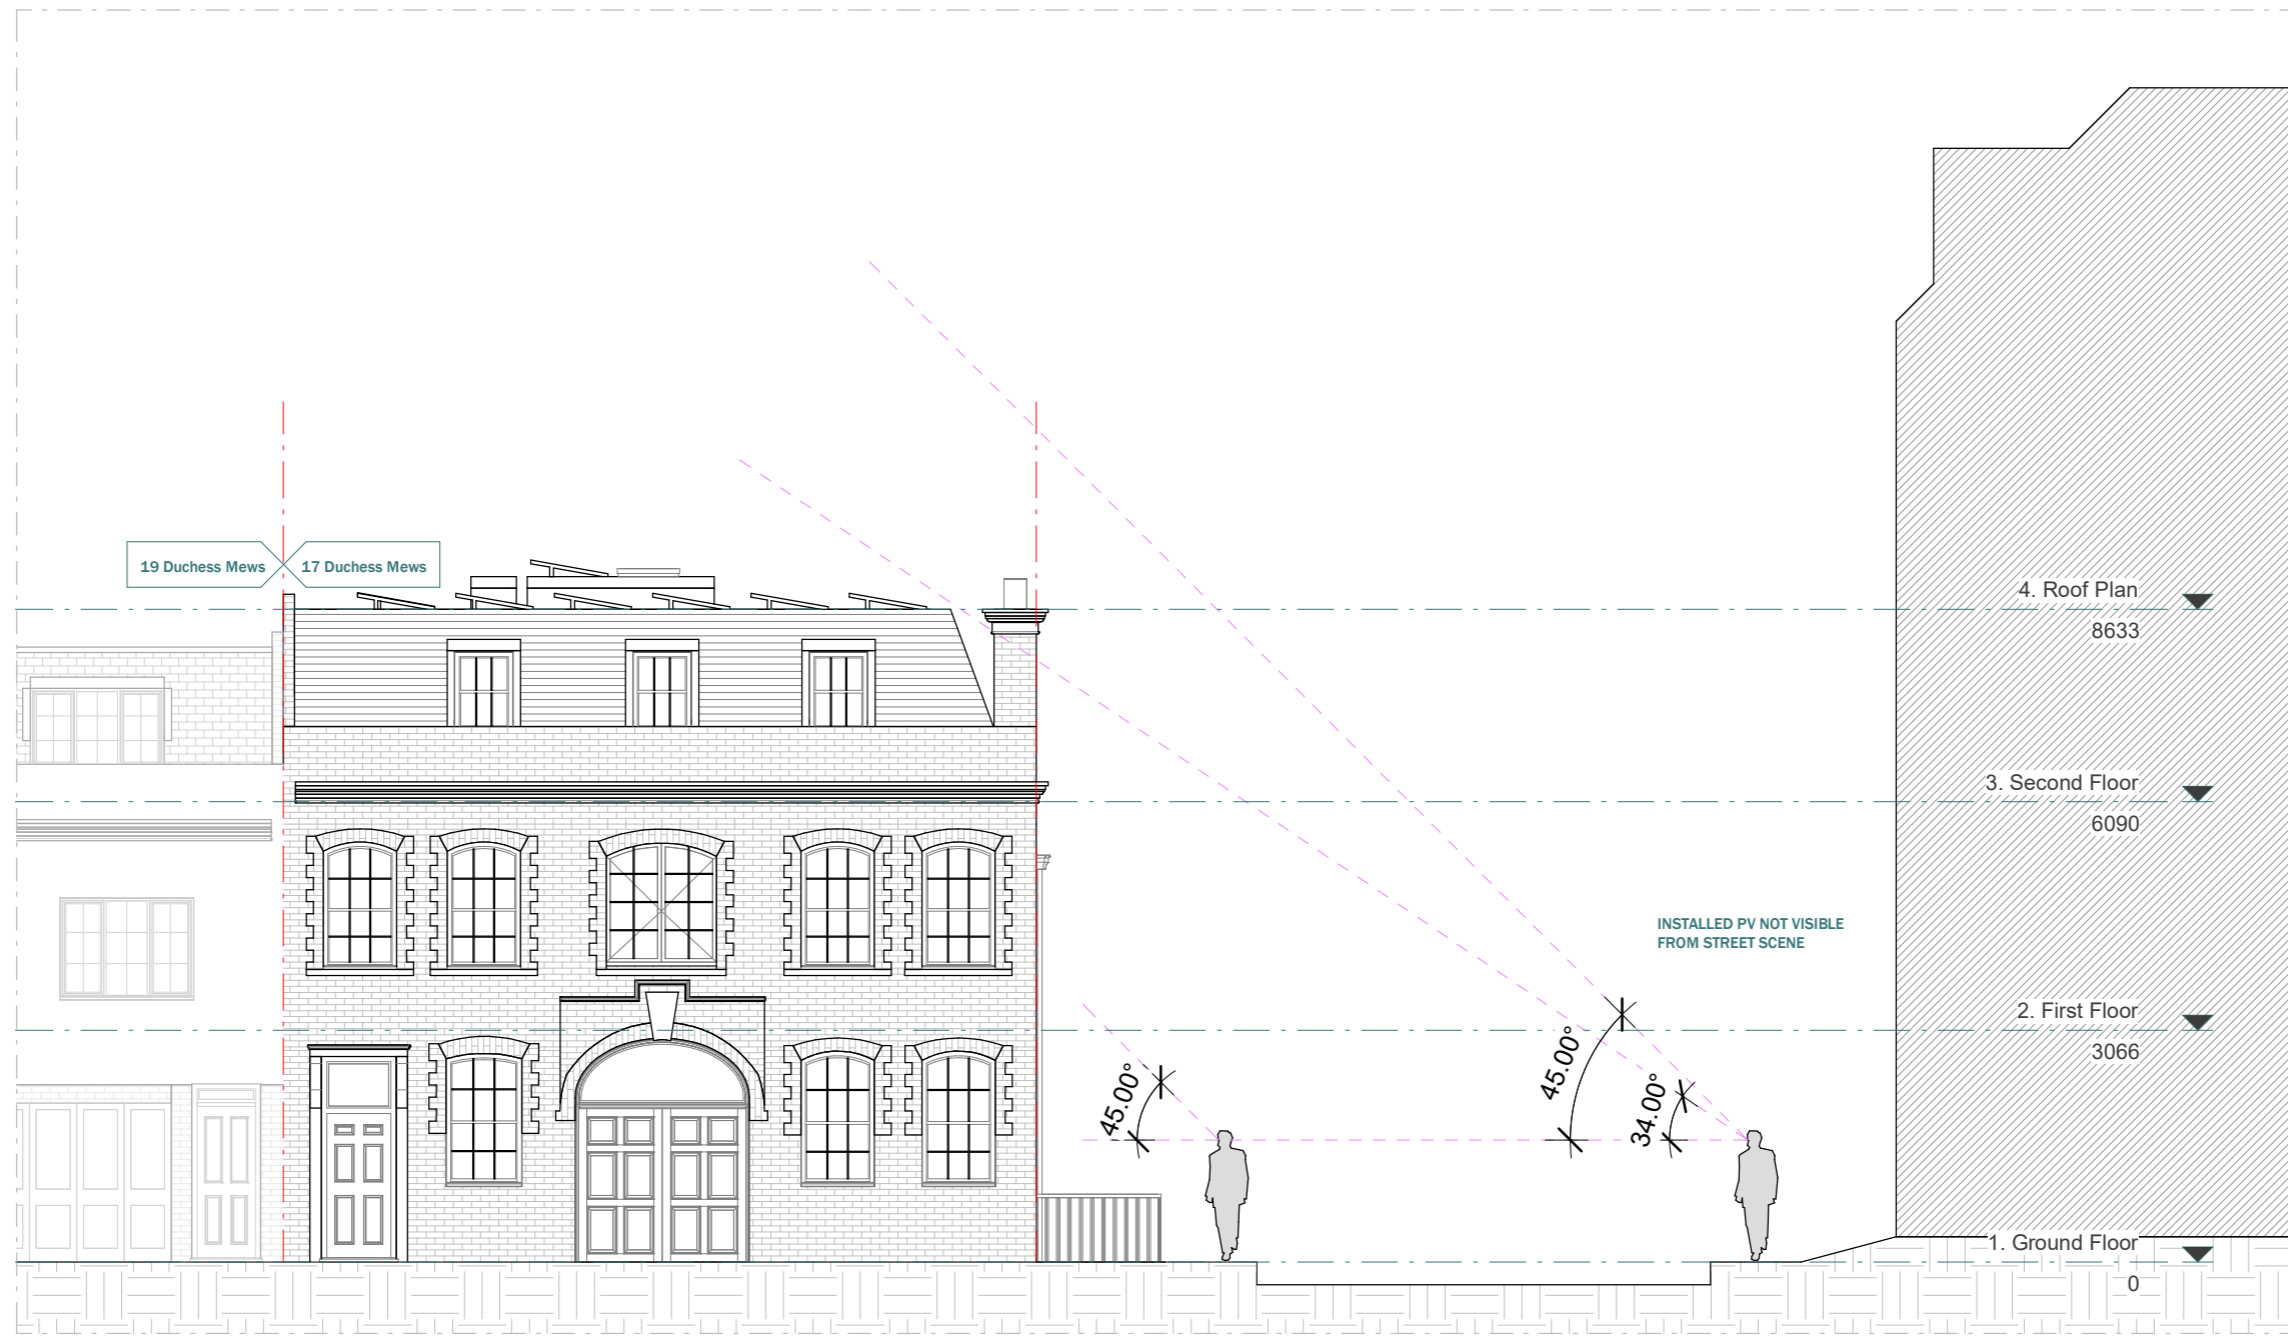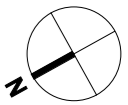

AS-BUILT STREET ELEVATION

Scale 1:100
@A3



This drawing is prepared solely for design and planning submission purposes. It is not intended or suitable for either building regulations or construction purposes and should not be used for such. All dimension shall be check and confirmed with site rep. and any discrepancies between the drawings and site shall be reported to PM. This drawing to be read in conjunction with engineers specification and details. For construction information please refer to all drawings and specification of works.

For any structural steelworks details please refer to structural engineer's drawings & calculations.

The copyright of the drawing and designs remains with Extension Architecture. All copies are only for information about the application, they may not be used for any other purpose without the express written permission of Extension Architecture.

CLIENT Duncan Brown	NOTES			SCALE 1 : 100	DATE 22.09.2023
PROJECT 17 Duchess Mews, London W1G 9DU	VERSION	DESCRIPTION	DATE	DRAWN ZG	VERSION
TITLE As-Built Street Elevation				SHEET REF. NO 17DM -PL -12	