



Proposed East Elevation (Rear)



Proposed North Elevation (Side)

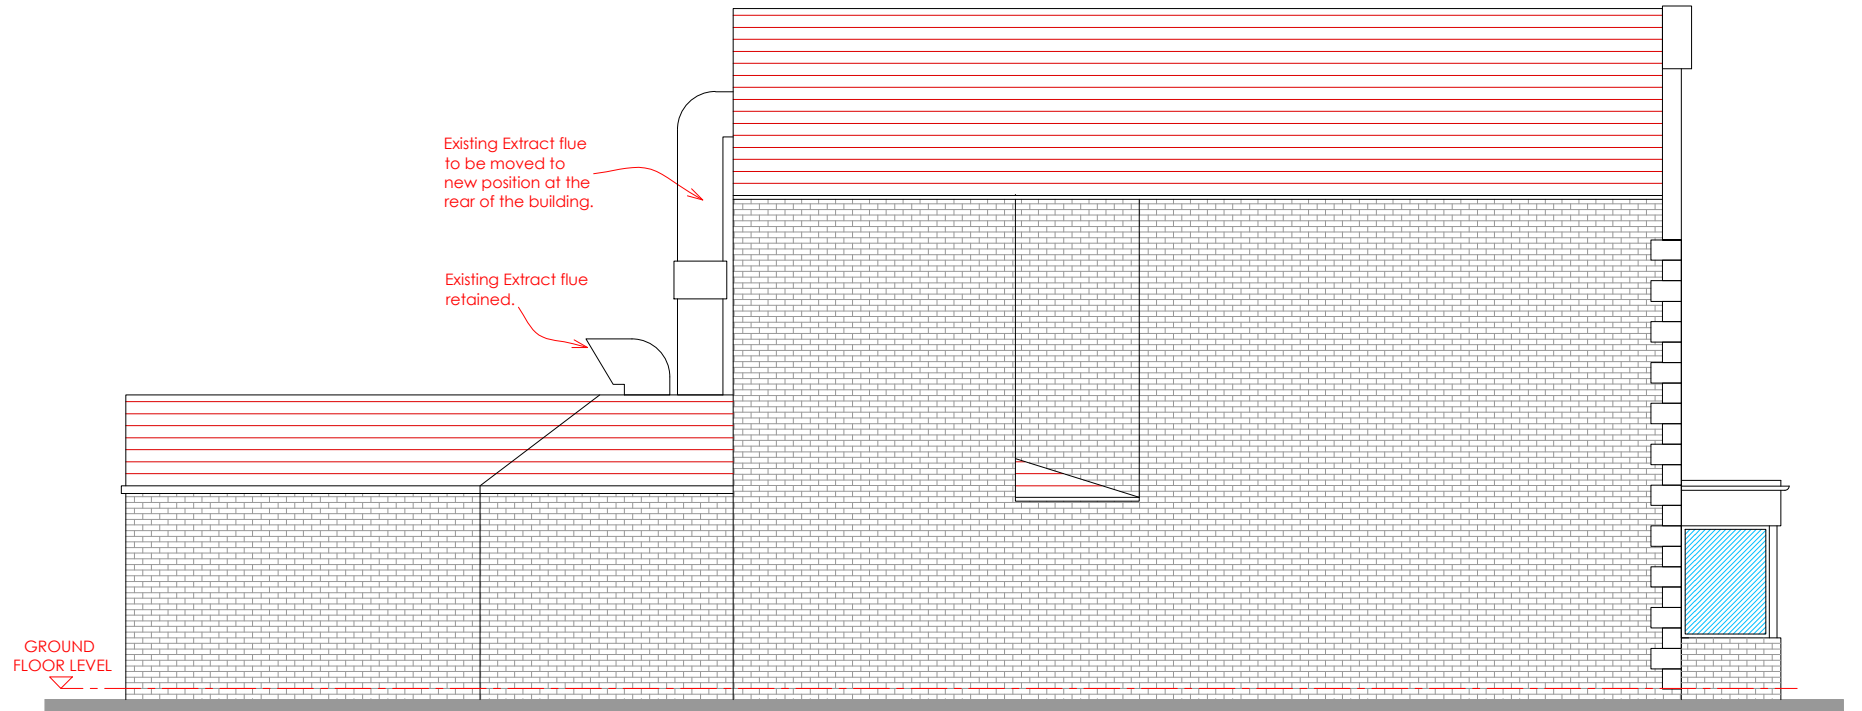

Proposed West Elevation (Front)

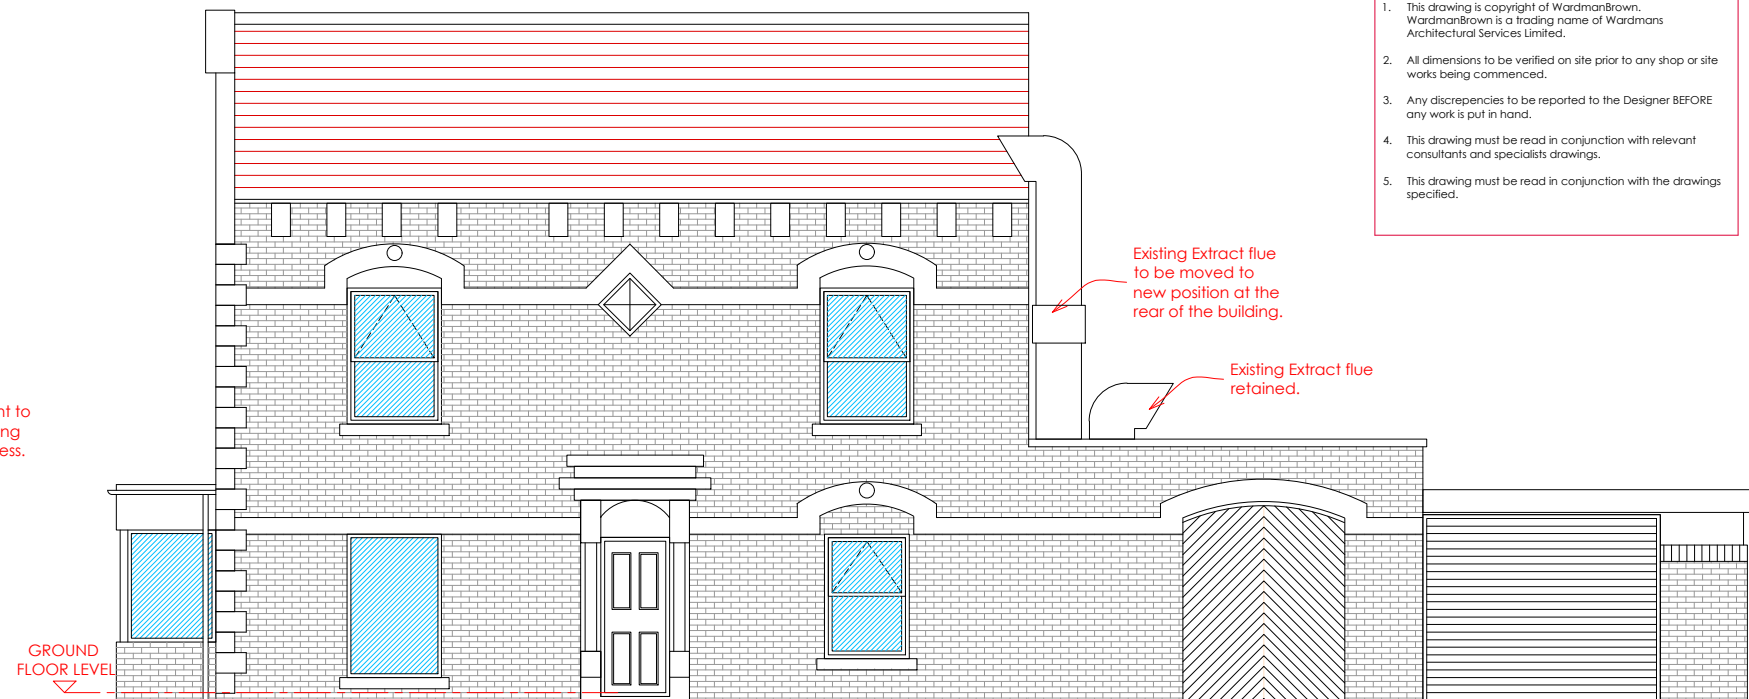

Proposed South Elevation (Side)

- NOTES:
1. This drawing is copyright of WardmanBrown. WardmanBrown is a trading name of Wardmans Architectural Services Limited.
 2. All dimensions to be verified on site prior to any shop or site works being commenced.
 3. Any discrepancies to be reported to the Designer BEFORE any work is put in hand.
 4. This drawing must be read in conjunction with relevant consultants and specialists drawings.
 5. This drawing must be read in conjunction with the drawings specified.

- CDM 2015 - (Refer to Project Health & Safety information)
- HAZARDS
1. Live services adjacent/on site.
 2. Excavations - Ground Collapse
 3. Handling major components
 4. Working at height - Falling
 5. Machinery & Equipment
 6. Ensure all blockwork has a minimum crushing strength of 3.5N/mm²
 7. The weight of each block must not exceed 20Kg

B	28-02-24	As Built Extraction position shown
A	09-11-23	External extract position altered
REV	DATE	DETAILS
REVISIONS:		

62 Duke Street
Darlington, DL3 7AN
Tel: 01325 460227

info@wardmanbrown.com
www.wardmanbrown.com

CHARTERED PRACTICE

CLIENT: Arash Nadiri
PROJECT: 4 High Northgate, Darlington, DL1 1UN.
DRAWING TITLE: Proposed Elevations
PURPOSE OF ISSUE: PLANNING DRAWING
SCALE: 1:100 @ A3
DATE: NOV 2023 DRAWN: LSW DRG REVISION:
DRAWING NO: L022101-005 B