


Key
 — Site / Land Ownership
 - - - Remove / Demolish

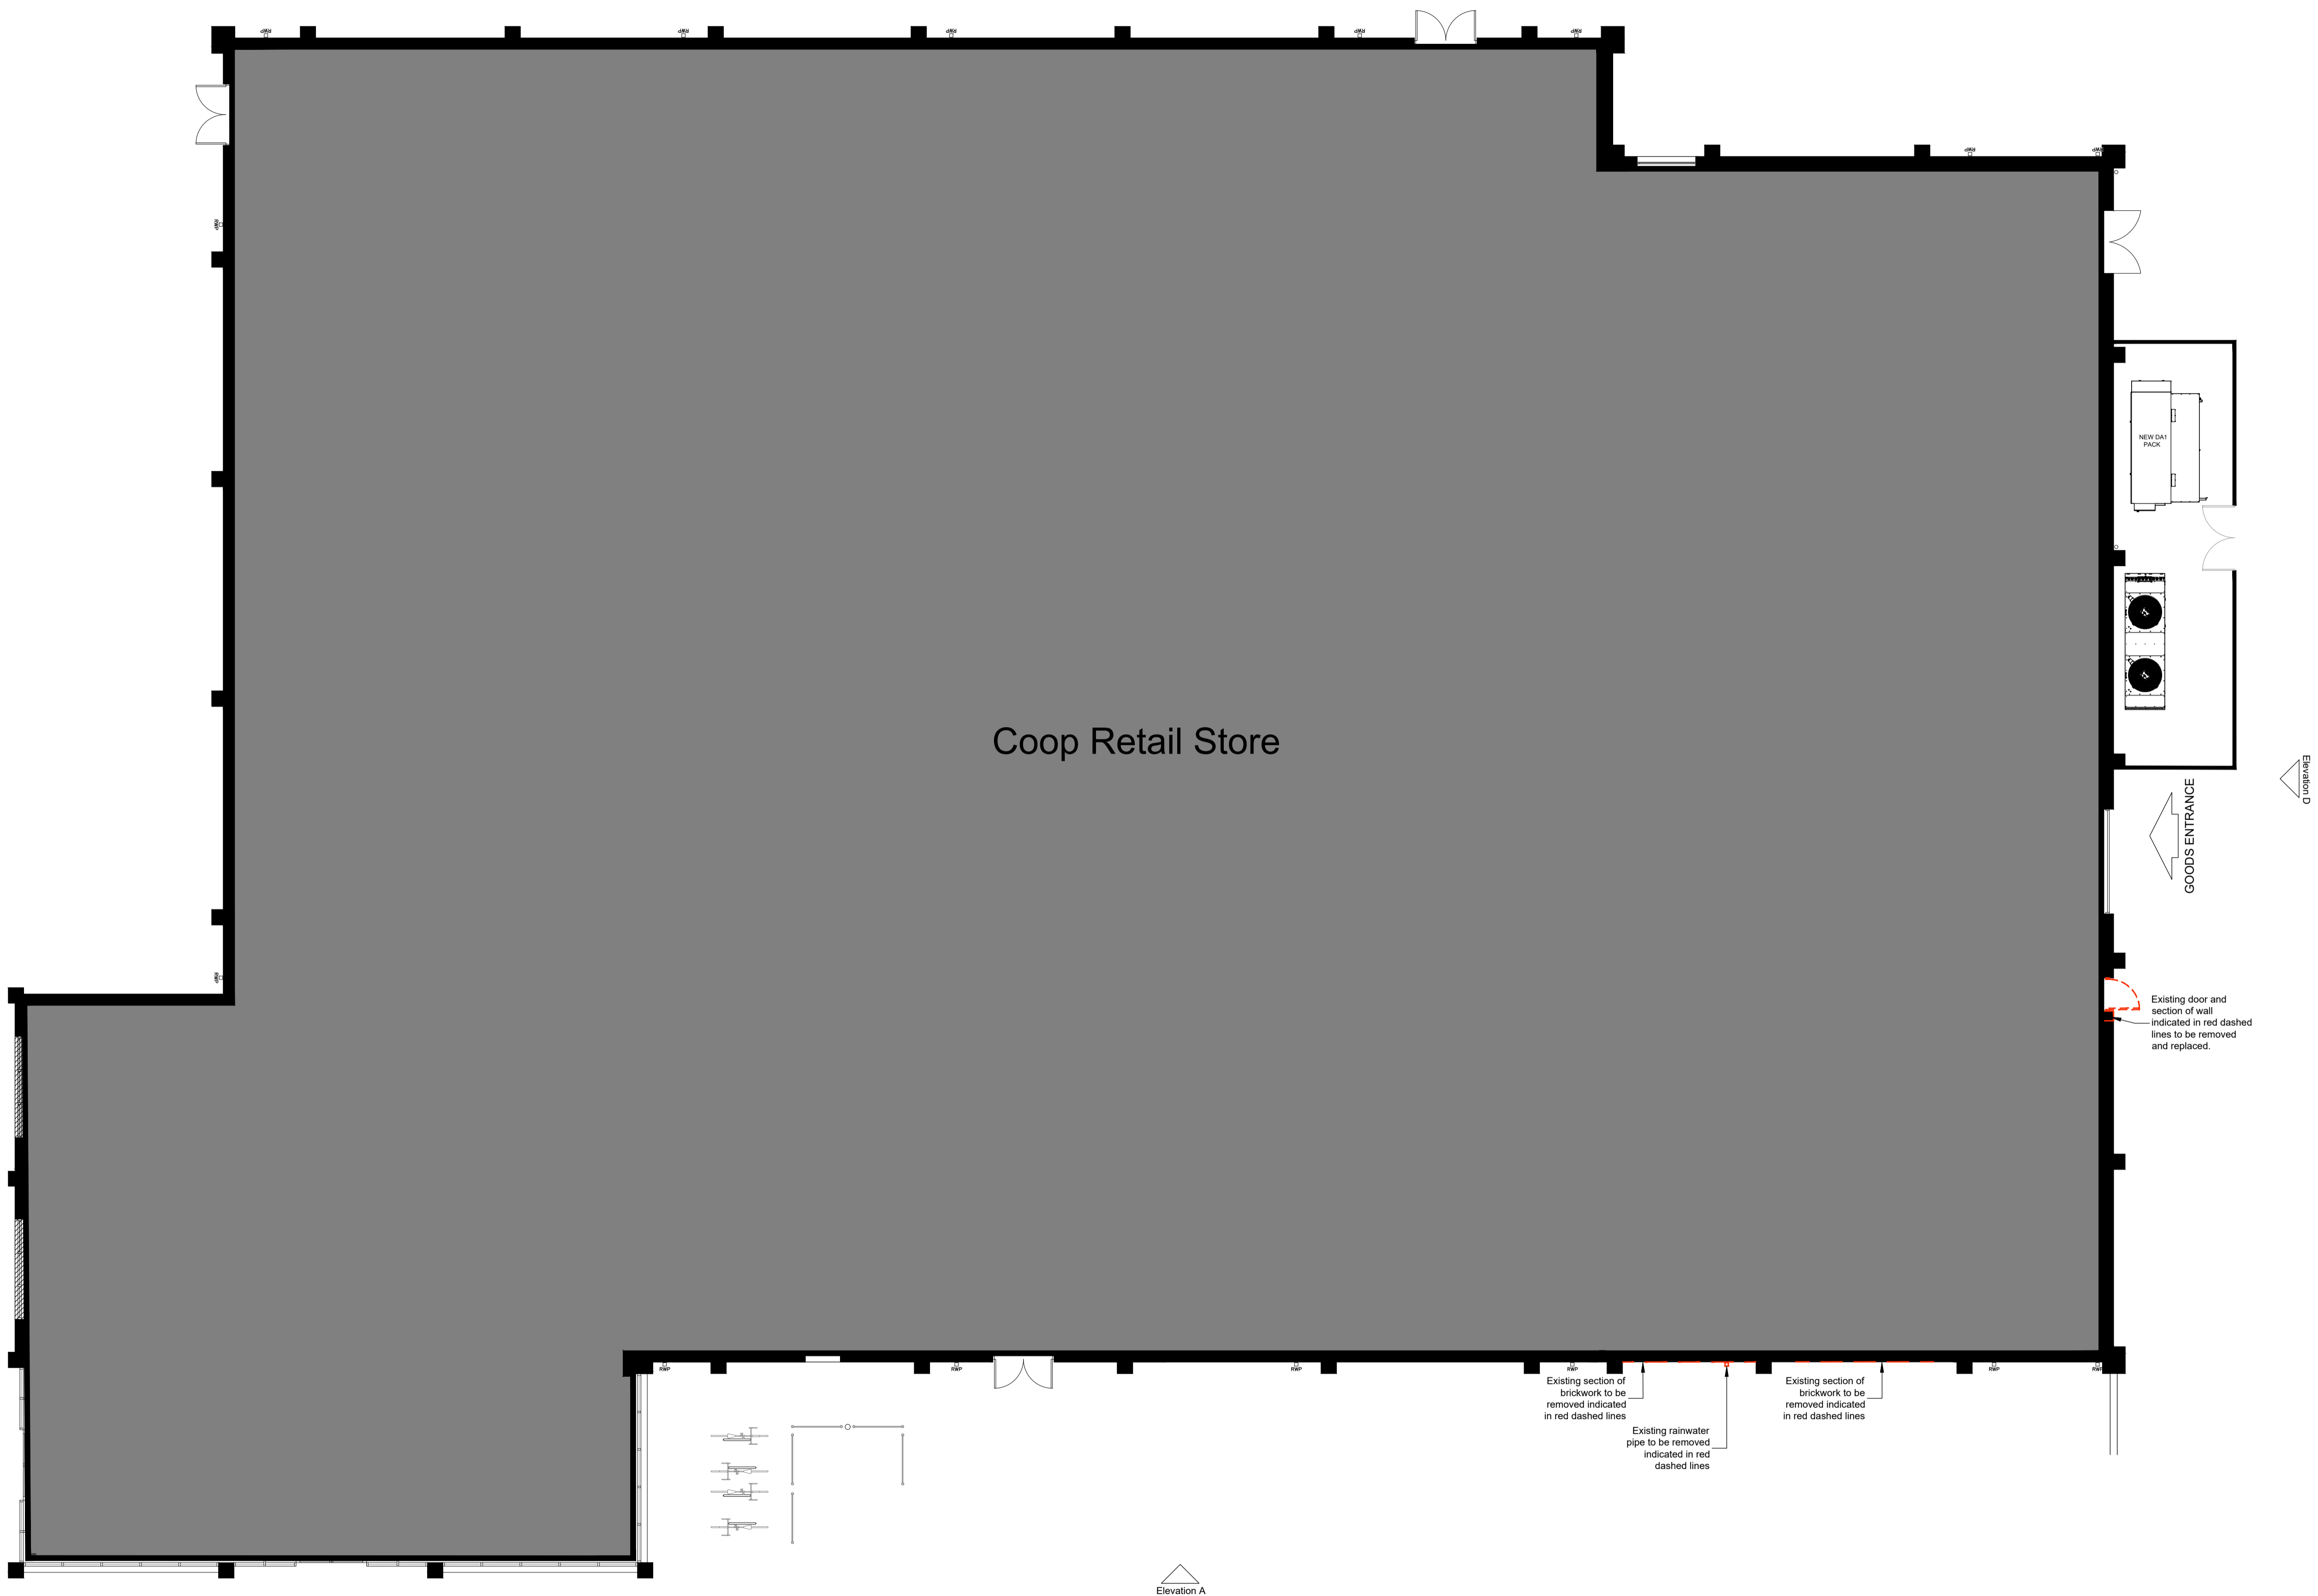

Coop Retail Store

GOODS ENTRANCE

NEW DAT PACK


Goods Lift

Existing door and section of wall indicated in red dashed lines to be removed and replaced.

Existing section of brickwork to be removed indicated in red dashed lines

Existing rainwater pipe to be removed indicated in red dashed lines

Existing section of brickwork to be removed indicated in red dashed lines

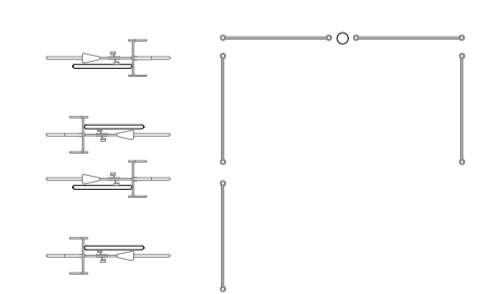

Existing Plan @ 1:100



Revision	Date	By	Chk

All dimensions to be verified on site, and the Architect informed of any discrepancy. All drawings and specifications should be read in conjunction with the Health and Safety Plan; all conflicts should be reported to the appointed Principal Designer.

Louth Northgate
 Coop Funeral Care
 Northgate, Louth LN11 0LT
 Sheet Name: Existing Plan
 Purpose of issue: Planning Status:
 Date: 26.02.24 Checked by: DH
 Drawn by: GM Scale @ A1: As ind
 Project No: 8795.05 Revision: P1
 Drawing No : 8795.05 -BOW-A1-ZZ-ZZ-A-0001



Do not scale from this drawing. This drawing is the copyright of Bowman Riley Architects Limited. © P:\Architectural\Retail\8795 - Coop Funeral Care\Homes\8795.05 - FNC Louth Northgate\8795.05 - 05 Cad\0000 Existing, Presentation, Planning\8795.05 - Louth Northgate - 0001 - Existing and Proposed Plans and Elevations.dwg