

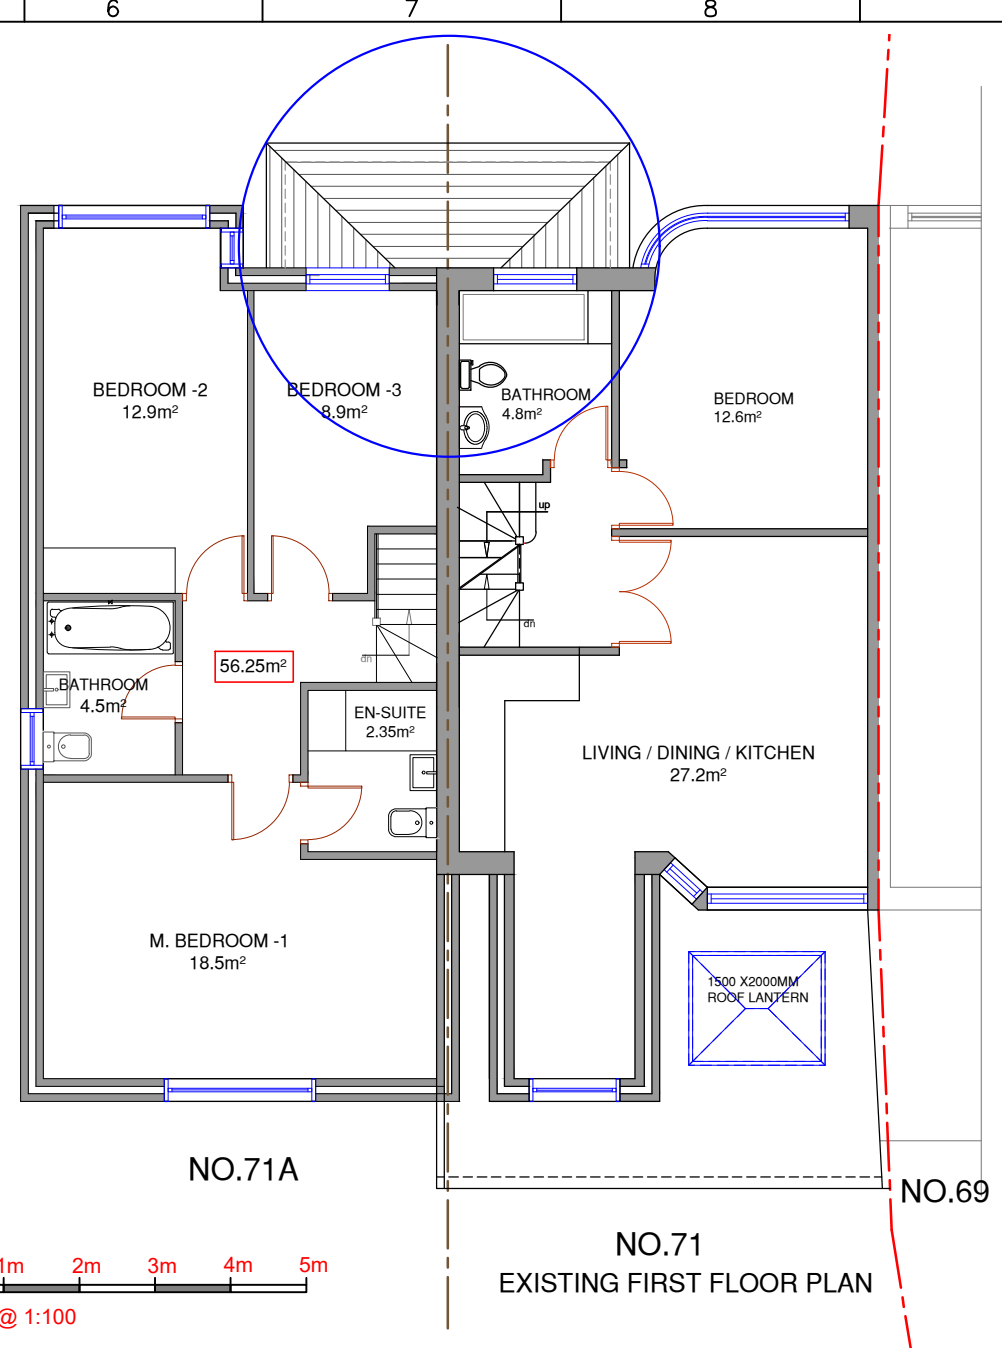



EXISTING FLOOR PLAN

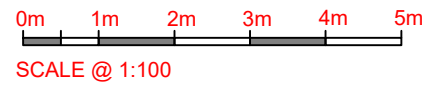


EXISTING FIRST FLOOR PLAN

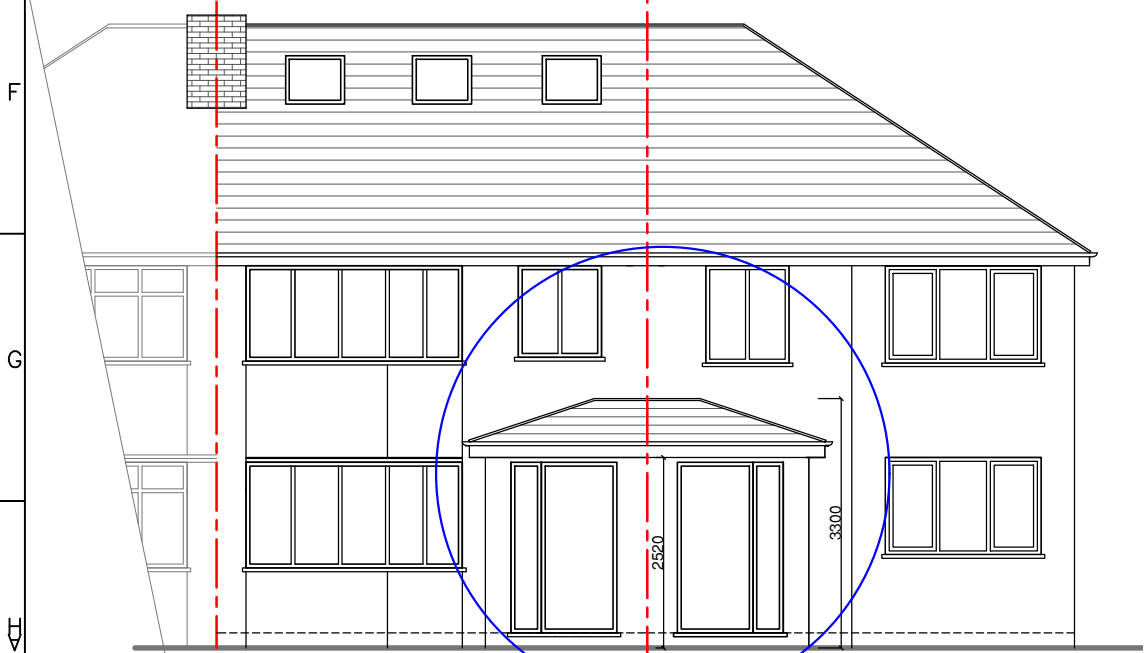

EXISTING FRONT PORCH ELEVATION

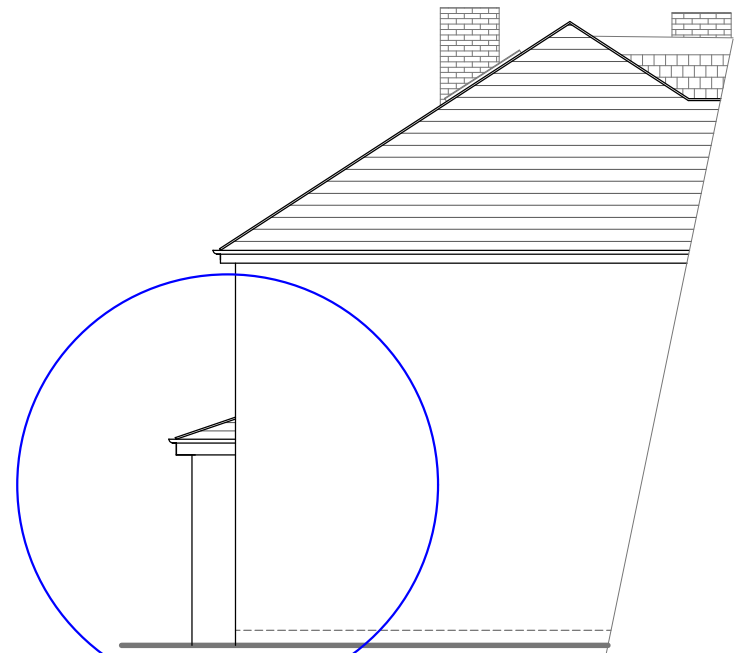

EXISTING SIDE ELEVATION

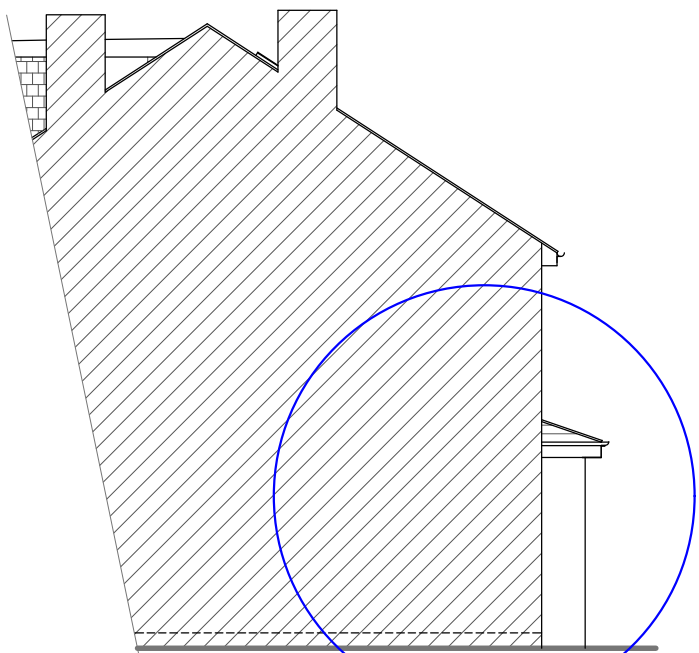

EXISTING SIDE ELEVATION

NOTES :



| Date | Revisions |
|------|-----------|
| | |
| | |

SJR DESIGN LTD.
(ARCHITECTURAL DESIGN & CONSTRUCTION)

Client **MR. REMIR CERPIA**

Job Title
**71 GEORGE V WAY
PERIVAL, WEMBLEY
UB6 7JA**

Drawing Title
**EXISTING FLOOR PLANS
AND ELEVATIONS -AS BUILT
(FRONT PORCH)**

Scale: 1 : 100 (A3)
Date: FEBRUARY 2024
Checked by: Drawn by: RS

| | |
|------------------------|------|
| Drg No. TP /520/P03 | Rev. |
|------------------------|------|