Geotechnical Assessments | Environmental Assessments | Desktop Studies | Contamination Analysis

21st June 2023

Our ref: CSG/18272

Mr P Snell phil@psnell.co.uk

Dear Sir,

Re: Lower Broomfield, Stortford Road, Little Hallingbury, Herts. CM22 7RT - 18272

## **Land Gas Investigation**

Following the Environmental Report completed at the above site, and in accordance with CLR11, BS 10175:2011, BS 8485:2007, CIRIA C665 and CIRIA R149, risks from land gas due to the potential made ground within the site and infilled gravel pit and ponds surrounding the site, Land Gas risk assessments have been completed. These will include the potential for contamination migration from on and off-site sources which may be present in concentrations where risk is recorded.

Land gas monitoring has specifically targeting the following land uses.

Table 1 Land Gas Risk Assessment - Response Zone

Feature	Targeted Response Zone	Location to Target	Vapour or Gas risk					
Infilled Gravel Pits	Made Ground / Lowestoft Formation	Site Wide	Land Gases - CO <sub>2</sub> , CH <sub>4</sub> .					
Infilled Ponds	Made Ground / Lowestoft Formation	Site Wide	Land Gases - CO <sub>2</sub> , CH <sub>4</sub> .					

Within the site one standpipe was installed within WS1 as noted on the attached plan and log.

The geology within the site is recorded as a topsoil fill over sand and gravel to about 0.80m where clay soil was in place to the close of the borehole, as such the response zone of the standpipe was installed within this.

The results of the six monitoring rounds are recorded below:-



Table 1 Gas Monitoring Data Sheet

			Flow Rate		Concentration, (CH <sub>4</sub> )			Concentration, (CO <sub>2</sub> )			Concentration, (O <sub>2</sub> )			Q <sub>ng</sub> , CH4	Q <sub>ha</sub> , CO <sub>2</sub>		Floodec Response						
	21112			Steady	,			Steady				Steady				Steady				Stratum	Zone	Barometric Pressure	Other Gases
Date	BH ID	Peak	15	30	45	Peak	<i>15</i>	30	15	Peak	<i>15</i>	30	45	Peak	15	30	45			Screened		i iessuie	Gases.
			secs	Secs	Secs		Secs	Secs	secs		secs	Secs	Secs		secs	Secs	Secs	(Peak) <sup>A)</sup>	(Peak) <sup>A)</sup>		(Yes / No)		
		L/h	L/h	L/h	L/h		9	%			%					%						mB	
22/5/23	WS1	0.1	0.1	0.1	0.1	0.0	0.0	0.0	0.0	2.1	2.1	2.1	2.1	19.5	19.5	19.5	19.5	0.0	0.0021		N	999	No VOC's
26/5/23	WS1	0.1	0.1	0.0	0.0	0.0	0.0	0.0	0.0	2.3	2.3	2.3	2.3	19.6	19.6	19.6	19.6	0.0	0.0023	SAND &	N	1019	No VOC's
1/6/23	WS1	0.0	0.0	0.0	0.0	0.0	0.0	0.0	0.0	2.4	2.4	2.4	2.4	19.1	19.1	19.1	19.1	0.0	0.0	GRAVEL	N	1010	No VOC's
5/6/23	WS1	0.0	0.0	0.0	0.0	0.0	0.0	0.0	0.0	2.2	2.2	2.2	2.2	19.5	19.5	19.5	19.5	0.0	0.0	over CLAY	N	1001	No VOC's
13/6/23	WS1	0.0	0.0	0.0	0.0	0.0	0.0	0.0	0.0	2.1	2.1	2.1	2.1	19.2	19.2	19.2	19.2	0.0	0.0	CLAT	N	1014	No VOC's
20/6/23	WS1	0.0	0.0	0.0	0.0	0.0	0.0	0.0	0.0	2.1	2.1	2.1	2.1	19.2	19.2	19.2	19.2	0.0	0.0		N	1010	No VOC's

A) Calculated using peak concentration and steady state flow (see 6.3.4). Works and table completed in accordance with BS 8485: 2015, (Code of practice for the design of protective measures for methane and carbon dioxide ground gases for new buildings).

Table prepared after Table F2, (Gas Monitoring Data).



Considering the results of the gas testing no significantly elevated levels were recorded in place within the site on a couple of the visits there was a very slightly flow rate recorded within the site and as such, the following calculation was completed.

$$Qhg = q\left(\underline{Chg}\right)$$
100

q = is the measured flow rate, (in litres per hour) of combined gases from the monitoring standpipe

Chg = is the measured hazardous gas concentration, (in percentage volume / volume)

Therefore:-

$$Qhg = 0.1 \left( \underbrace{2.3}_{100} \right) = 0.0023$$

As such, the Hazardous Gas Flow Rate has been calculated as 0.0023 and we would therefore suggest gas generation within the site area is low and would return a Characteristic Situation in line with CIRIA C665, CLR11 and BS8485:2015 of CS = 1 and no mitigation measures required.

I hope the foregoing is sufficient for your requirements, although, please do not hesitate to contact me should you require any additional information or assistance.

Yours faithfully



Rebecca Chamberlain

Contract Engineer

Appendix No Sheet No Job No

May 2023

Lower Broomfield, Stortford Road, Little Hallingbury, Herts. CM22 7RT

## Location Plan






Not to Scale Sketch No.: GAS / 18727 / 01 / 01 01920 822233 | www.hesi.co.uk | info@hesi.co.uk

Appendix No Sheet No Job No Date

18727 May 2023

Lower Broomfield, Stortford Road, Little Hallingbury, Herts. CM22 7RT

## **Existing Site Plan**

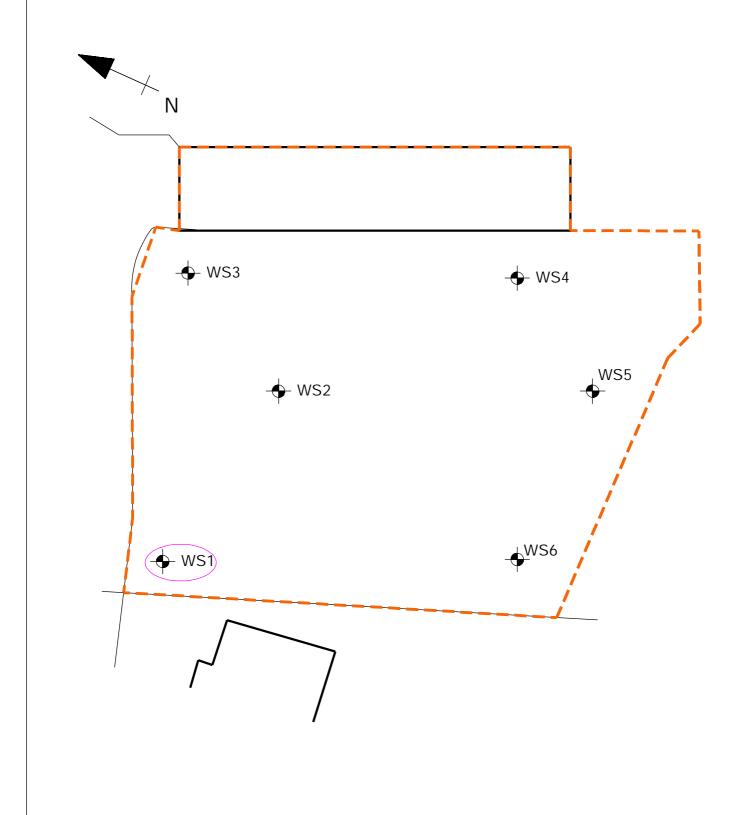

Not to Scale

Sketch No.: GAS / 18727 / 01 / 02

01920 822233 | www.hesi.co.uk | info@hesi.co.uk

Appendix No Sheet No Job No


Date

18727 May 2023

eotechnical Assessments | Environmental Assessments | Desktop Studies | Contamination Analysis

Lower Broomfield, Stortford Road, Little Hallingbury, Herts. CM22 7RT

Proposed Site Plan

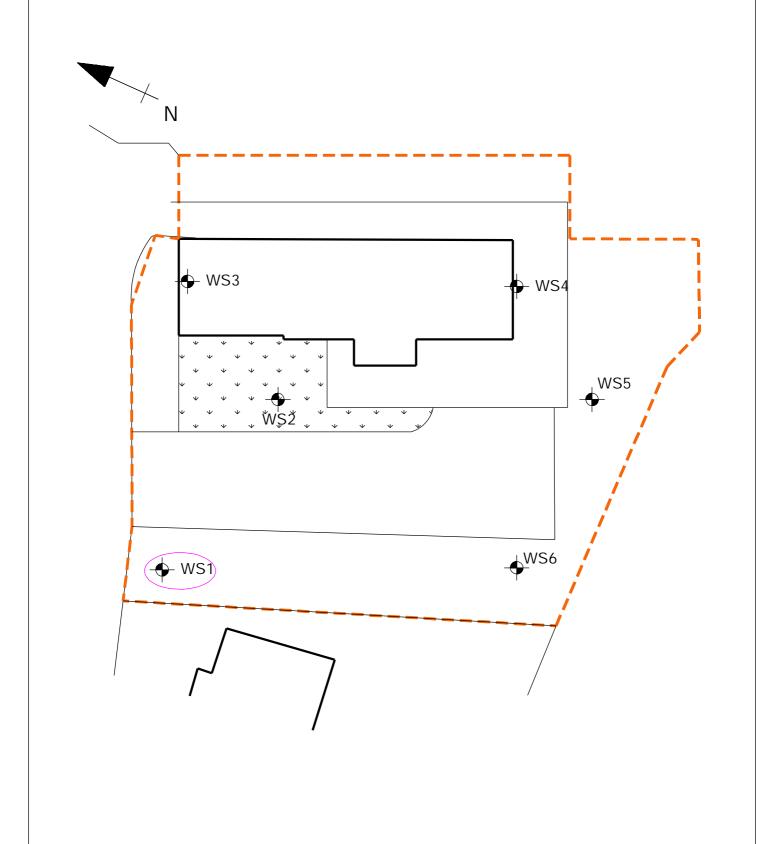

Not to Scale

Sketch No.: GAS / 18727 / 01 / 03



Unit J8 | Peek Business Park | Woodside | Bishops Stortford | CM23 5RG

01920 822233

info@hesi.co.uk

Appendix No 2 Sheet No Job No Date

18272 May 2023

L	ower Broomfield, Stortford Road, Little Hallingbury, He	erts. CM	7RT					4			
W	Vindow Sampler One						K	<b>^</b> -	1	- ` P	
	Description Of Stratum		_		10	Se m	ples Leptn (m)	Strength			
-	Loose dark brown topsoil FILL	0.20	0.20	_	1	U	GL - 1.00				
-	Medium dense brown slightly clayey SAND & GRAVEL		0.60								000000000000000000000000000000000000000
1.0	Firm to stiff brown sligtly to moderately sandy slightly silty CLAY	0.80	<b>&gt;</b>	4	2	U	1.00- 2.00				000 000 000 000 000 000 000 000 000 00
											000000000000000000000000000000000000000
2.0	Becoming more less sandy from 2.70m		2.20		3	U	2.00 - 3.00		000000000000000000000000000000000000000		000000000000000000000000000000000000000
	Roots to 3.00m	2 00							10000000000000000000000000000000000000		0 1
3.0	Borehole Complete at 3.00m Remarks	3.00							<u>۲</u> ۰	<u> </u>	K07