




West Elevation
(from 44 Craiglea Drive)

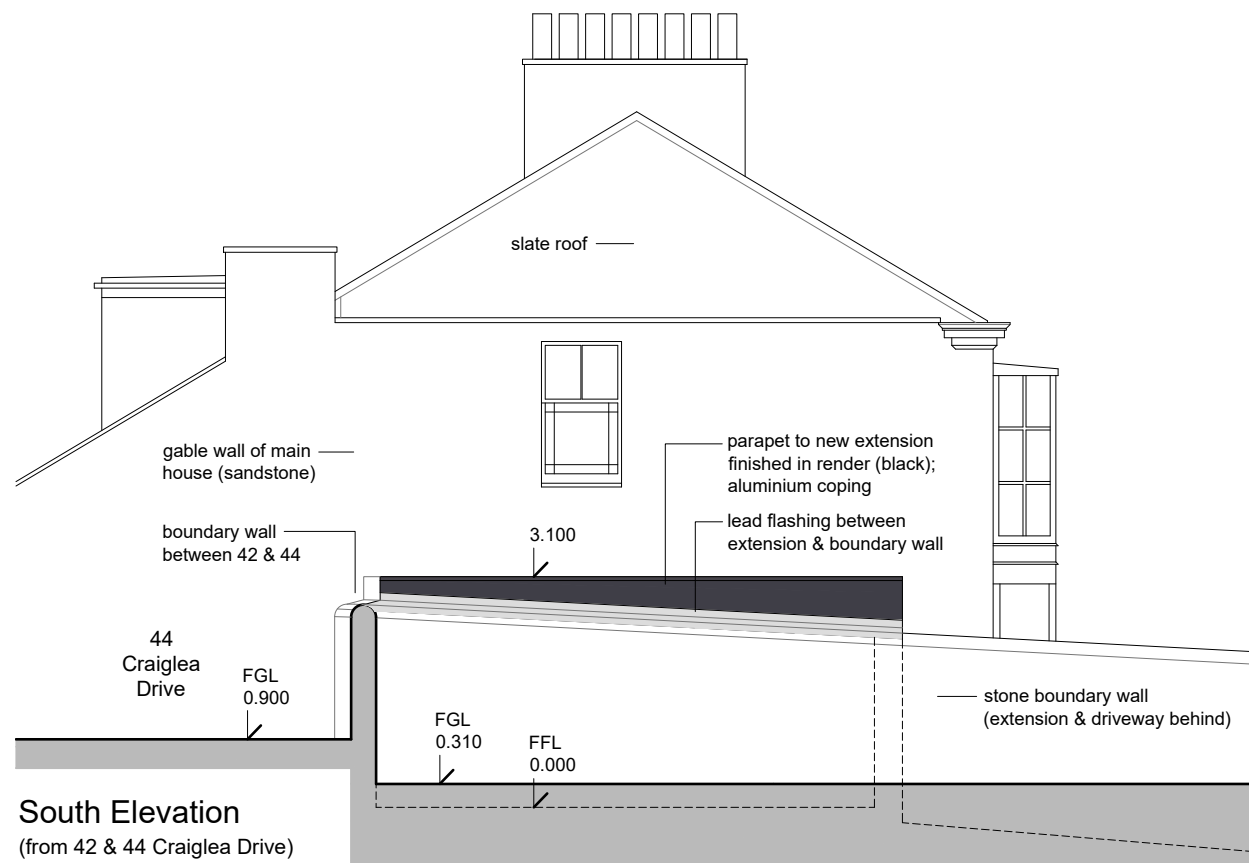


South Elevation
(from 42 & 44 Craiglea Drive)

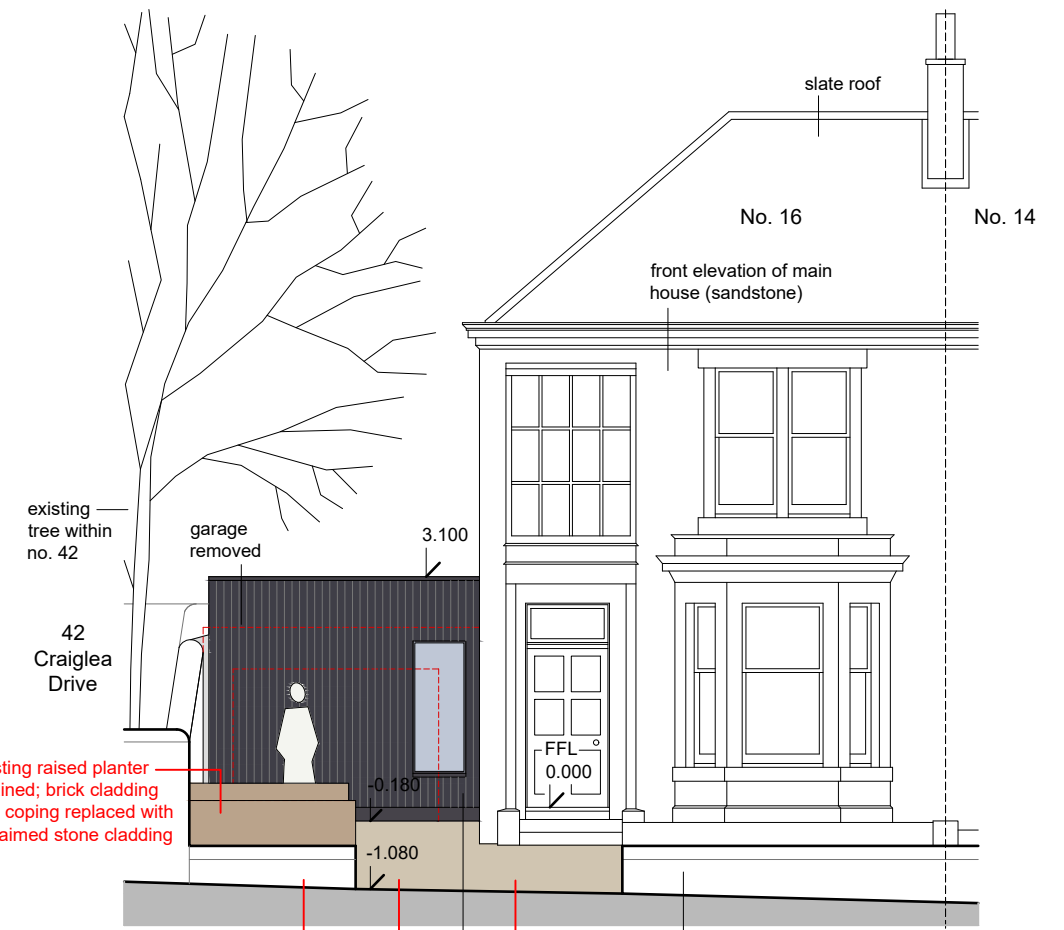

East Elevation
(from Dalhousie Terrace)

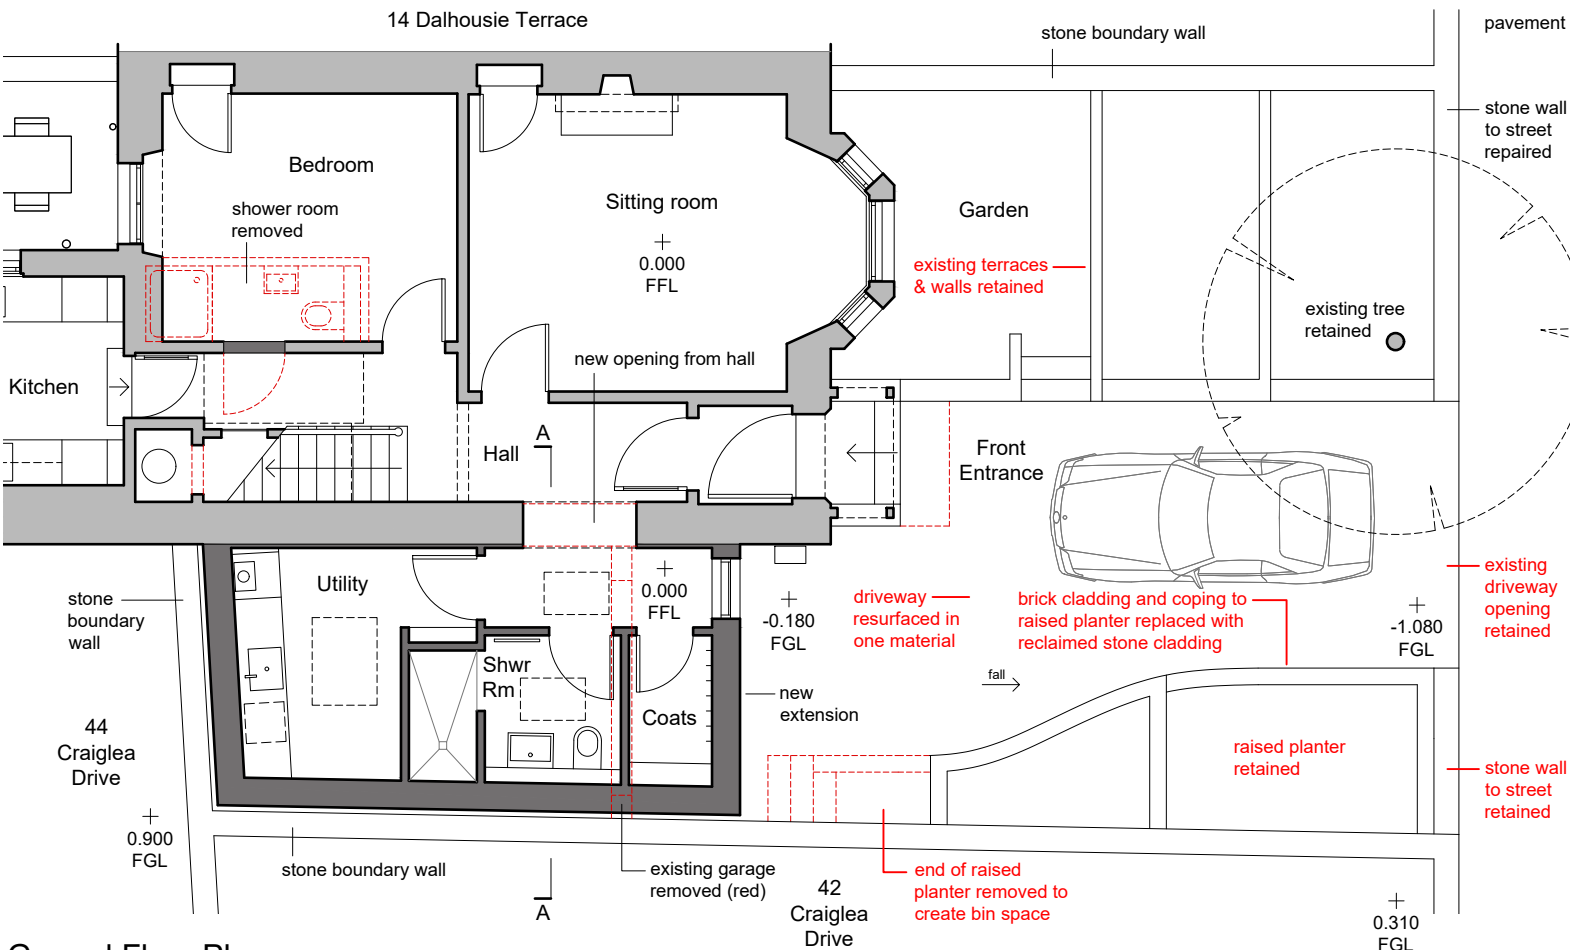

Ground Floor Plan

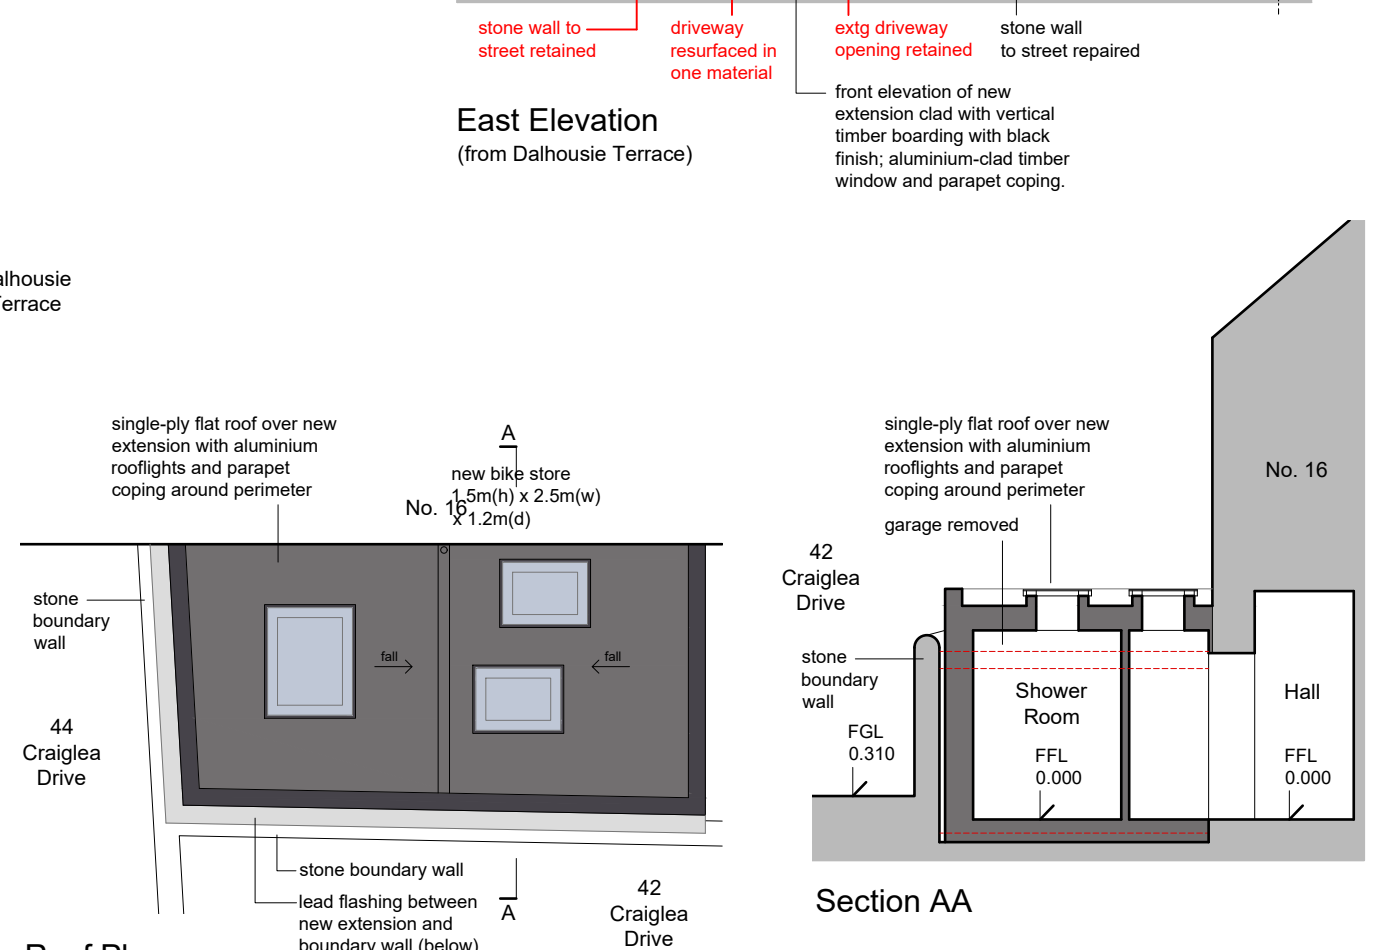

Roof Plan

Section AA

NOTES
 1. All levels are in metres, and are approximate.
 2. Demolitions/ dountakings indicated in red.

REVISIONS
 A 08.08.22 Driveway opening width amended to 3m (max).
 B 01.03.24 NMV changes as noted in red.

New Extension & Other Alterations to 16 Dalhousie Terrace, Edinburgh

Alexander Philip - Architect

11 Dick Place Edinburgh EH9 2JS
 tel 0131 668 3030 email mail@alexanderphilip.com

Proposed Plans, Section & Elevations

Date	Scale	Job No.	Drg No.	Rev.	Stat.
Apr '22	1:100	2201	03	B	PL