

carefully remove existing crested clay ridge tiles and refix with supplementary reclaimed ridge tiles to match existing as necessary

6 no. Nature Vent ventilators @ 1.75 m centres

integrated PV panels

existing natural slates relaid onto insulated roof

Velux GGL electric top-hung escape window MK06  
 Dimensions: 78 x 118 cm  
 Triple glazing 66  
 (Ug = 0.6 W/m2K; g = 0.44)

lead clad fascia


existing VP retained

existing leaded and stained glass windows retained and overhauled

remove existing stained glass window; provide replacement doubled glazed timber doors and fanlight

brickwork below existing window removed for proposed double glazed french doors

C5	15.03.24	As built for application to discharge planning conditions	AG
C4	14.08.23	Ground line amended; window/ door opening annotation added	AG
C3	19.07.23	Window/ door annotation added	AG
C2	16.06.23	Brick coursing adjusted; window/ door notation added	AG
C1	29.05.23	Elevation title corrected; initial construction issue	AG
P3	21.12.22	Roof detail added	AG
P2	21.11.22	MVHR vents added	AG
P1	19.11.22	Initial issue	AG
Rev	Date	Amendment	By Chkd

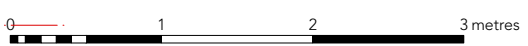

## Proposed east elevation

Proposed conversion to dwelling  
 Former Methodist Chapel, The Street, Braughing, Herts SG11 6RD  
 Scale 1:50 @ A3 Date Nov 2022 Drawing no. 22\_404 | L | 016\_C5