



# CONSTRUCTION

**Notes**  
 All dimensions to be checked on site prior to commencement of any works.  
 Refer any discrepancies to the architect.

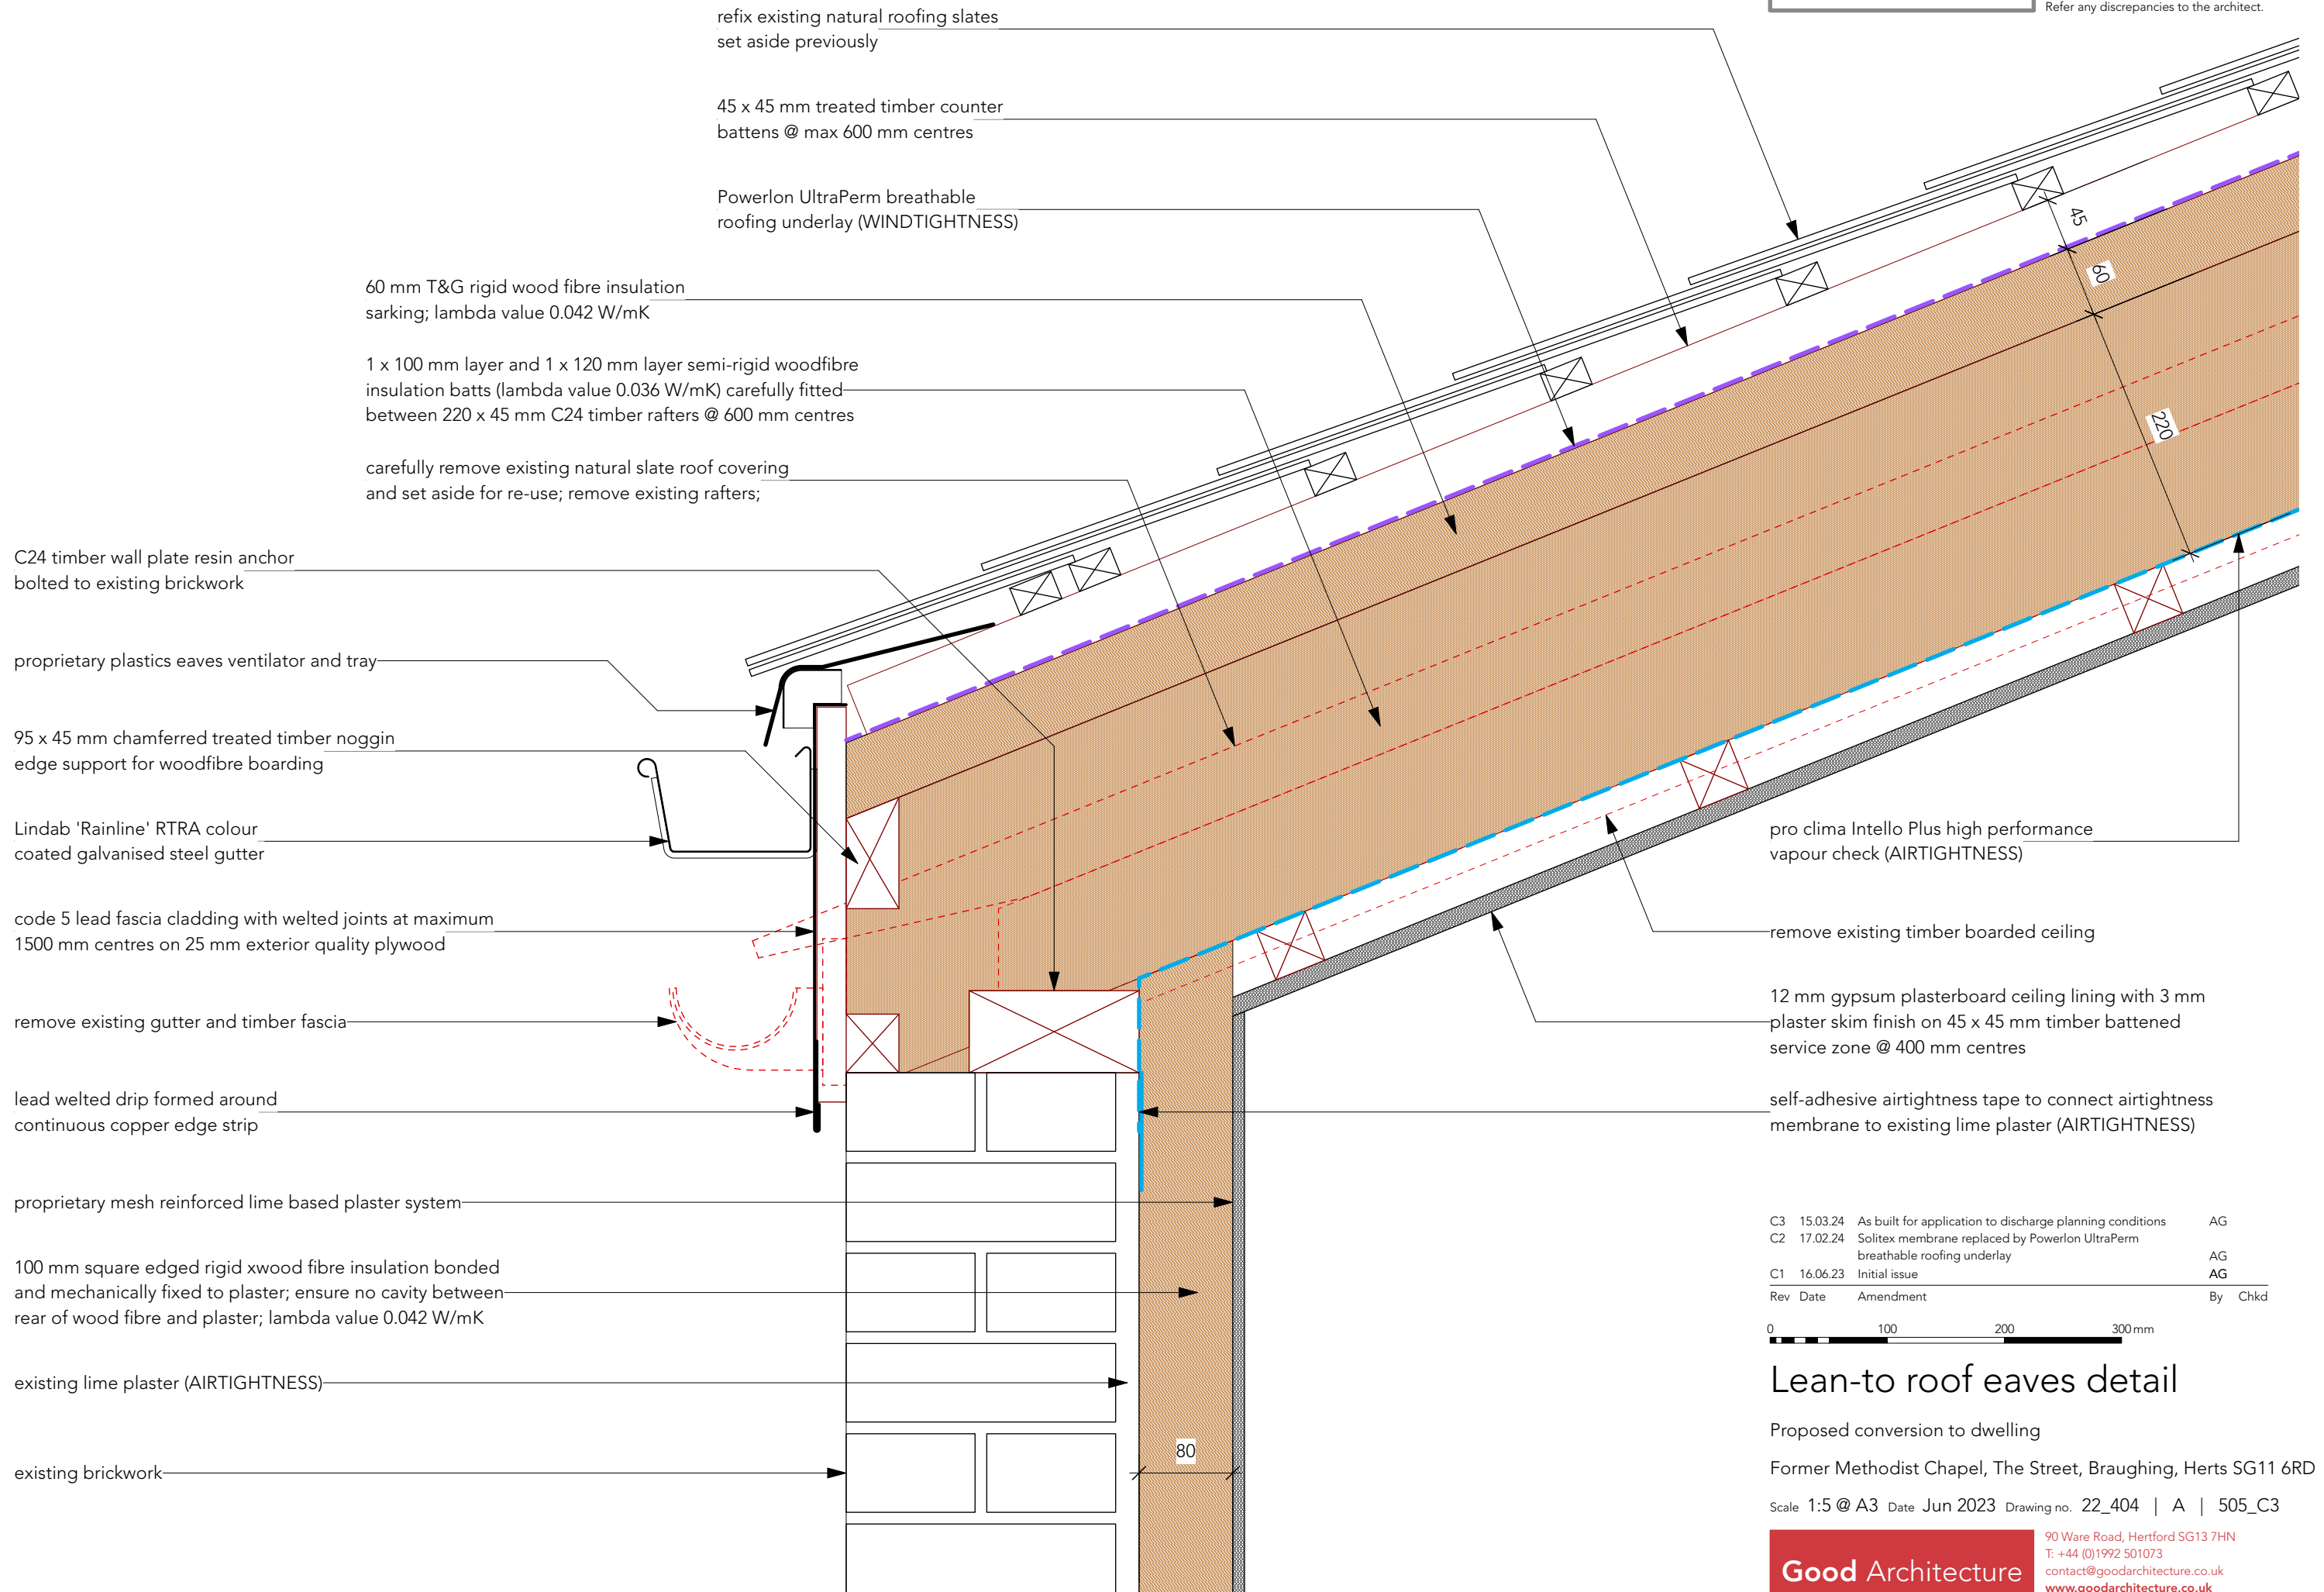

C3	15.03.24	As built for application to discharge planning conditions	AG
C2	17.02.24	Solitex membrane replaced by Powerlon UltraPerm breathable roofing underlay	AG
C1	16.06.23	Initial issue	AG
Rev	Date	Amendment	By Chkd

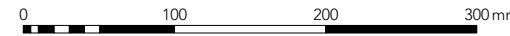

**Lean-to roof eaves detail**  
 Proposed conversion to dwelling  
 Former Methodist Chapel, The Street, Braughing, Herts SG11 6RD  
 Scale 1:5 @ A3 Date Jun 2023 Drawing no. 22\_404 | A | 505\_C3