





GROUND FLOOR

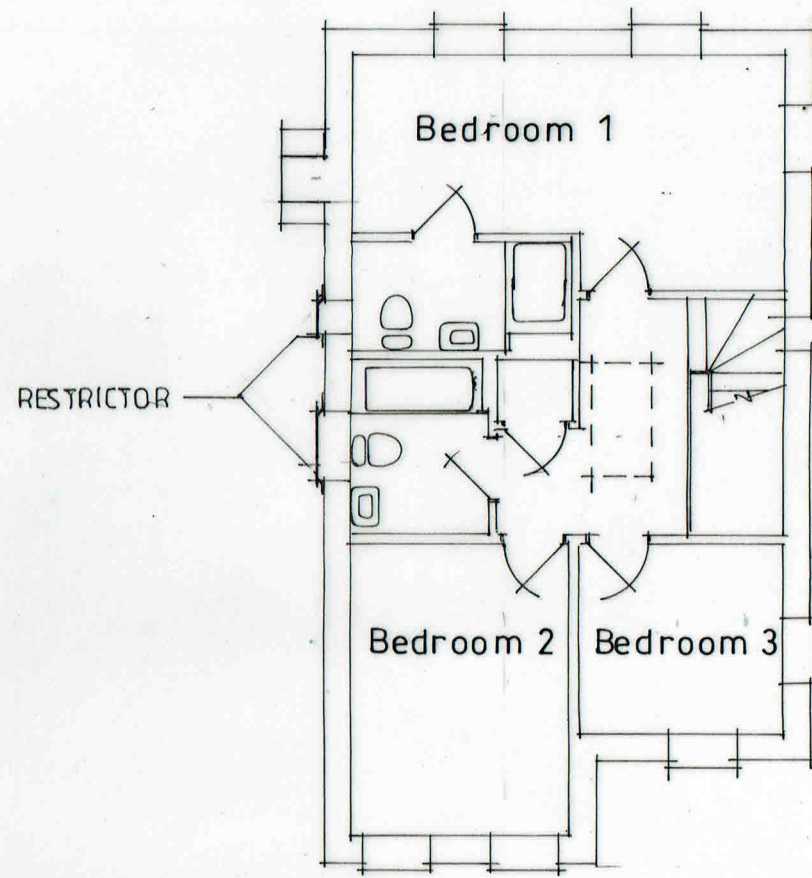

FIRST FLOOR

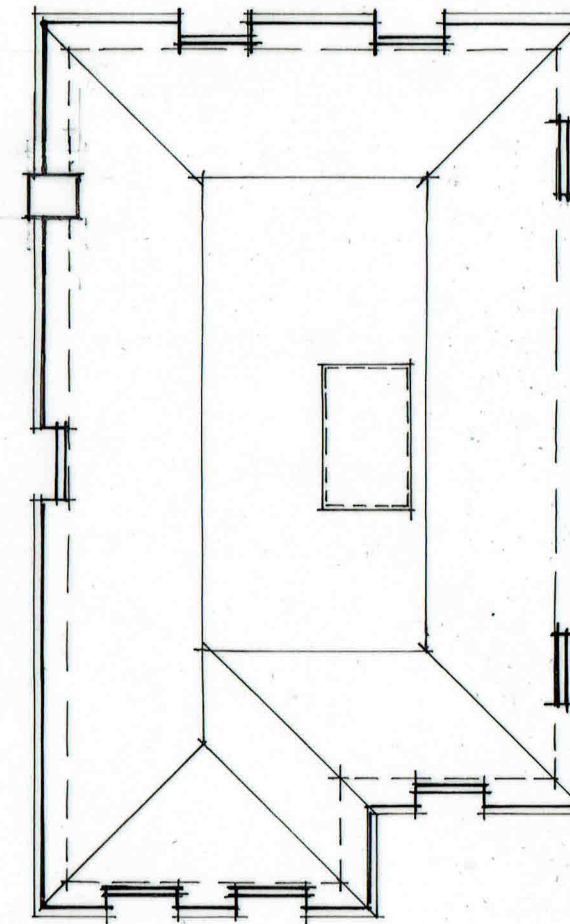


ROOF PLAN

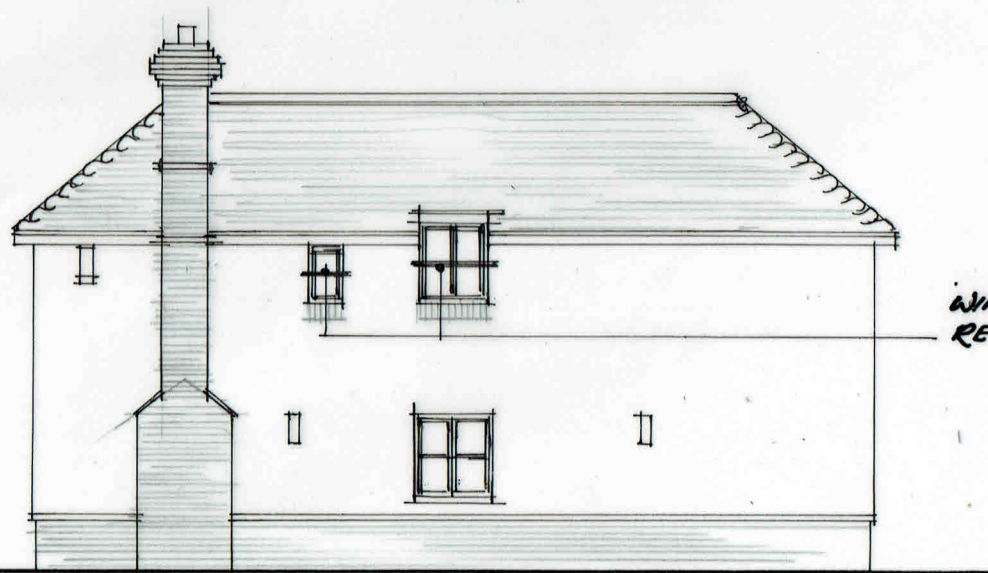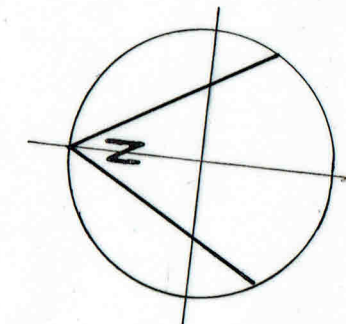


North Elevation

WINDOW OPENING RESTRICTOR.

ELEVATION

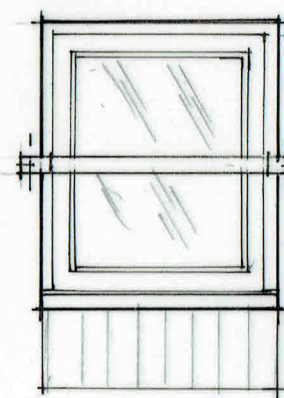

5x40mm FLAT METAL RESTRICTOR PAINTED GREY/GREEN TO MATCH WINDOWS, SECURED TO WALL

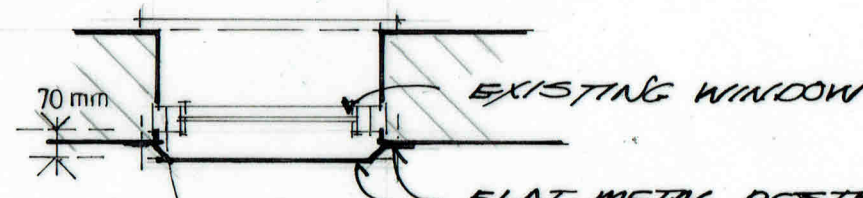

EXISTING WINDOW

FLAT METAL RESTRICTOR SECURED TO WALL

PLAN

SCALE 1-20 AT A3

SCALE 1-100 AT A3

window detail added
D 18Dec23 Elevation and

No.	DATE	REVISIONS

CLIENTS MUST TAKE THEIR OWN ASSURANCES ON

1. Soil conditions including gradient of land.
2. Suitability of storm water drainage.
3. Position of main sewer (if applicable)
4. Trees and their effect on foundation design

WE CANNOT BE RESPONSIBLE FOR ANY ADDITIONAL BUILDING COST FOR PROBLEMS CAUSED BY THE ABOVE OR OTHER PROBLEMS RELATED TO A PARTICULAR SITE.

EXTENSIONS ARE SUBJECT TO REVISION DEPENDING ON EXISTING STRUCTURE AS EXPOSED. ALL DIMENSIONS TO BE CHECKED ON SITE.

COPYRIGHT This design is the copyright of Glyn Doughty Design and may not be reproduced without written consent.

Glyn Doughty Design

25 VICARAGE HILL
WESTERHAM
KENT TN16 1TL

CLIENT Mr P. Beckingham

Malus Cottage, Church Road,
Lamberhurst. TN3 8DU
FLOOR PLANS (As Built)

DO NOT SCALE THIS DRAWING

SCALE 1-100 1-20

DRAWN G.T.D	DATE 1 Sep 23
-------------	---------------

DRAWING No	revision
------------	----------

180168-P-350	1/D
--------------	-----

Job. N° BP 2306