
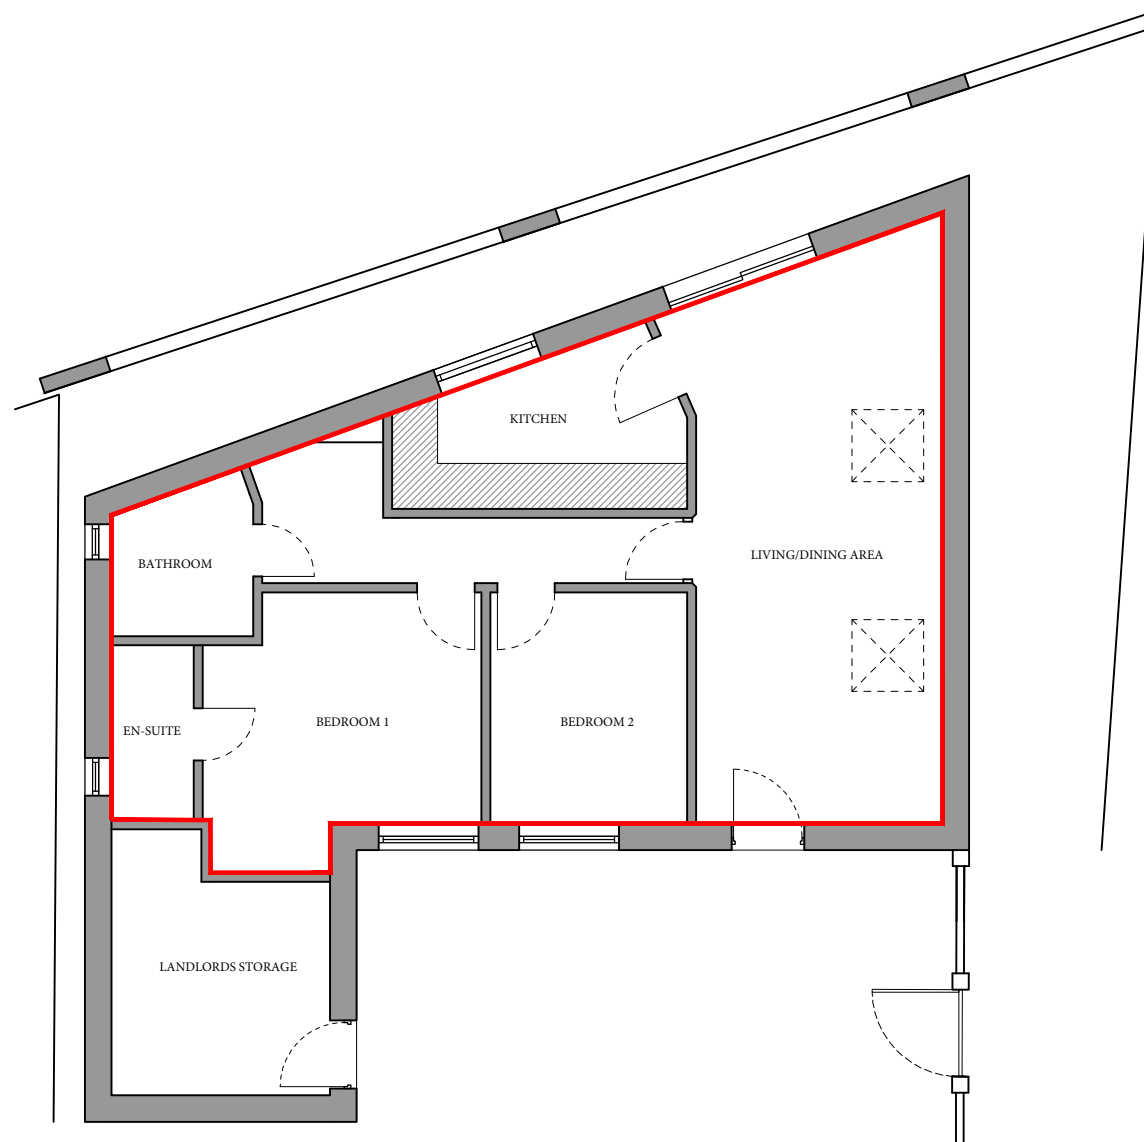


**SITE LOCATION PLAN**

Scale @ 1/1250

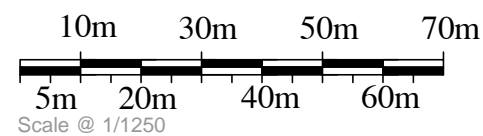


**AS-BUILT PLAN**

Scale @ 1/100


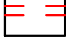
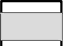
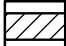
**GENERAL NOTES**

1. Do not scale this drawing for Construction purposes.
2. All dimensions in this dwg. are metric.
3. This drawing shall be read in strict conjunction with all other relevant architectural, structural engineer's & services engineer's drawings, calculations, details & specifications.
4. The contractor shall check all dimensions & setting out information on this or other related drawings prior to placing work in hand. Any errors or discrepancies between documents shall be reported to Forward Architecture & seek clarification.
5. All proprietary products shall be used & fixed in strict accordance with manufacturers' printed recommendations, notes, specifications etc.
6. Only drawings stamped "ISSUED FOR CONSTRUCTION" shall be used on site.
7. This drawing & all other drawings & schedules, specifications, details etc. relating to this project are copyright of Forward Architecture.

**RIBA**   
Chartered Practice

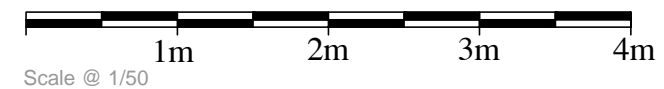

**Key:**

-  - Existing structure
-  - Demolished construction
-  - Proposed structure
-  - Surrounding buildings

...			

Revisions

**ForwardArchitecture**  
020 8123 9086  
info@forwardarchitecture.co.uk  
www.forwardarchitecture.co.uk

Project: 11B Court Yard  
Eltham, London  
SE9 5PR

Title: AS-BUILT PLAN AND SITE LOCATION PLAN

Scale: As Indicated on A2 | Drawn by

Date: | Checked

Drawing Number: 1808\_12-00 | Revision