




**SOUTH WEST ELEVATION - 1:100**

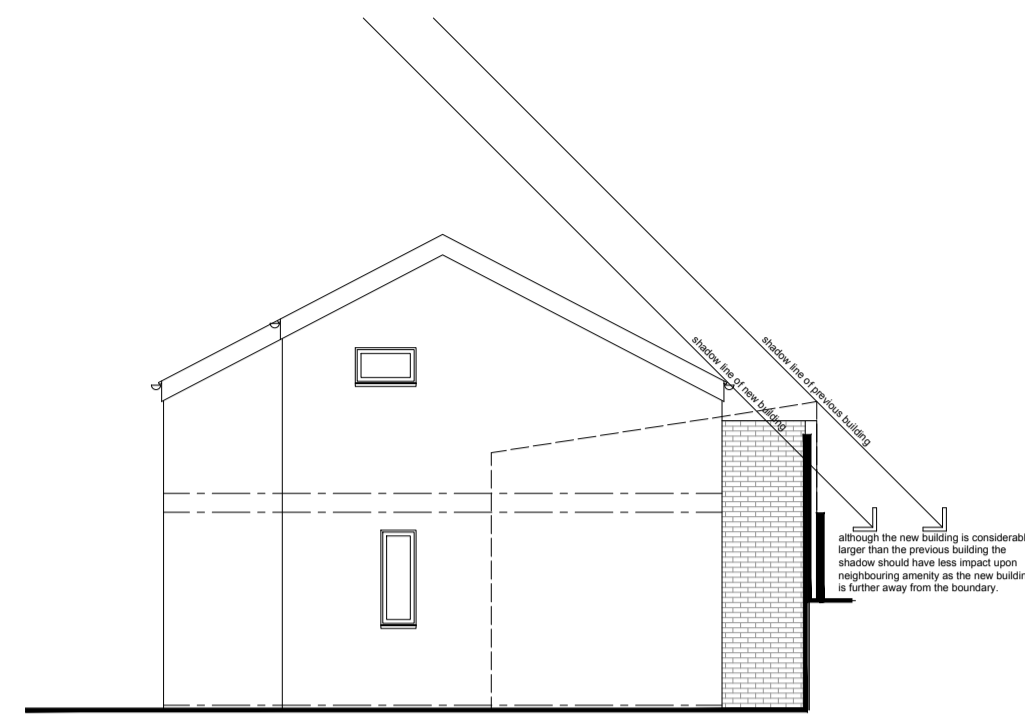


**SOUTH EAST ELEVATION - 1:100**

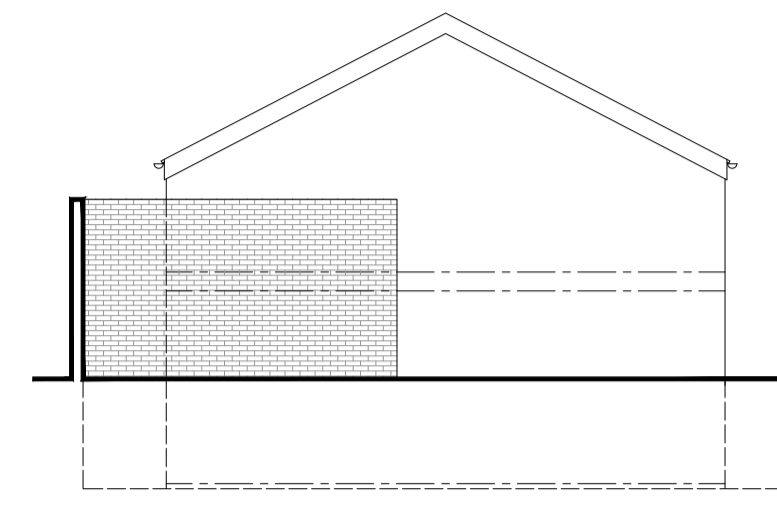


**NORTH WEST ELEVATION - 1:100**

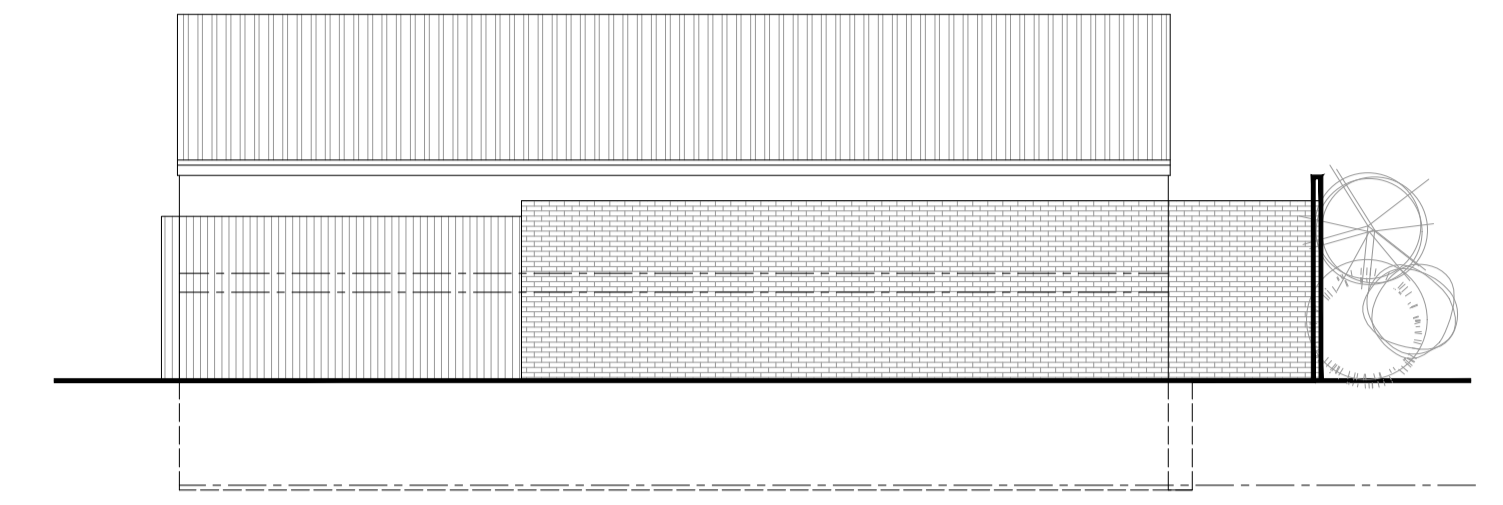


**NORTH EAST ELEVATION - 1:100**

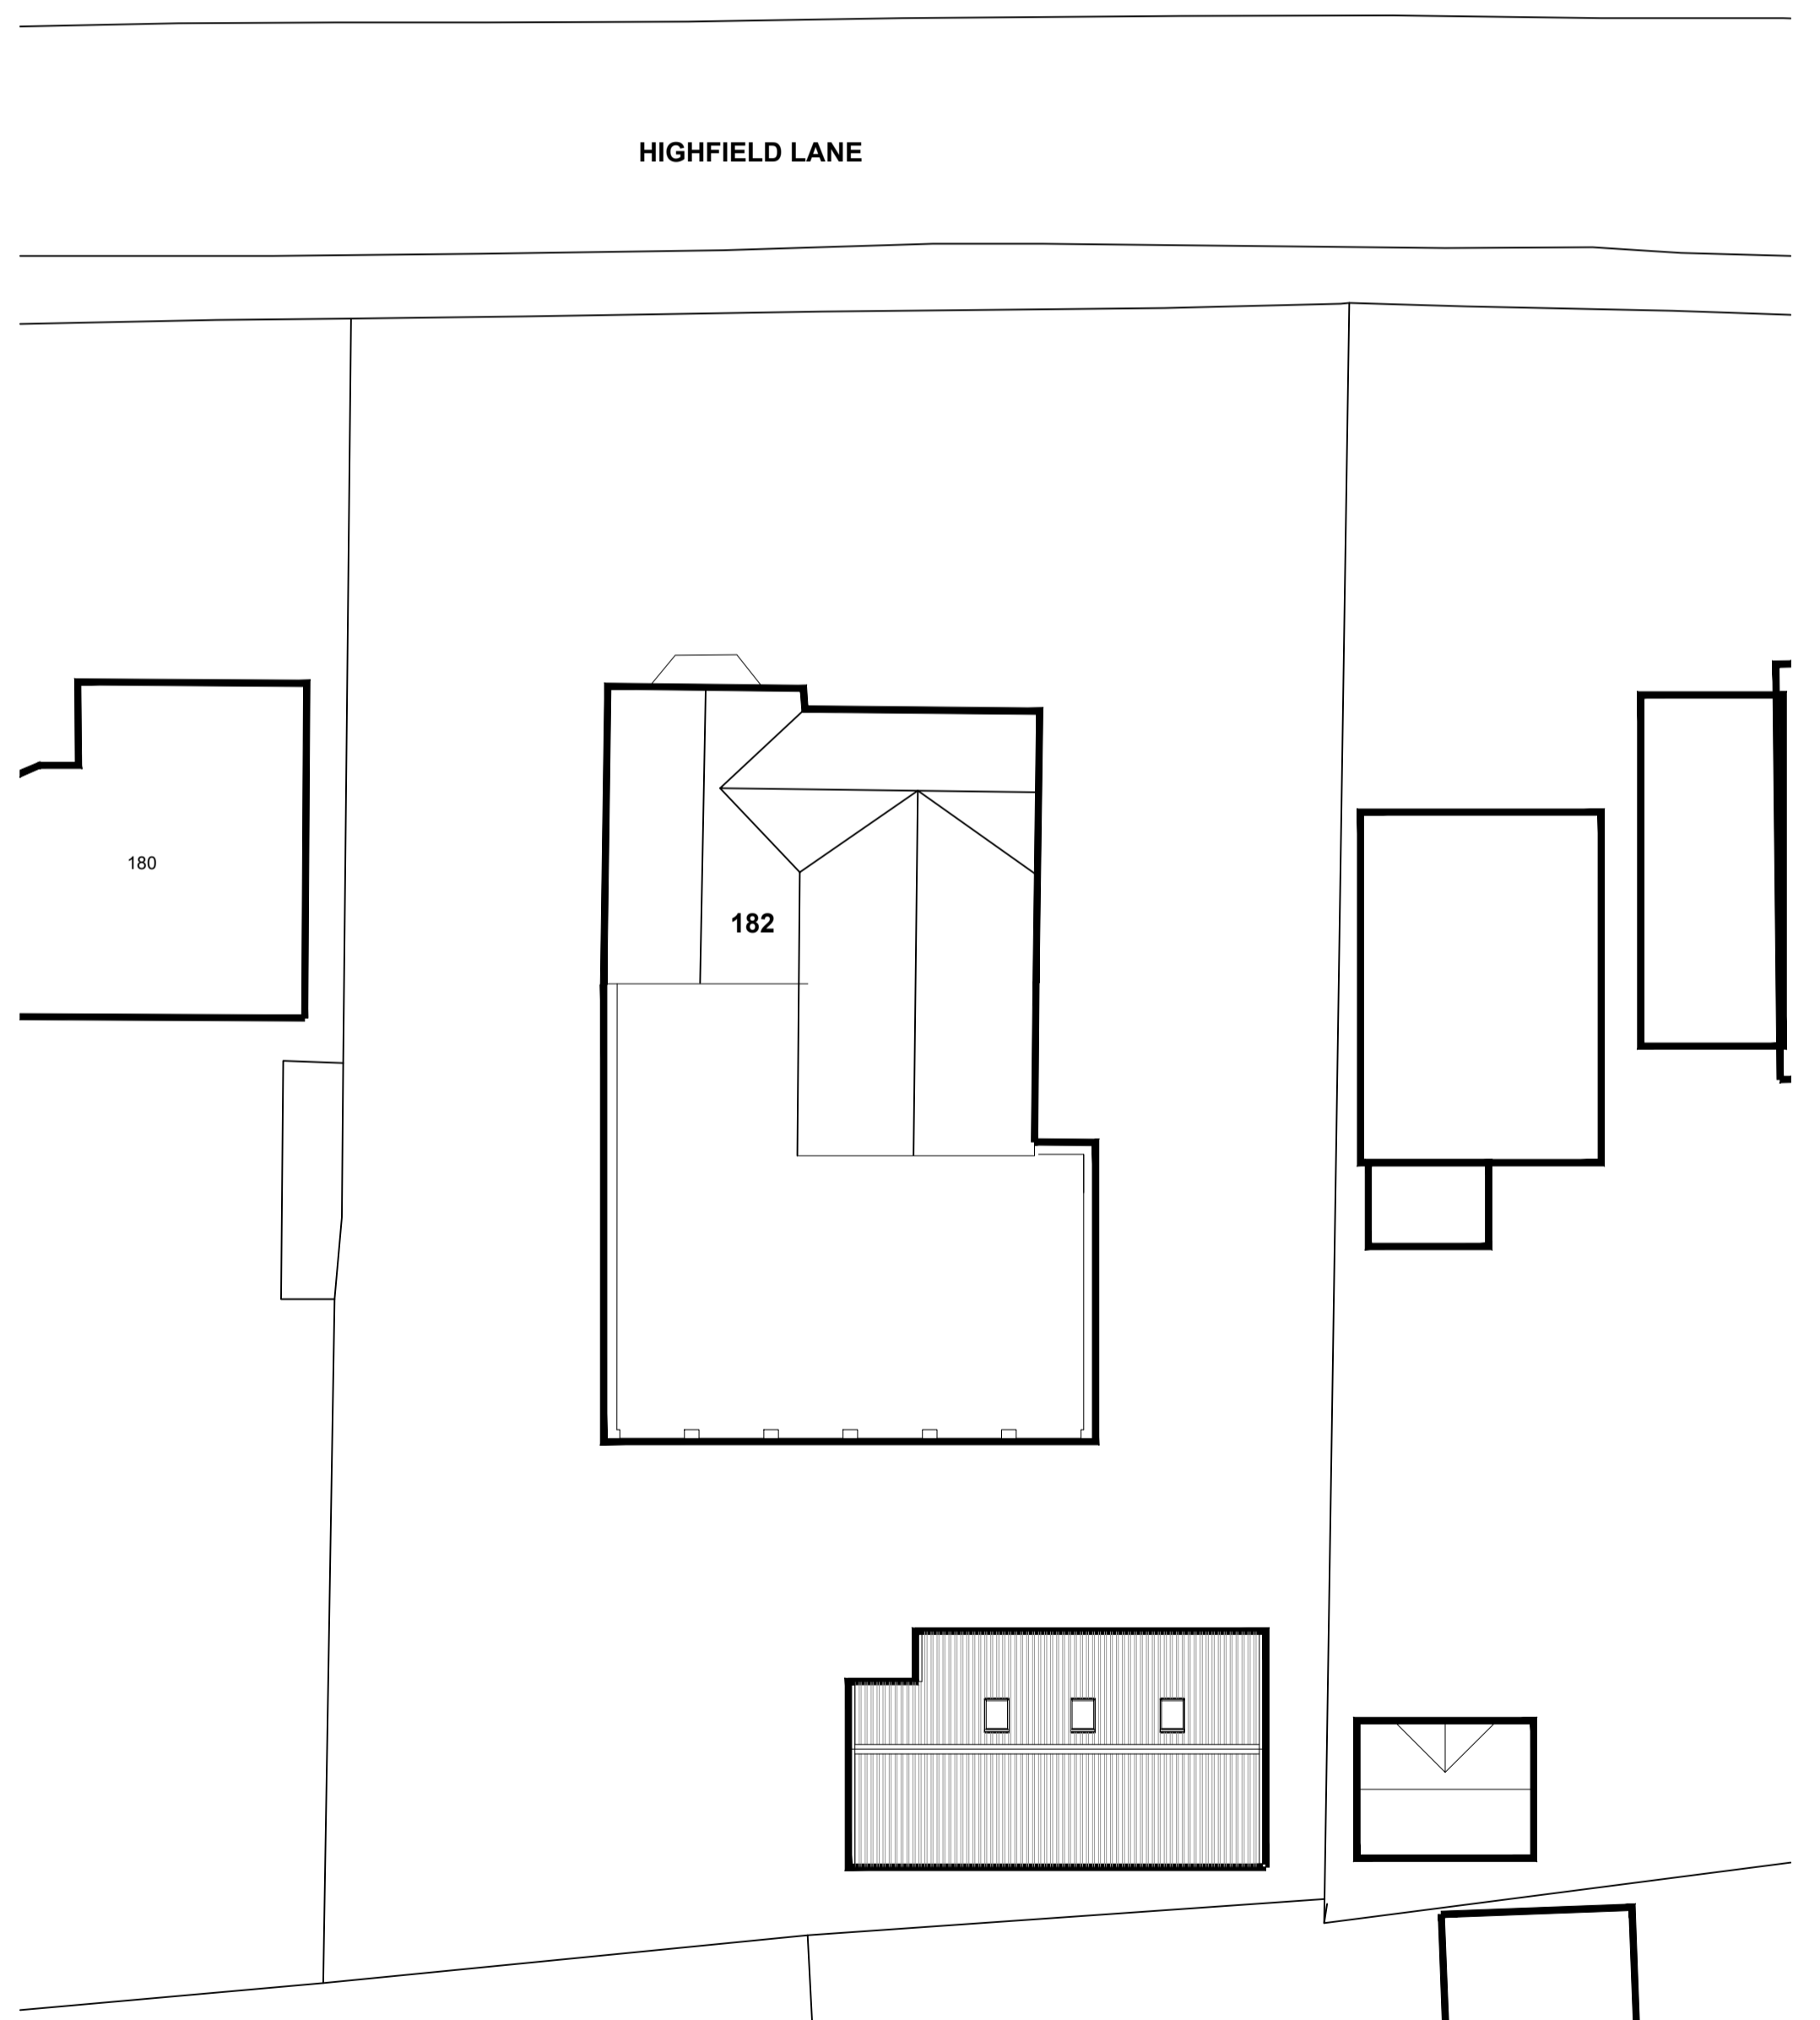


**ROOF/ SITE PLAN - 1:200**

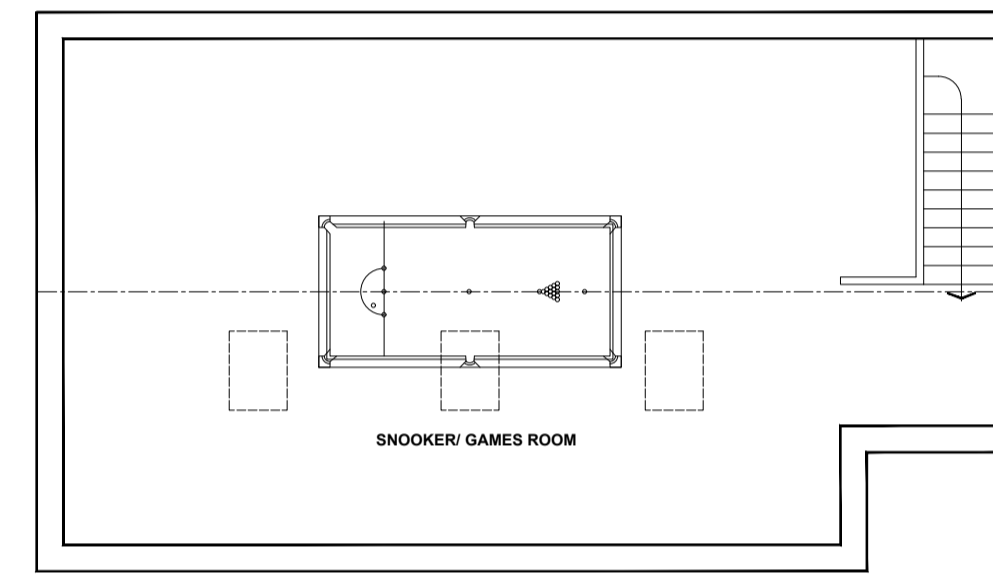

**FIRST FLOOR PLAN - 1:100**

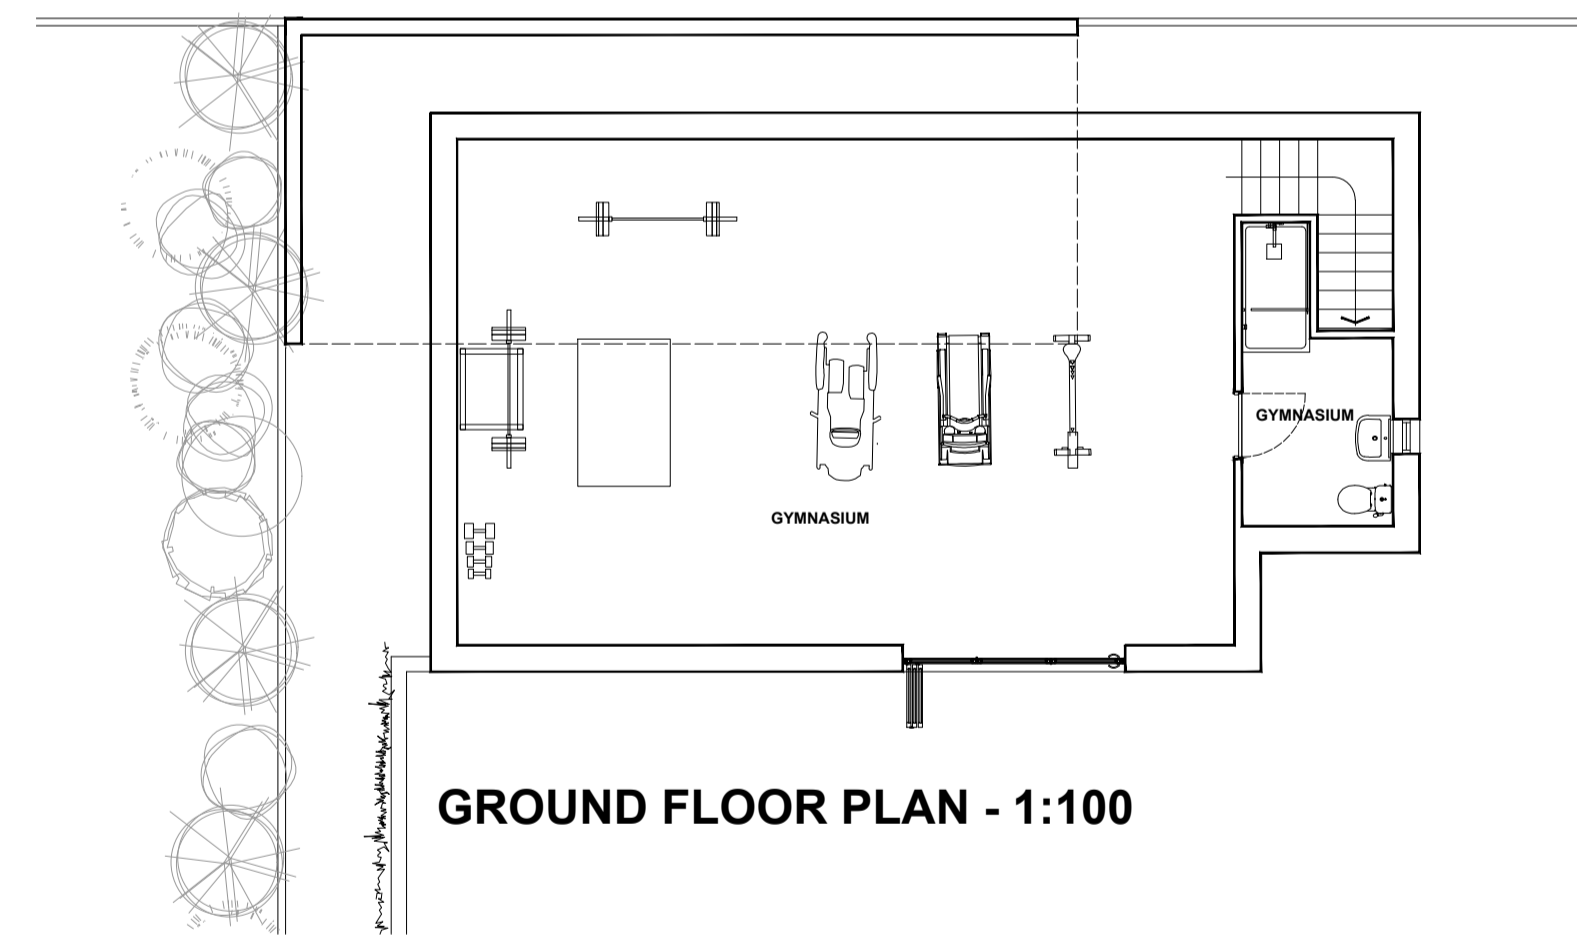

**GROUND FLOOR PLAN - 1:100**

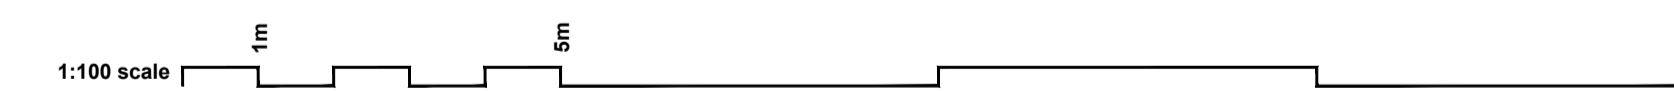

**MATERIALS**

WALLS	white render
ROOF	trapezoidal steel sheet
WINDOWS	grey upvc
DOORS	grey upvc
GUTTERS DOWNPIPES	Black upvc

002

A1 03/2024 11

Site/Roof Plan,  
Floor Plans,  
Elevations,  
As Built

Retrospective Planning Application

**REPLACEMENT ANCILLARY BUILDING**  
**182 HIGHFIELD LANE**  
**KEIGHLEY**  
**BD21 2HU**

1:100  
1:200

