



NOTES
 Contractor must verify all dimensions on site before commencing any work or shop drawings.
 Report any discrepancies before commencing work to ARCHITECTURE 1B. If this drawing exceeds the quantities taken in any way, the architects are to be informed before the work is initiated.
 Only figured dimensions to be taken from this drawing. Do not scale off this drawing.
 Drawings based on Ordnance Survey and/or existing record drawings - design and drawing content subject to Site Survey, Structural Survey, Site Investigations, Planning and Statutory Requirements and Approvals.
 Work within the Construction (Design & Management) Regulations 2007 is not to start until a Health & Safety Plan has been produced.
 This drawing is Copyright and must not be reproduced without consent of ARCHITECTURE 1B Ltd.

Rev. Description Drawn Date Ch/led Date

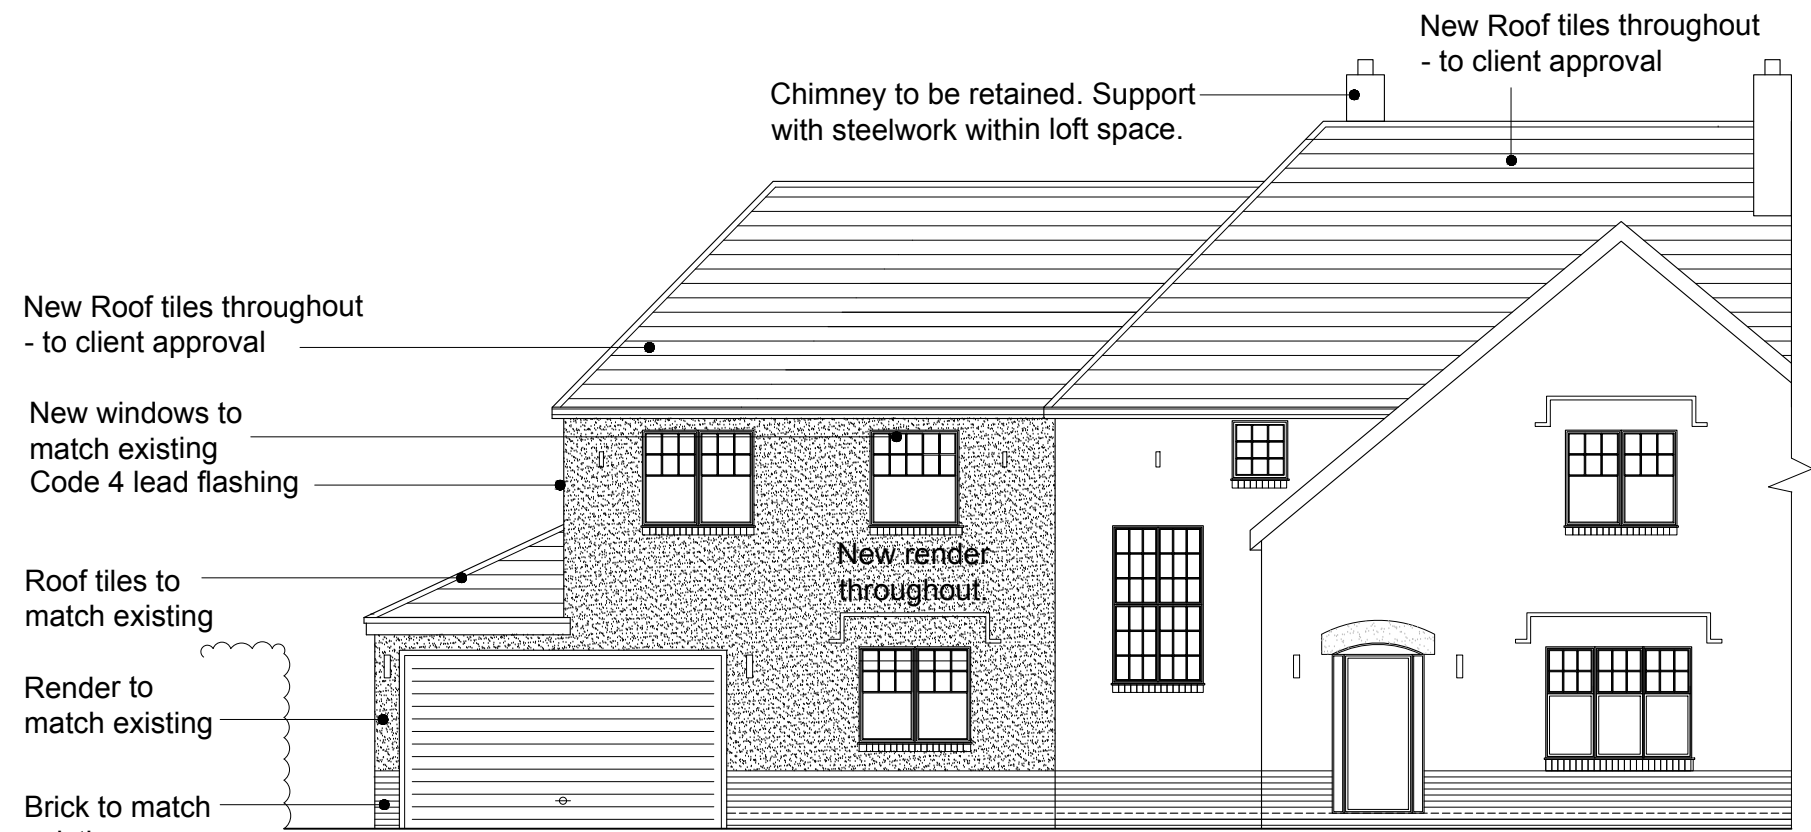

Proposed Front Elevation 1:100

Match Brick Slips to the new brick plinth and use to overclad the existing brick plinth. Whole house to be rendered. New renderstop to suit brick slips.

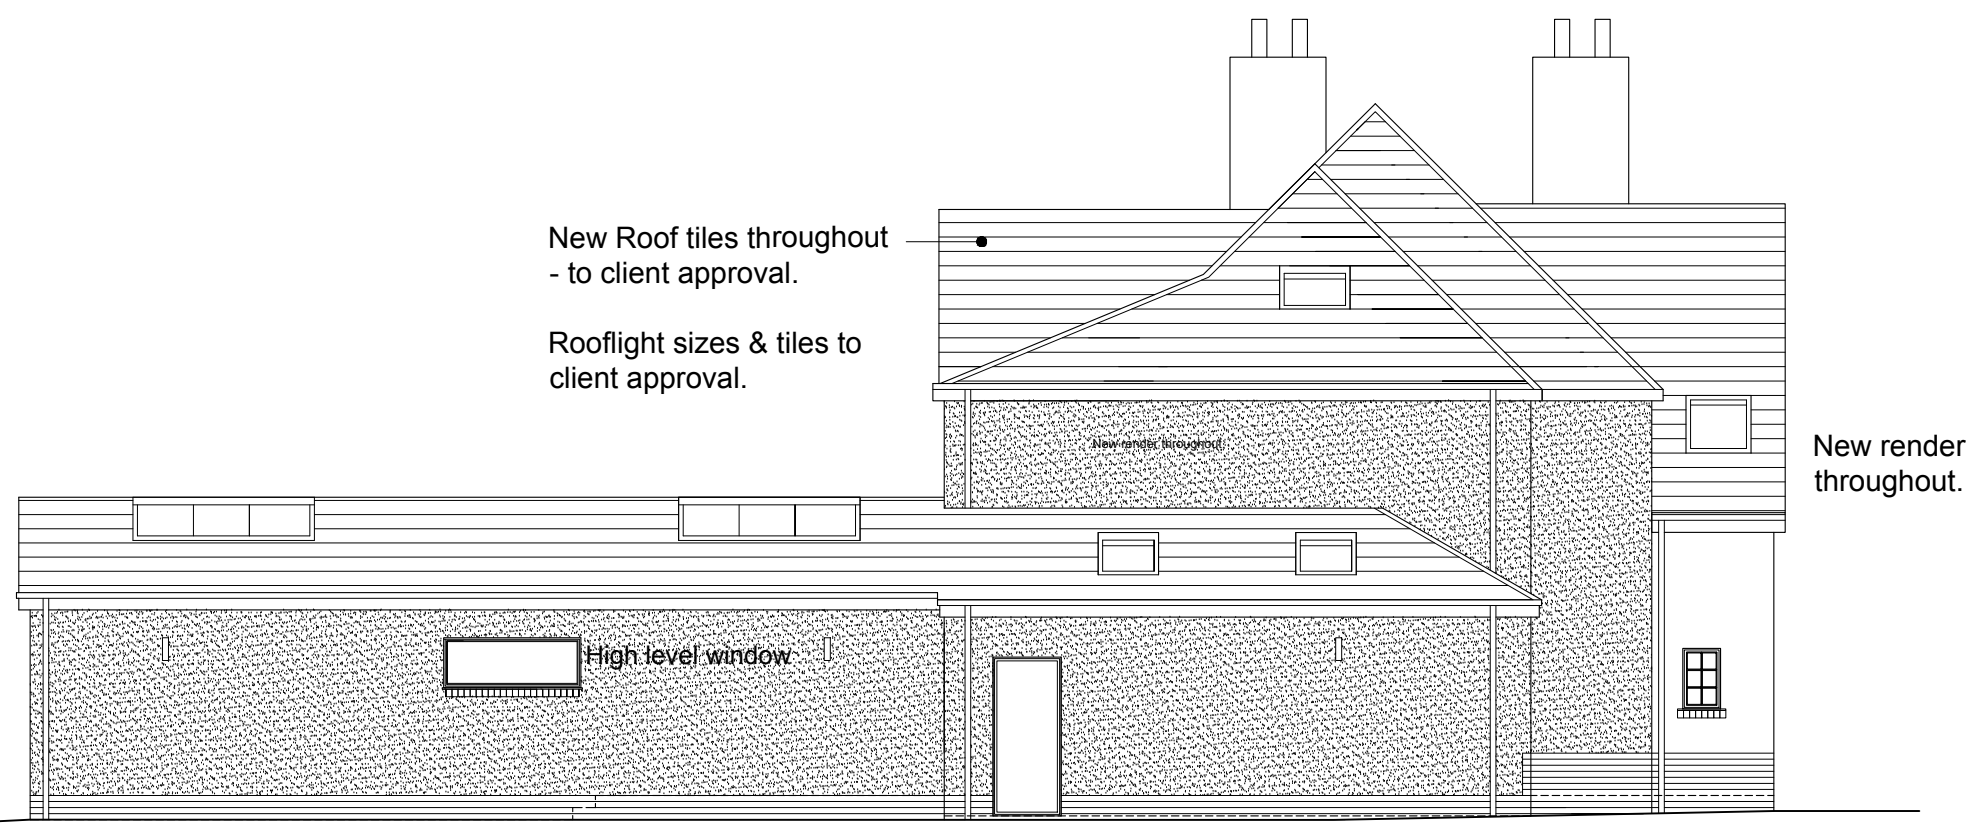

Existing Side Elevation 1:100

ARCHITECTURE 1B

Project
 48 Spofforth Hill,
 Wetherby, LS22 6SE

Drawing Title:
 Elevations 1 of 2
 As Proposed

Scale: Date: Drawn: Checked:
 1:100 @ A3 Feb 24 MS

Drawing Number: Revision:
 2024-703-012 B