



- General Notes:**
1. Do not scale from this drawing.
 2. All dimensions in metres.
 3. All levels relate to ordnance datum.
 4. This drawing is based on the latest architectural planning layout and shall be read in conjunction with all other relevant longitudinal sections and construction drawings.
 5. Any discrepancies with any of the drawings shall be reported to MJA Consulting Engineer.

KEY:

Existing levels	XXX.XXX
Design Levels	XXX.XXX
As-Built levels	XXX.XXX

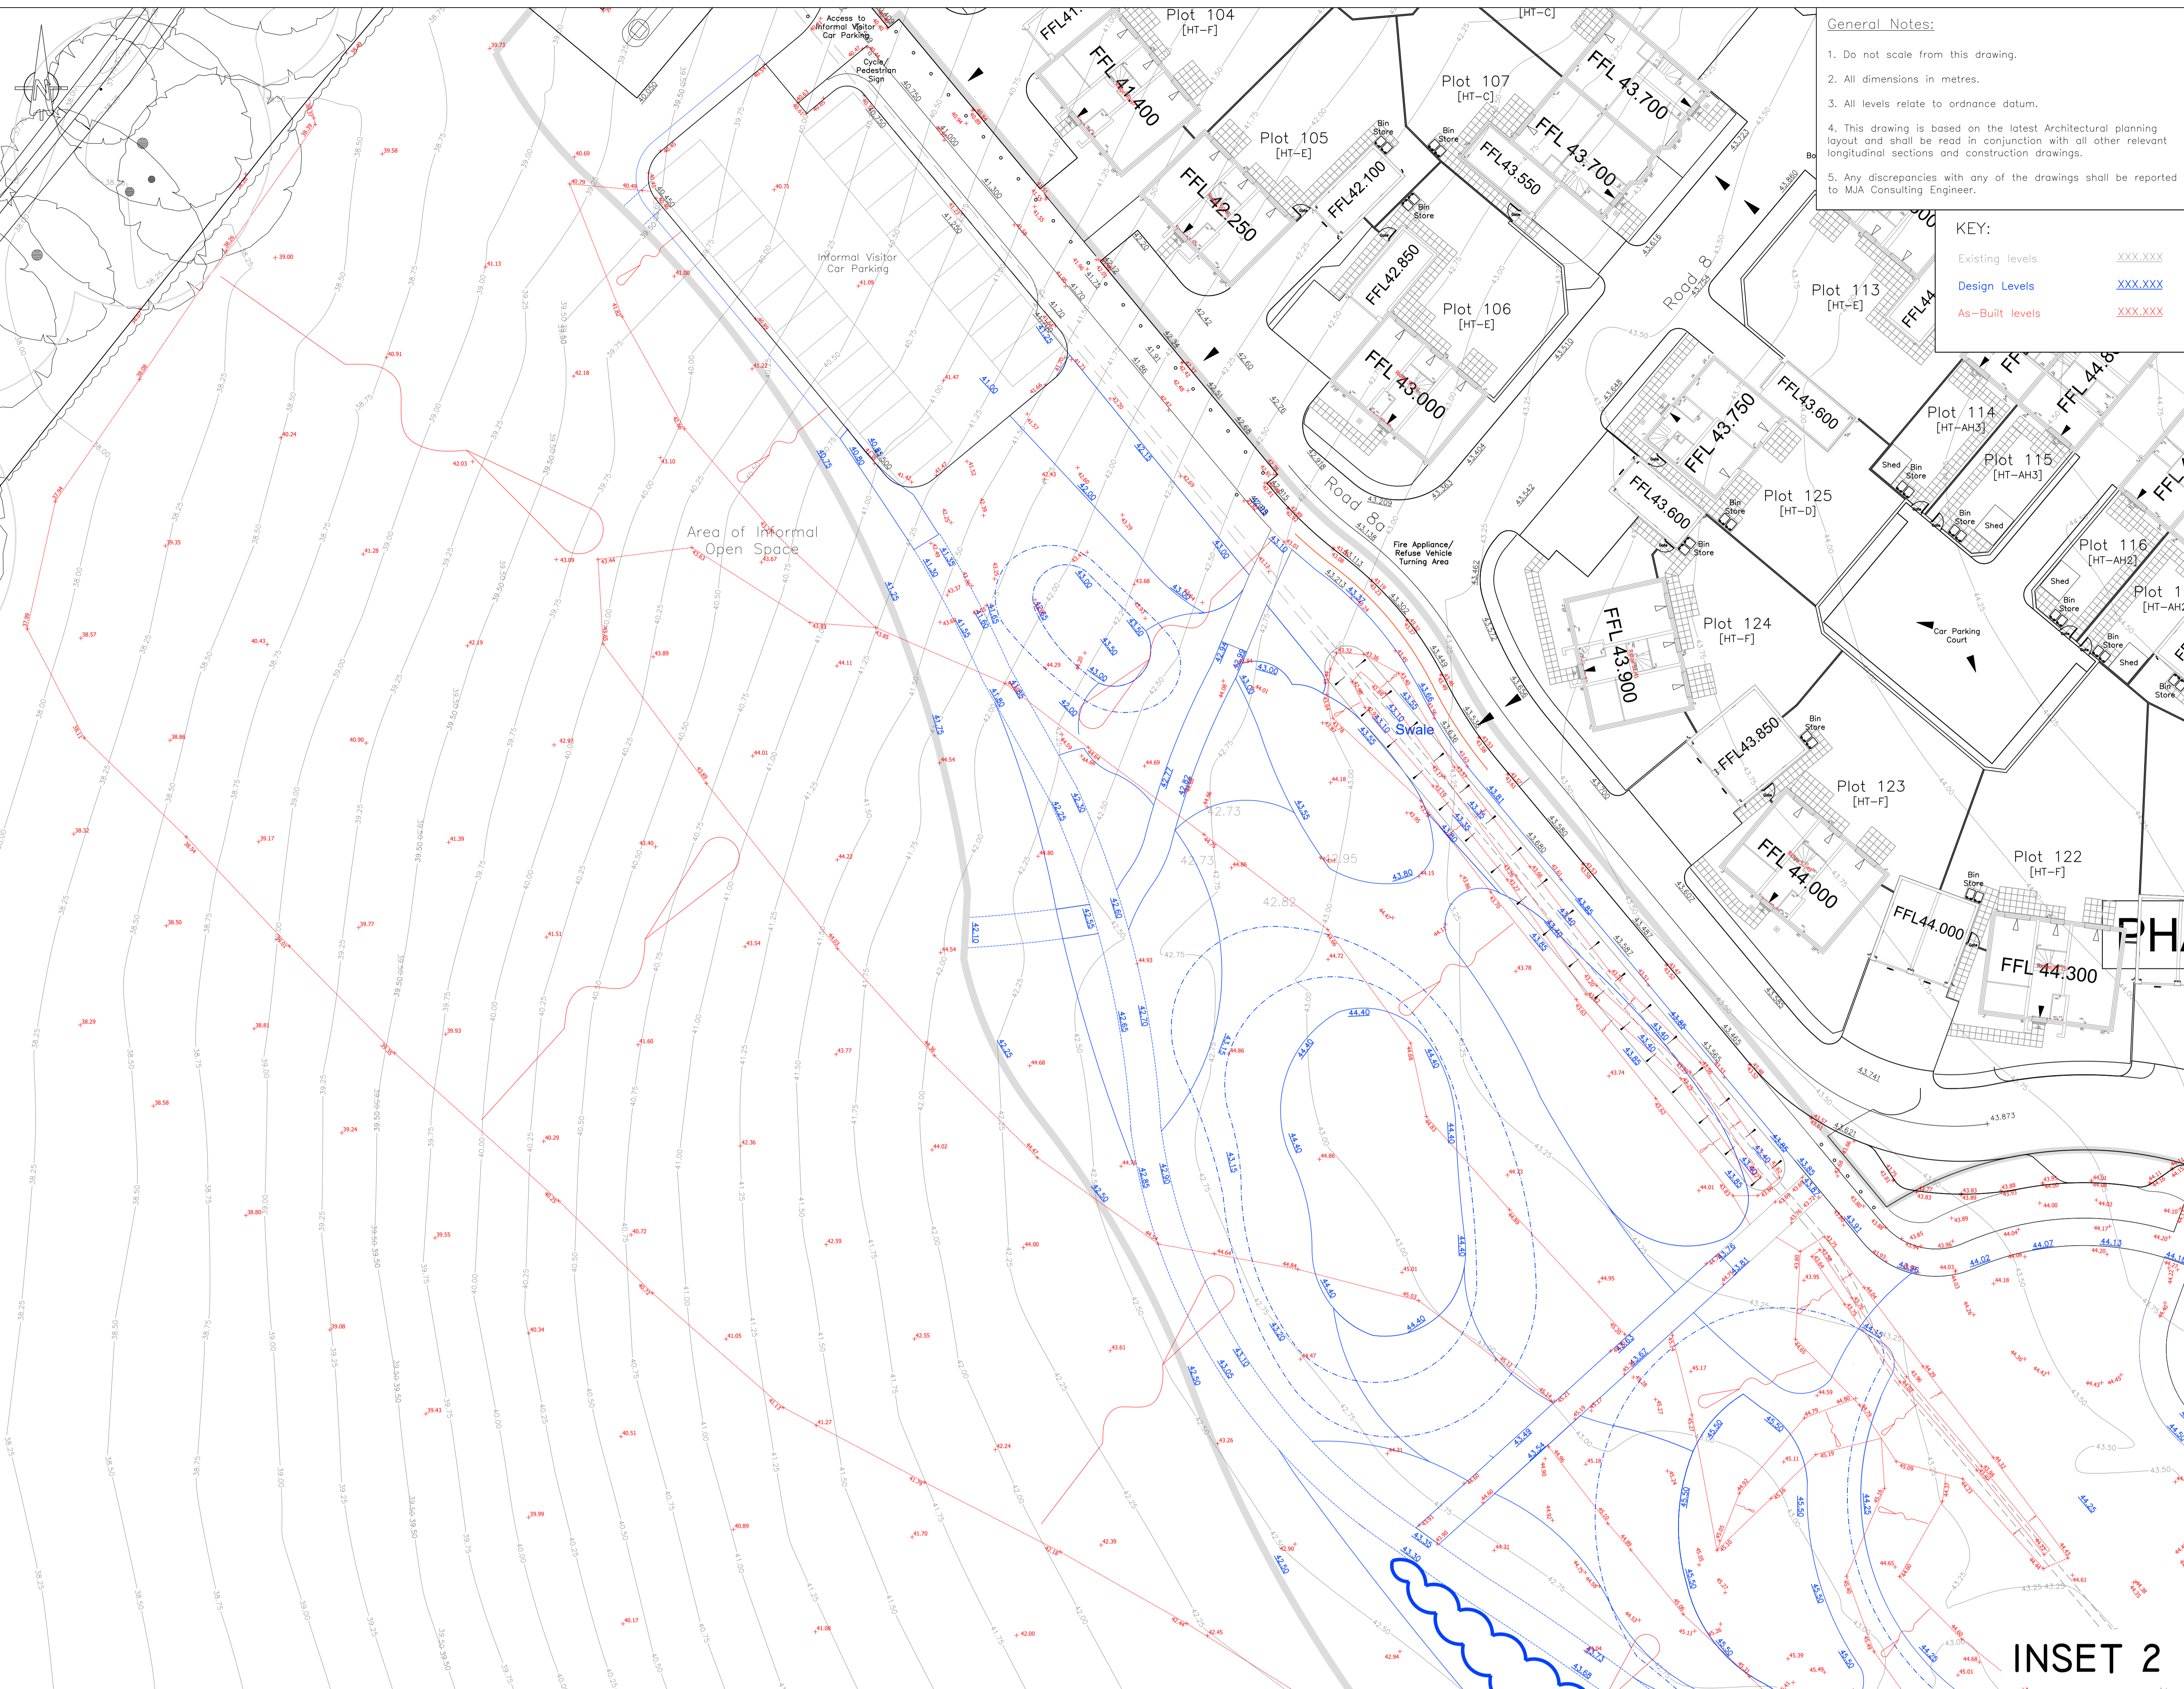

INSET 2

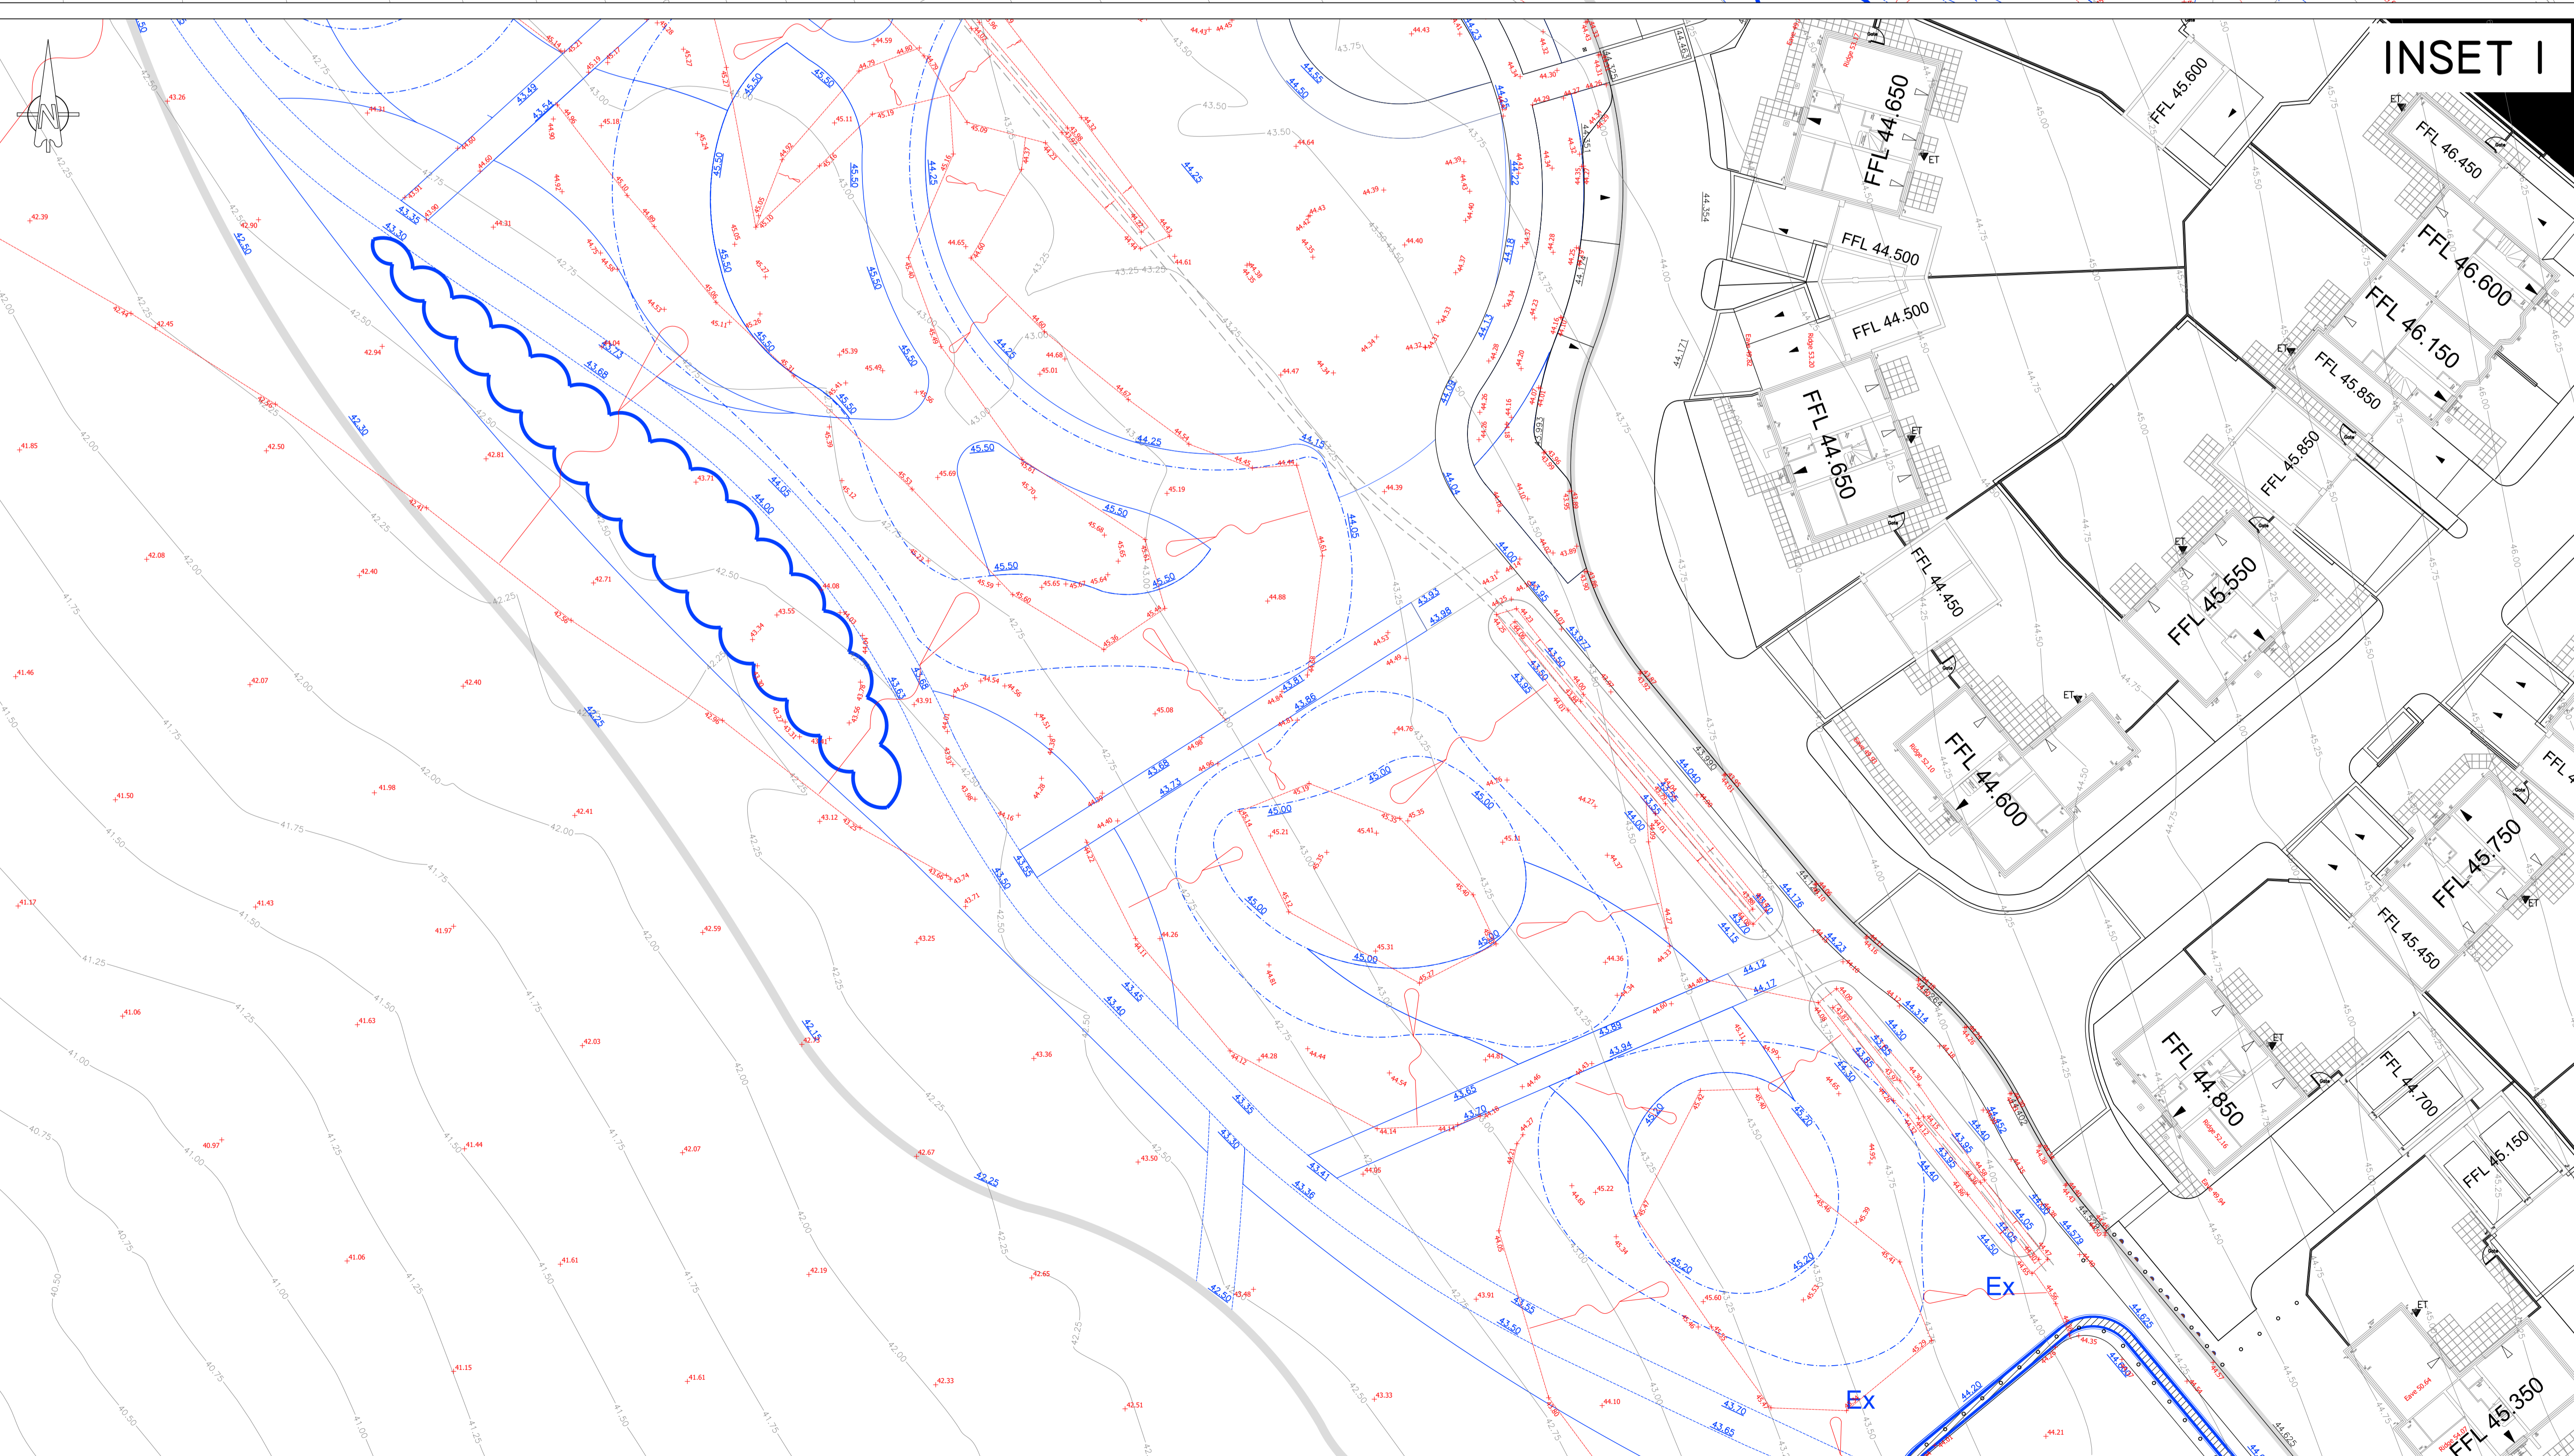

INSET 1

FOR INFORMATION ONLY

REV. No.	DATE	DESCRIPTION	INITIALS
P1	23.03.23	First Issue	NL

Client: **BARGATE HOMES**

Project: Phase 2 Albany Farm Bishop's Waltham

Title: As-Built and Design Bund Levels Overlay

Scale: 1:250 @ AO

Date: May 2023

Drawing No: 6156:805

Rev: P1

MJA CONSULTING CIVIL & STRUCTURAL ENGINEERS
 Ipsium Court, 24 The Quadrant, Abingdon Science Park, Oxon, OX14 3YS
 Tel: 01235 555173 Fax: 01235 532226

Checked: JRV Drawn: NL

This drawing is the copyright of MJA Consulting Engineers Limited. It may not be copied, altered or reproduced in any way without their permission.