


Existing floor plan 1:50@A2

Ex

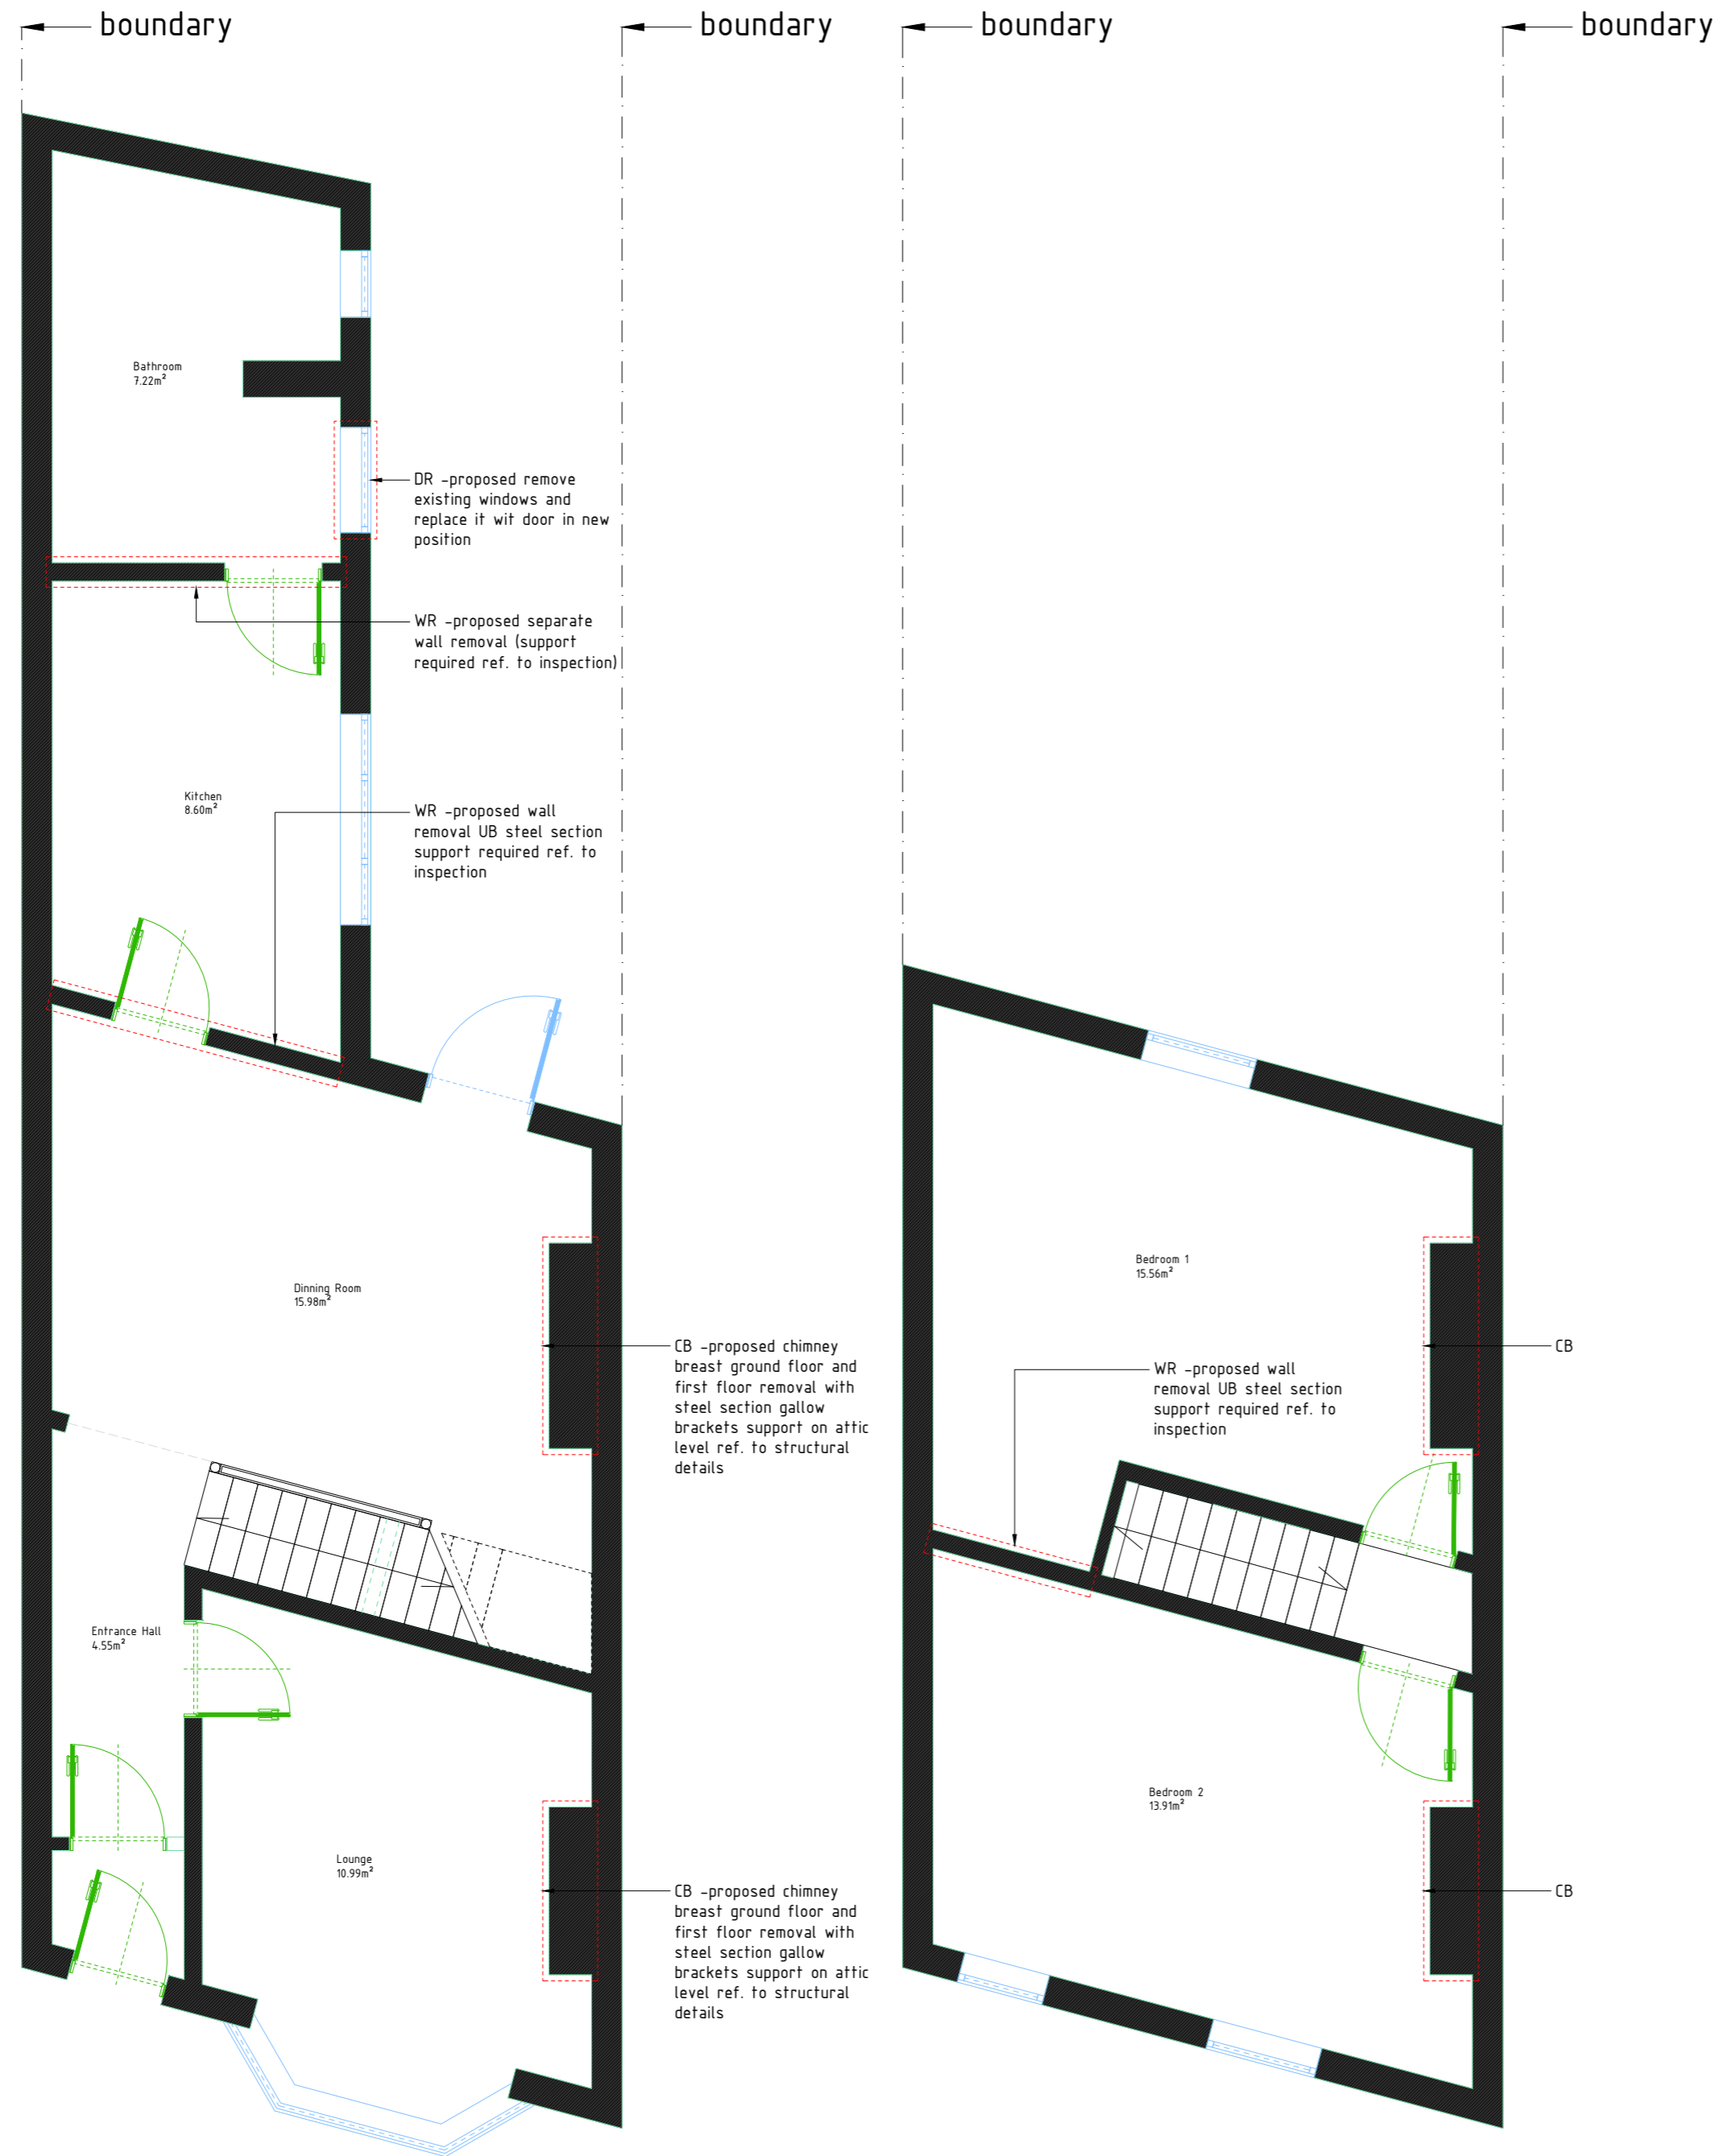

all dimension to be site checked by the constructor prior to procuring the materials and the site works etc. Temporary props to be designed and maintained by the contractor.

Revisions	Date	Approved

Notes:
 THIS DRAWING IS TO BE CHECKED & VERIFIED BY THE CONTRACTOR PRIOR TO WORK COMMENCING ON SITE & ANY DISCREPANCY OR QUERY SHALL BE IMMEDIATELY REPORTED & RESOLVED BEFORE PROCEEDING WITH CONSTRUCTION.

DRAWING DESCRIPTION:	Existing floor plan
SITE:	138 Hull Rd, York, YO10 3LQ
CLIENT:	Ms Joanna Jozwiak Mr Radek Jozwiak
DATE: 21/02/2024	DWG NO: 138R_EFP_02_24
SCALE: 1:50 (as noted @A2)	DRAWN: T.Zabney

This design remains copyright to Teneo Zaprawy. Changes should be agreed with the designer. Please check you are working off the most recent version of the plan. It is the responsibility of the crew members to ensure they are installing this as the appropriate safety procedure. The designer is not responsible for the safety of the installation or stability. It is strongly recommended to verify all measurements on site. This drawing has been produced for planning purposes only and should not be used for any other purpose. This drawing may be subject to amendments without written approval. From Local Authority, upon submission, every drawing is deemed to be an 'as built' drawing unless confirmed by final inspection check. WWW.TENOEPLAN.CO.UK

Notice: for building regulation submission only, not for ordering materials. Principal Contractors is responsible for taking measurements on site, prepare construction drawings and safety erecting the proposed structural works.