


Notes


1. No Dimensions are to be scaled from this drawing.
2. Contractors must verify all ground dimensions at site before commencing any work or making any site changes.
3. This drawing is the sole copyright of A Squared Architects Ltd and no part may be reproduced without their written consent.
4. Site Location Plans are prepared from the Ordnance Survey Map with the sanction of the Controller of H.M. Stationery Office. Crown Copyright Reserved.

No.	Revision	By	Date

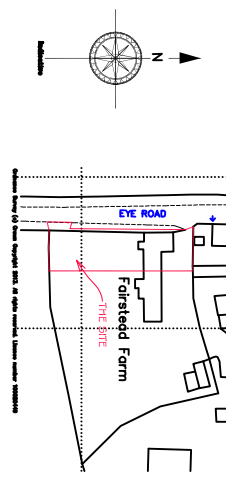


SITE LOCATION
1:1/250

SOUTH ELEVATION

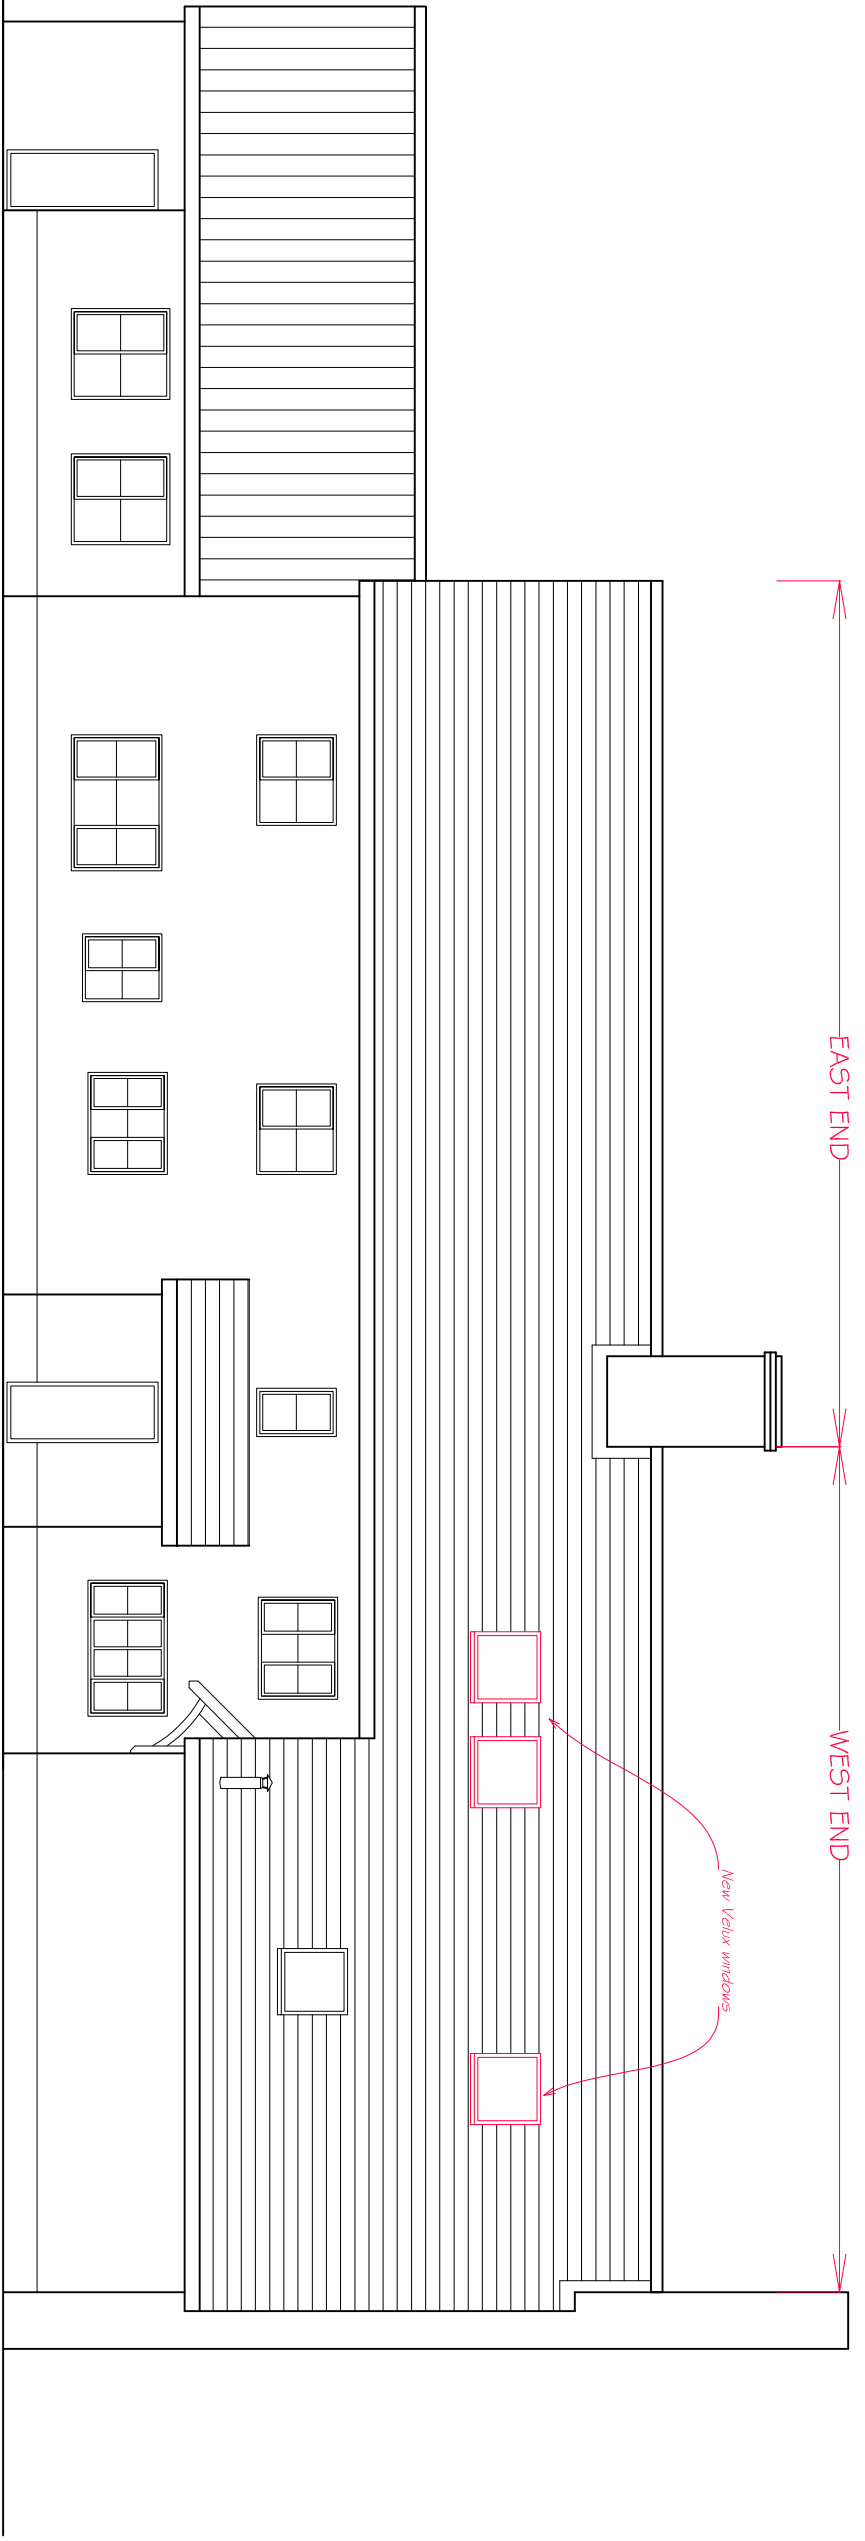

NORTH ELEVATION

1/50 scale

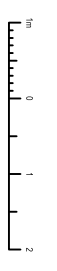

architectstwo
8 LAMBETH STREET
EYE IP23 7AG
Telephone: (01379) 871231
www.architectstwo.co.uk

Client
CARL ROBSON

Job
**FAIRSTEAD FARMHOUSE
EYE ROAD, HOXNE, SUFFOLK
ATTIC RECOVERY**

Drawing Title
**PLANNING APPLICATION
ELEVATIONS**

Scale
1:50/1/250 @ A1

Date	By	Rev.	Status
FEB 2024			<input checked="" type="checkbox"/> PRELIMINARY
			<input type="checkbox"/> PLANNING
			<input type="checkbox"/> TENDER
			<input type="checkbox"/> FOR APPROVAL
			<input type="checkbox"/> CONSTRUCTION
			<input type="checkbox"/> AS BUILT

AT / 27 / 02