




NOTE: Report all errors and omissions to the Architect. All dimensions to be checked on site before fabrication.


Contractors must verify all dimensions on site before setting out, commencing work, or making any shop drawings.

- All dimensions must be checked on site
- All setting out to be checked on site
- All levels must be checked on site and their datum confirmed
- This drawing must be read in conjunction with the relevant specification clauses
- This drawing must not be used for land transfer purposes

**ALTERATION WORKS LEGEND**

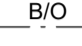-  Existing wall to be demolished
-  Existing opening closed up
-  New Beam Over (to S/Eng design & specification)

  
**IMPORTANT: Main contractor to ensure no element of the development oversails boundaries**

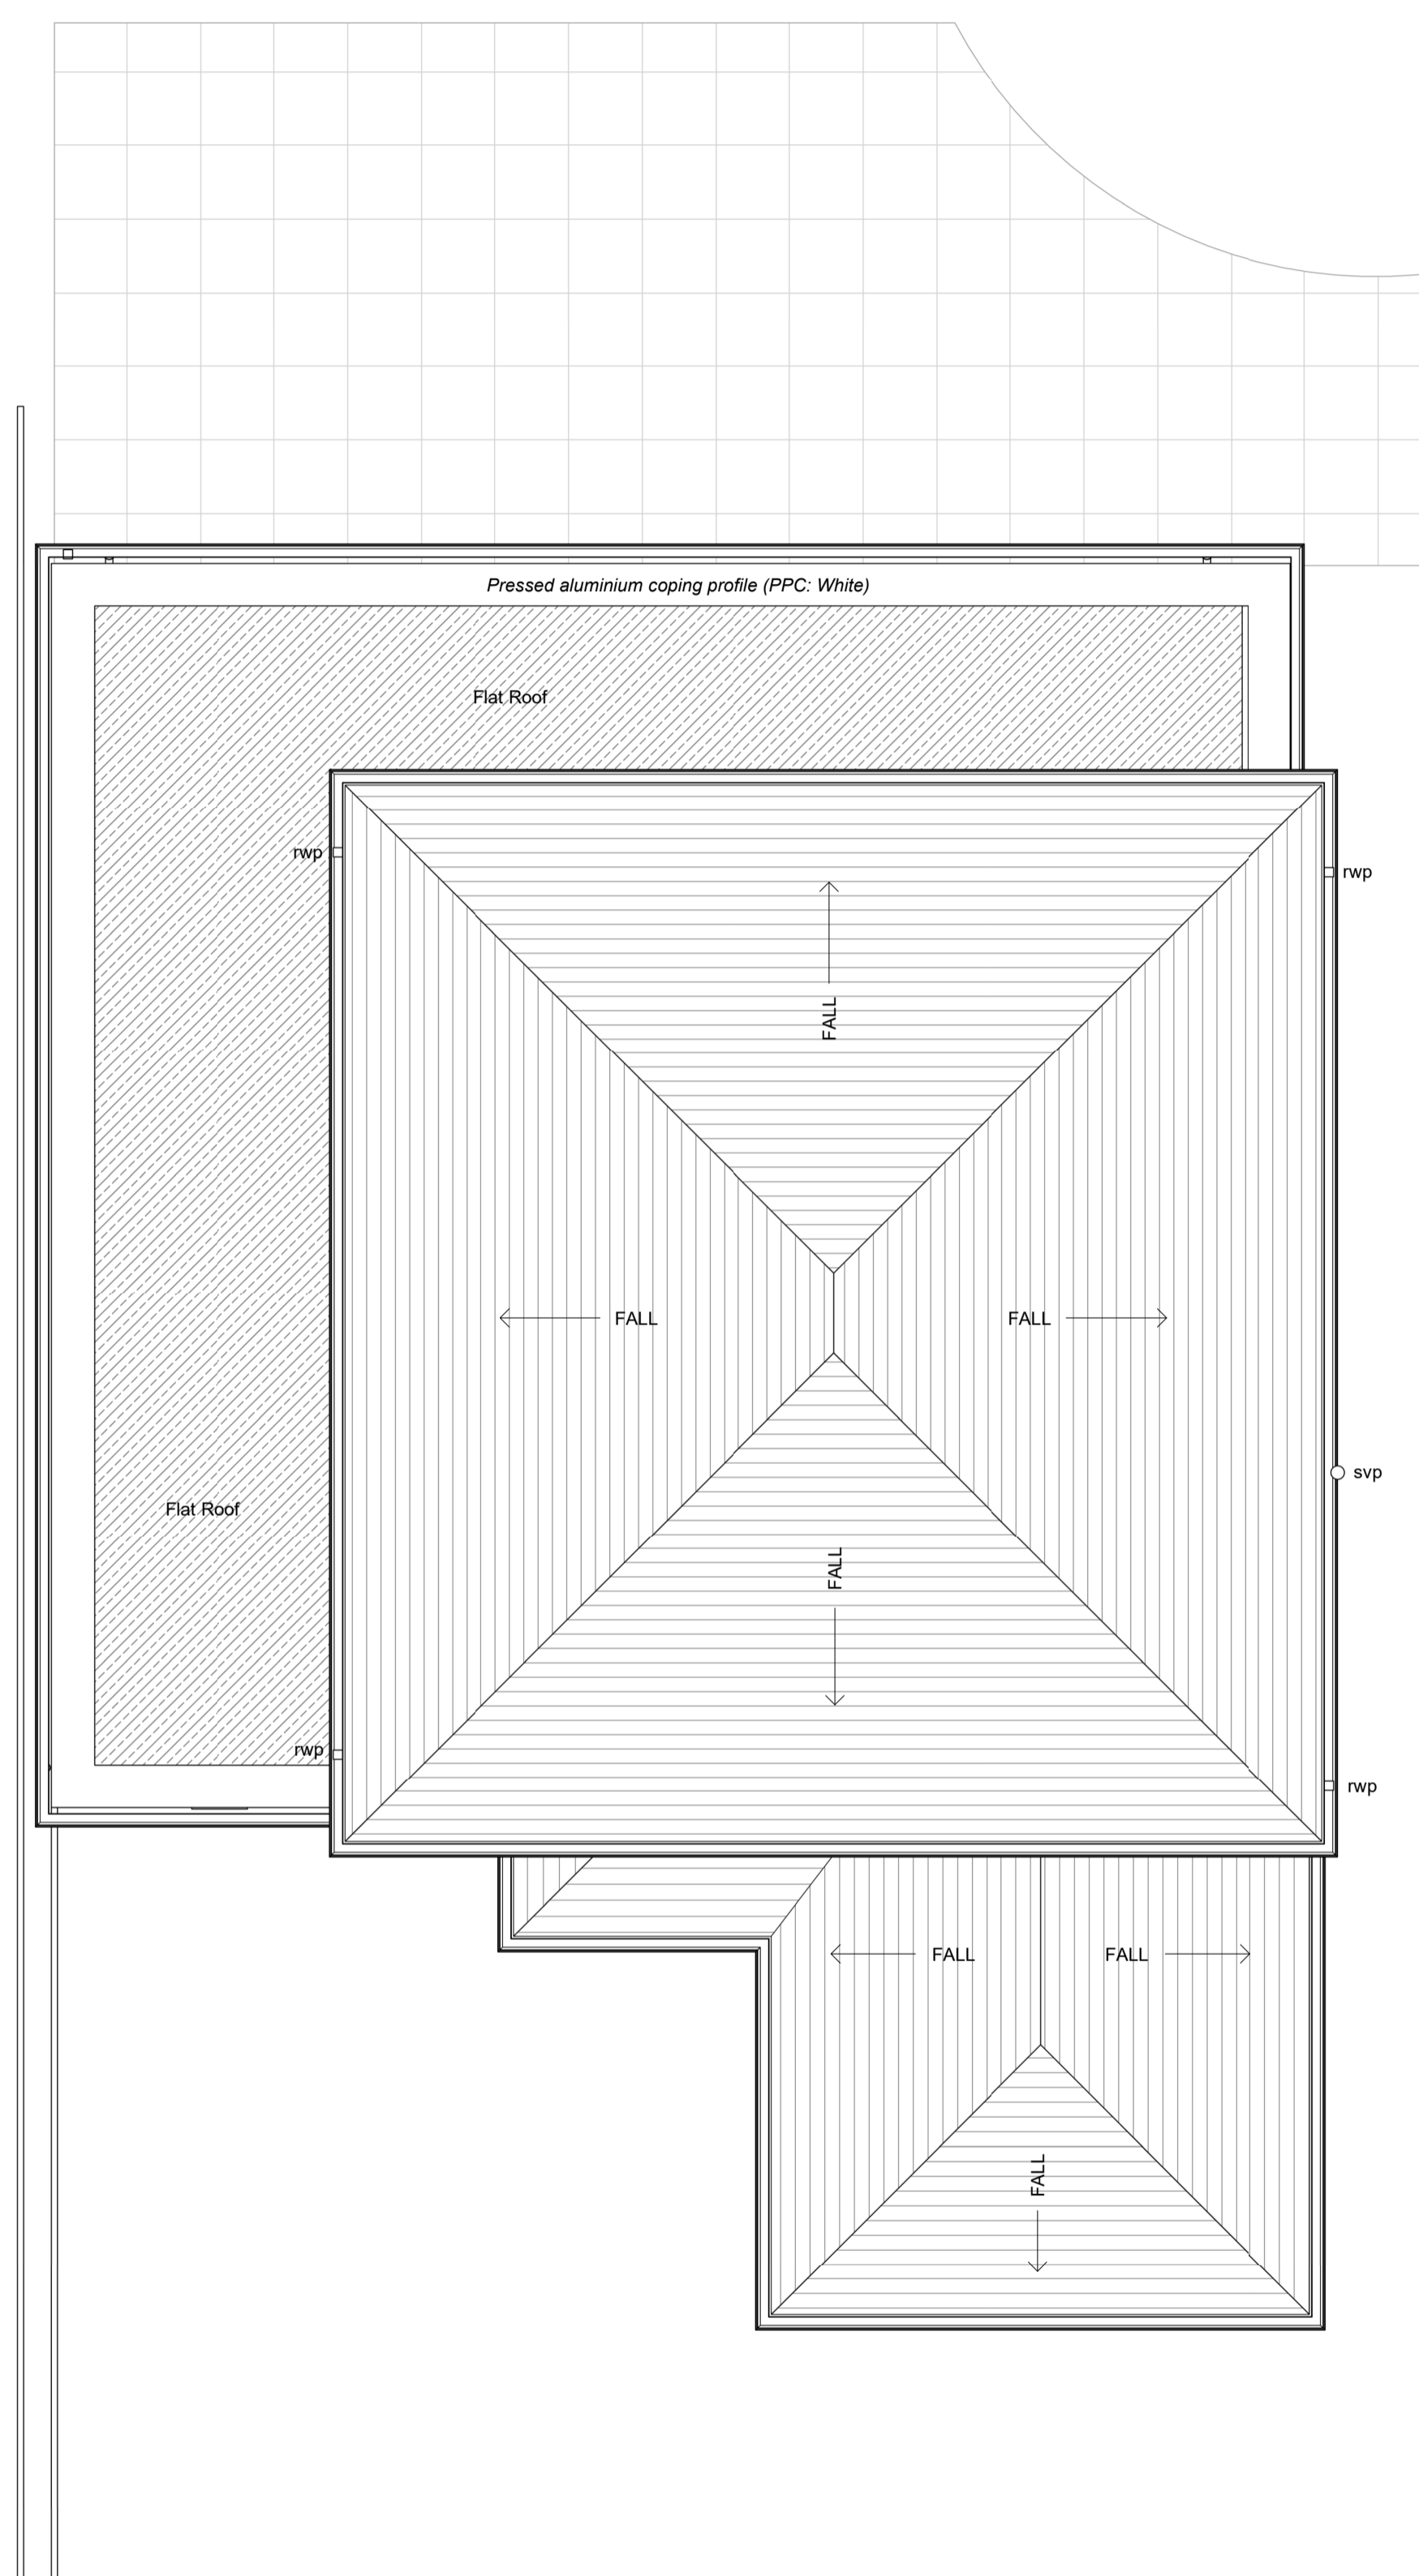

**Roof Level (PLANNING)**  
 1 : 50

|          |                                       |     |          |      |         |
|----------|---------------------------------------|-----|----------|------|---------|
| P4       | Planning Submission (as built scheme) | MAS | 05.03.23 | MAS  |         |
| P3       | Information Issue                     | MAS | 11.08.23 | MAS  |         |
| P2       | Scheme frozen + planning submission   | MAS | 10.08.23 | MAS  |         |
| P1       | Preliminary Issue                     | MAS | 23.06.23 | MAS  |         |
| Revision | Description                           |     | Drawn    | Date | Checked |

Client's Name  
**Redwood Realty**

Job Title  
**Foulis, Gold Cup Lane, Ascot**

Drawing Title  
**Proposed Roof Plan**

Scale  
**1 : 50 @A1**

Job No  
**1181**

Drawing No  
**201 (PA02)**




Status  
**PLANNING SUBMISSION**

Rev  
**P4**



Arena Business Centre  
 Abbey House  
 282 Farnborough Road  
 Farnborough  
 Hampshire  
 GU14 7NA

T| +44 (0)1276 402 433  
 M| +44 (0)777 208 3303  
 E| mike@ms4architects.co.uk

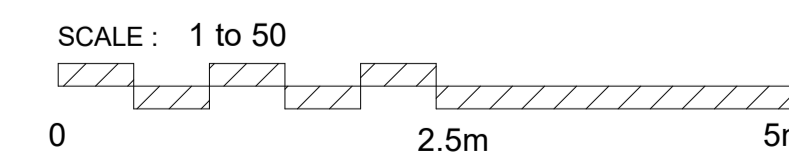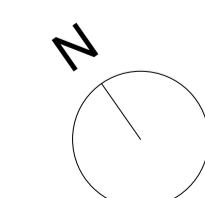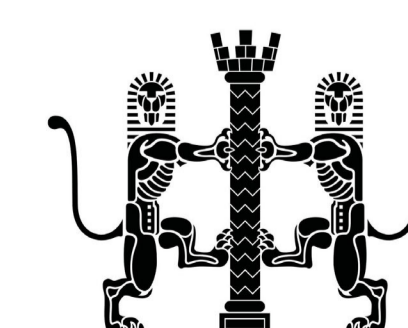

Note: This maybe a reduced sized print, check scales below