

NOTE: Report all errors and omissions to the Architect. All dimensions to be checked on site before fabrication.

Contractors must verify all dimensions on site before setting out, commencing work, or making any shop drawings.

- All dimensions must be checked on site
- All setting out to be checked on site
- All levels must be checked on site and their datum confirmed
- This drawing must be read in conjunction with the relevant specification clauses
- This drawing must not be used for land transfer purposes

ALTERATION WORKS LEGEND

- Existing wall to be demolished
- Existing opening closed up
- B/O New Beam Over (to S/Eng design & specification)

P4	Planning Submission (as built scheme)	MAS	05.03.23	MAS
P3	Scheme Revised to LPA recommendations (BM email 23/08/23)	MAS	23.08.23	MAS
P2	Scheme frozen + planning submission	MAS	10.08.23	MAS
P1	Preliminary Issue	MAS	23.06.23	MAS
Revision	Description	Drawn	Date	Checked

Client's Name
Redwood Realty

Job Title
Foulis, Gold Cup Lane, Ascot

Drawing Title
Proposed Ground & First Floor Plans

Scale
1 : 50 @A1

Job No
1181

Drawing No
200 (PA02)



Status
PLANNING SUBMISSION

Rev
P4




Arena Business Centre
Abbey House
282 Farnborough Road
Farnborough
Hampshire
GU14 7NA

T| +44 (0)1276 402 433
M| +44 (0)777 208 3303
E| mike@ms4architects.co.uk

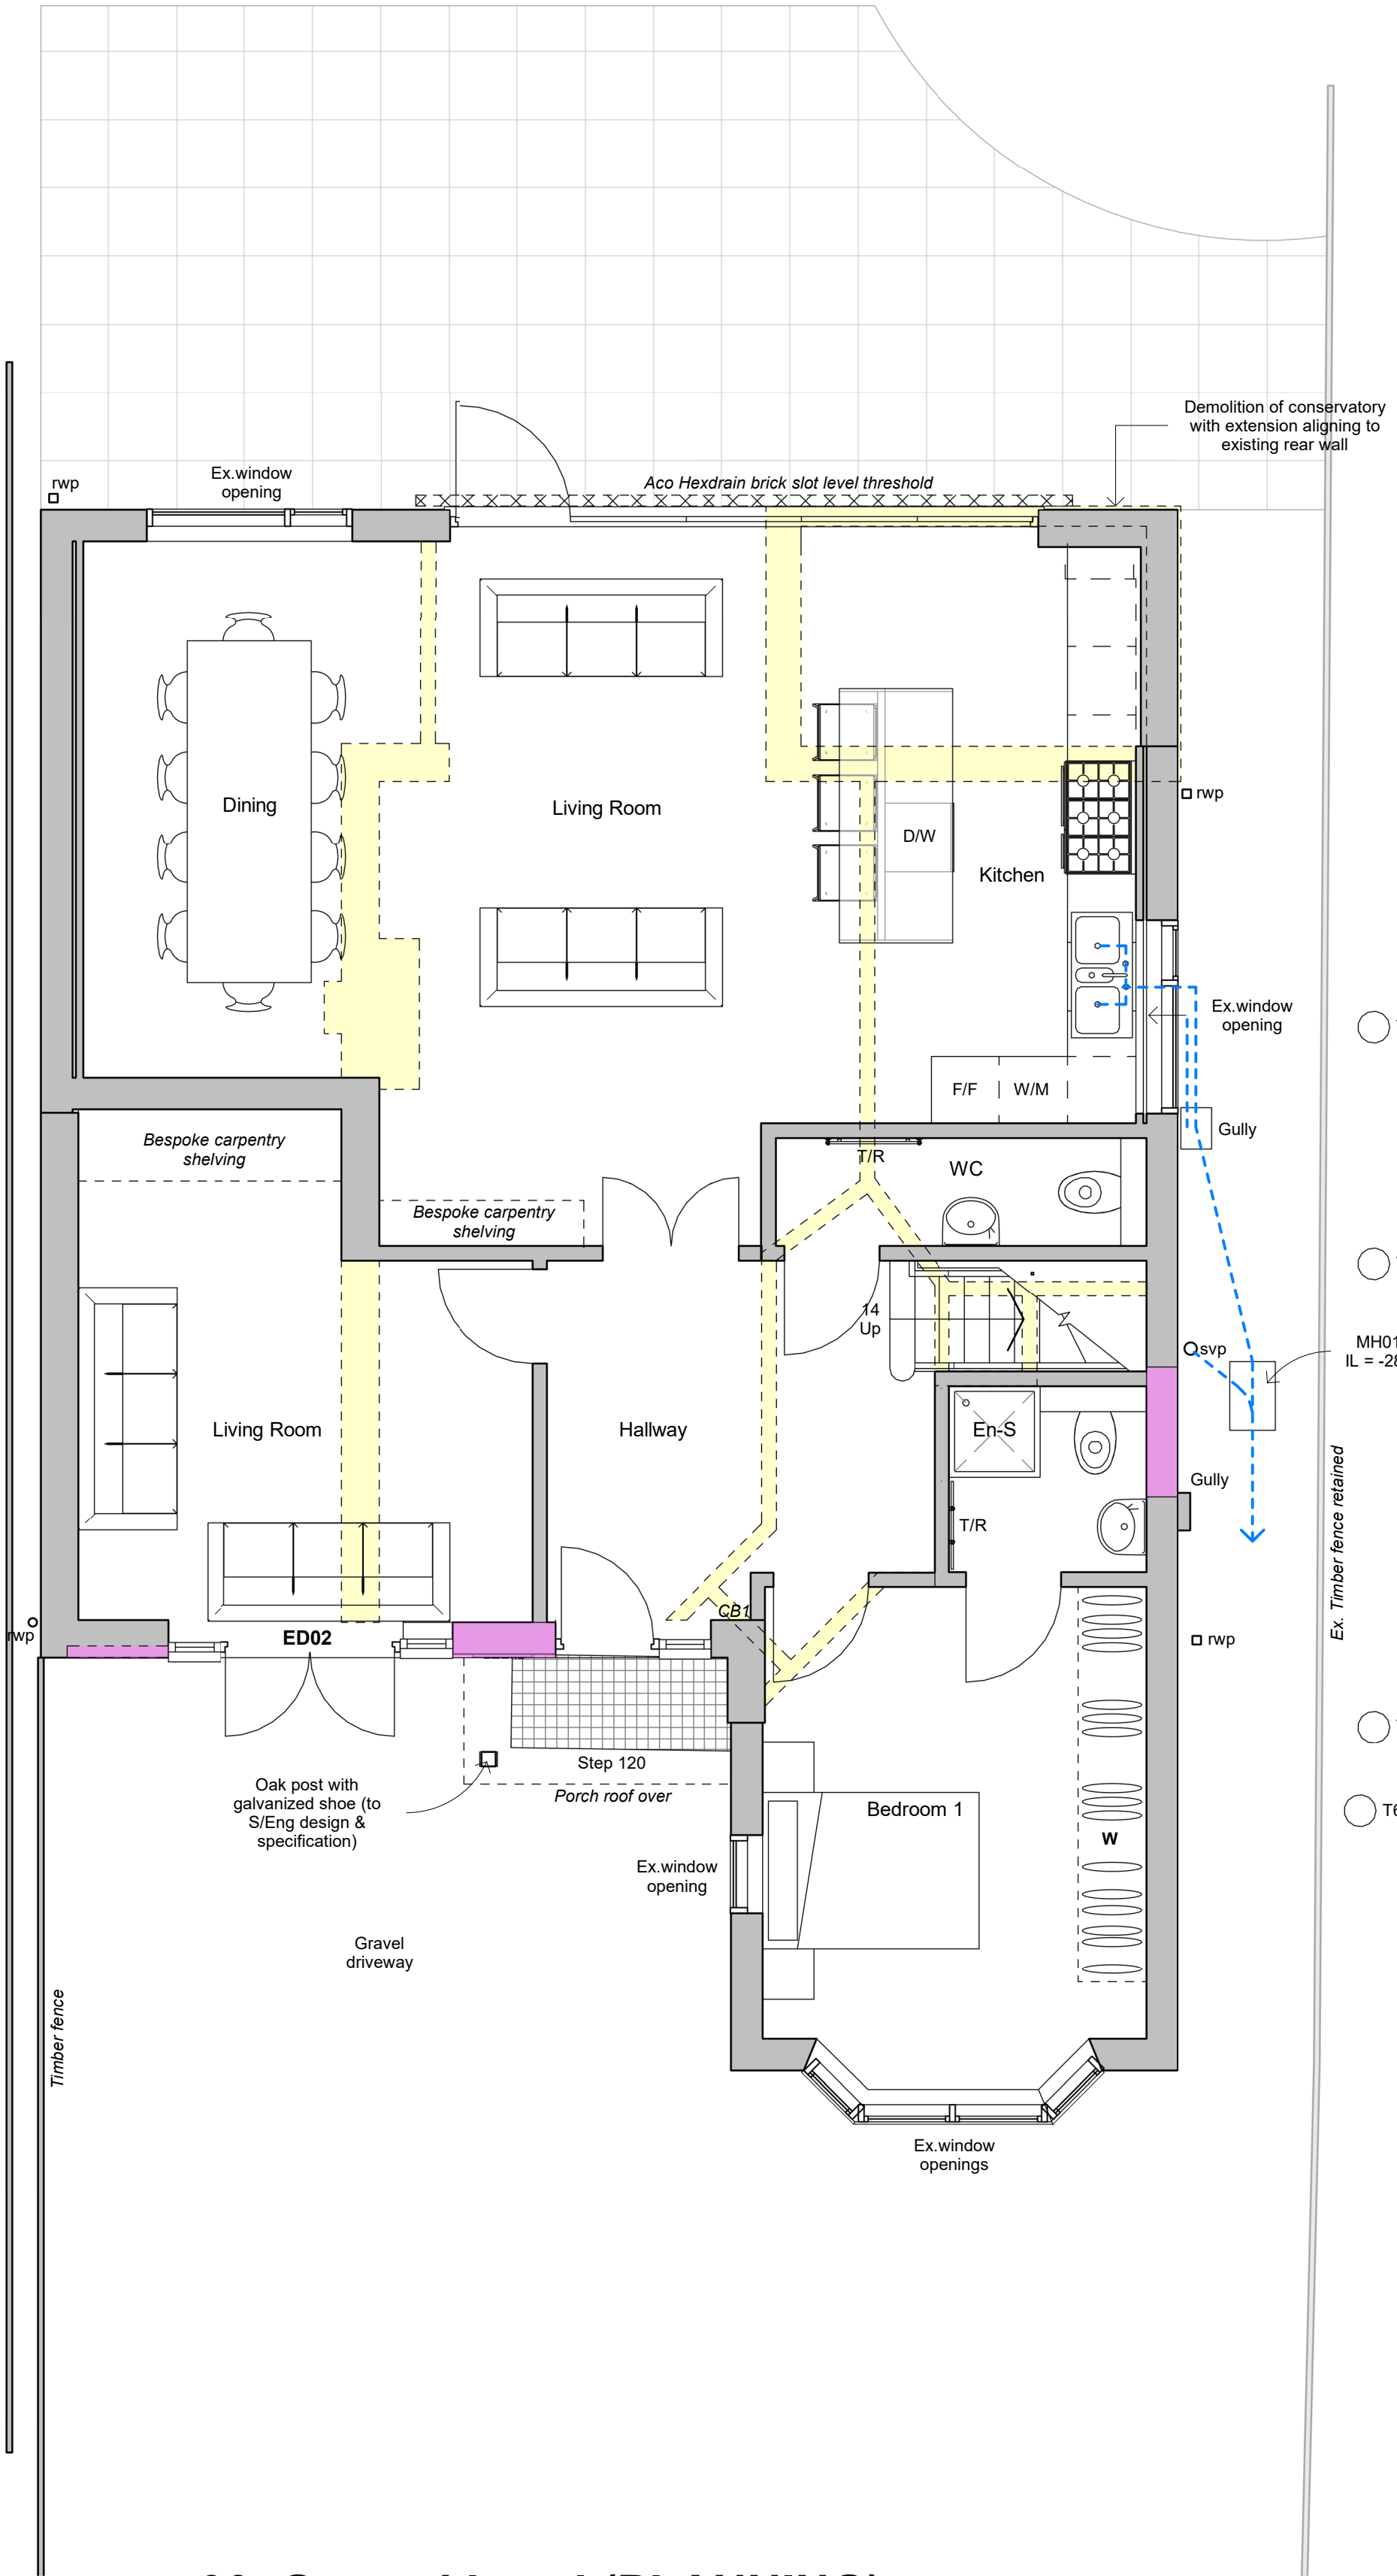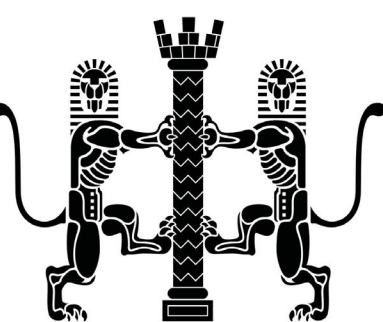

00_Ground Level (PLANNING)
1 : 50

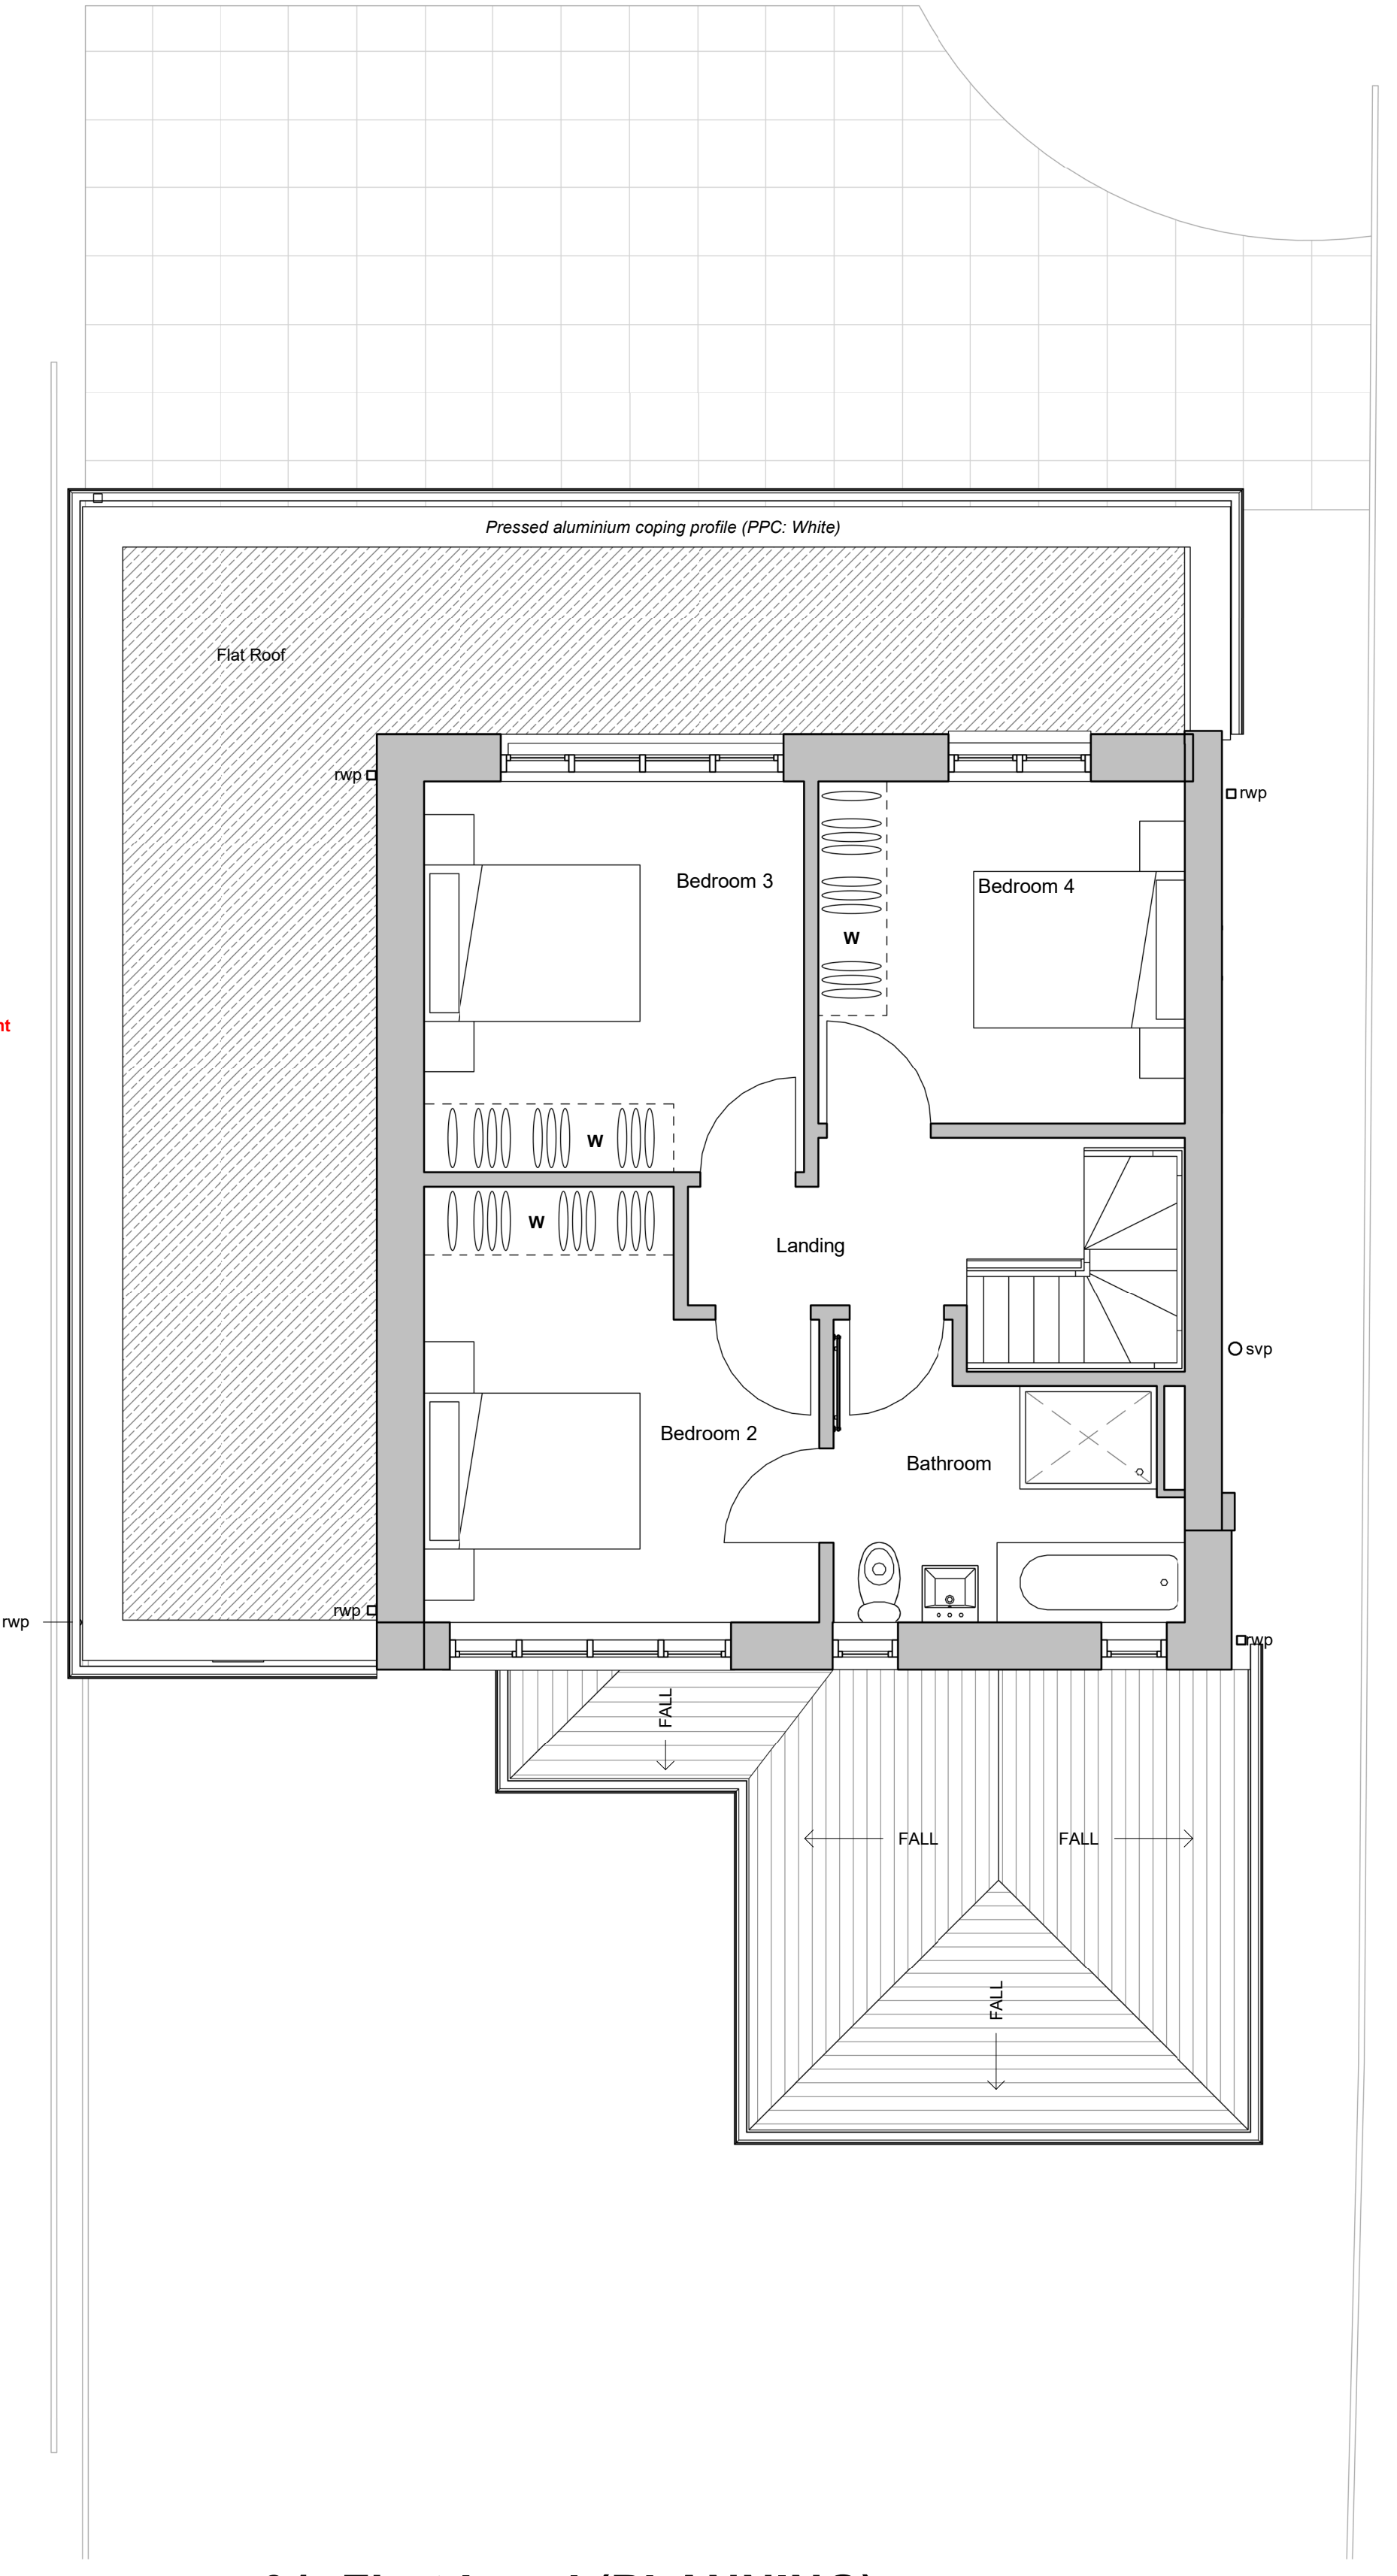

01_First Level (PLANNING)
1 : 50

