




Front Elevation



Rear Elevation

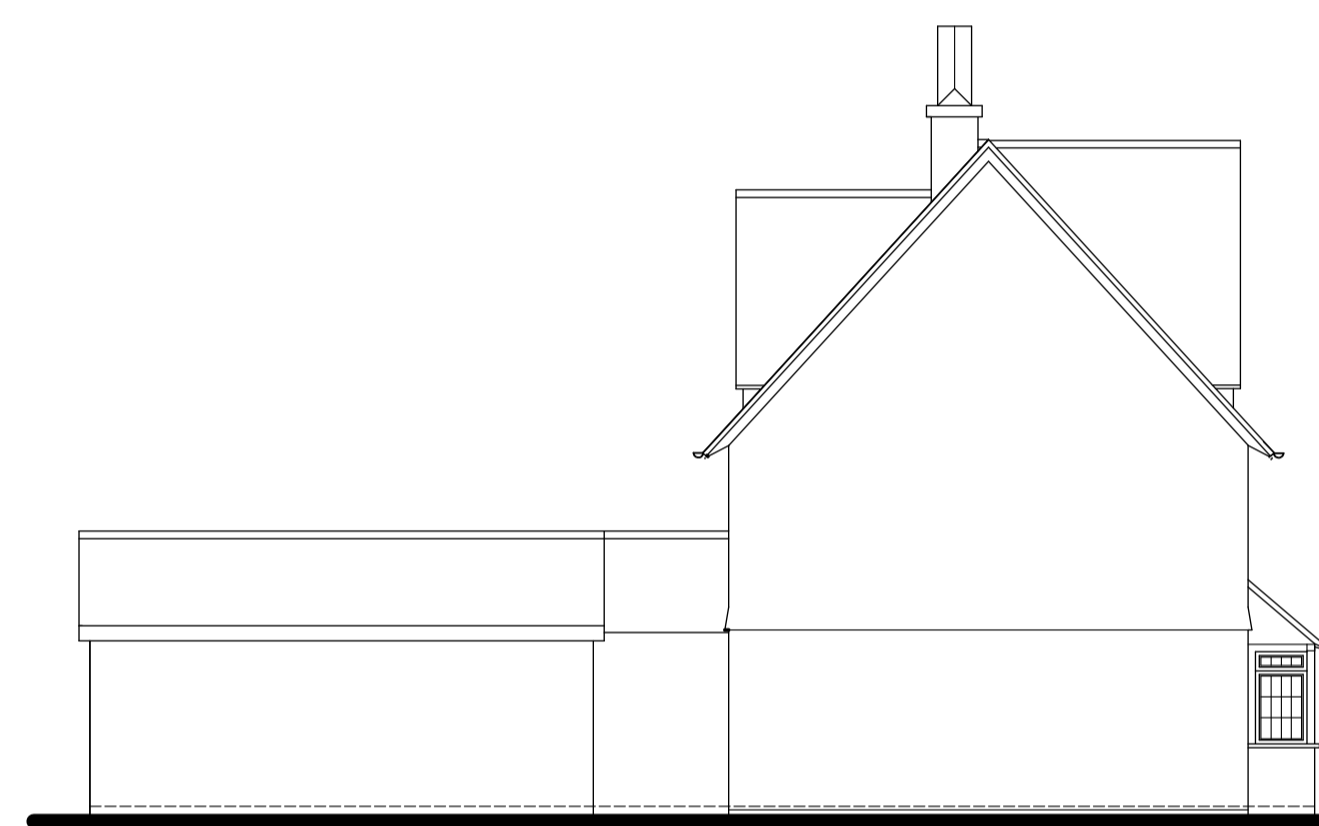

Side Elevation





Side Elevation


Elevational Materials

Walls :- Tile hanging and render
to match existing

Roof :- Plain tiles to match existing on main roof
Slates to match existing on single storey roof

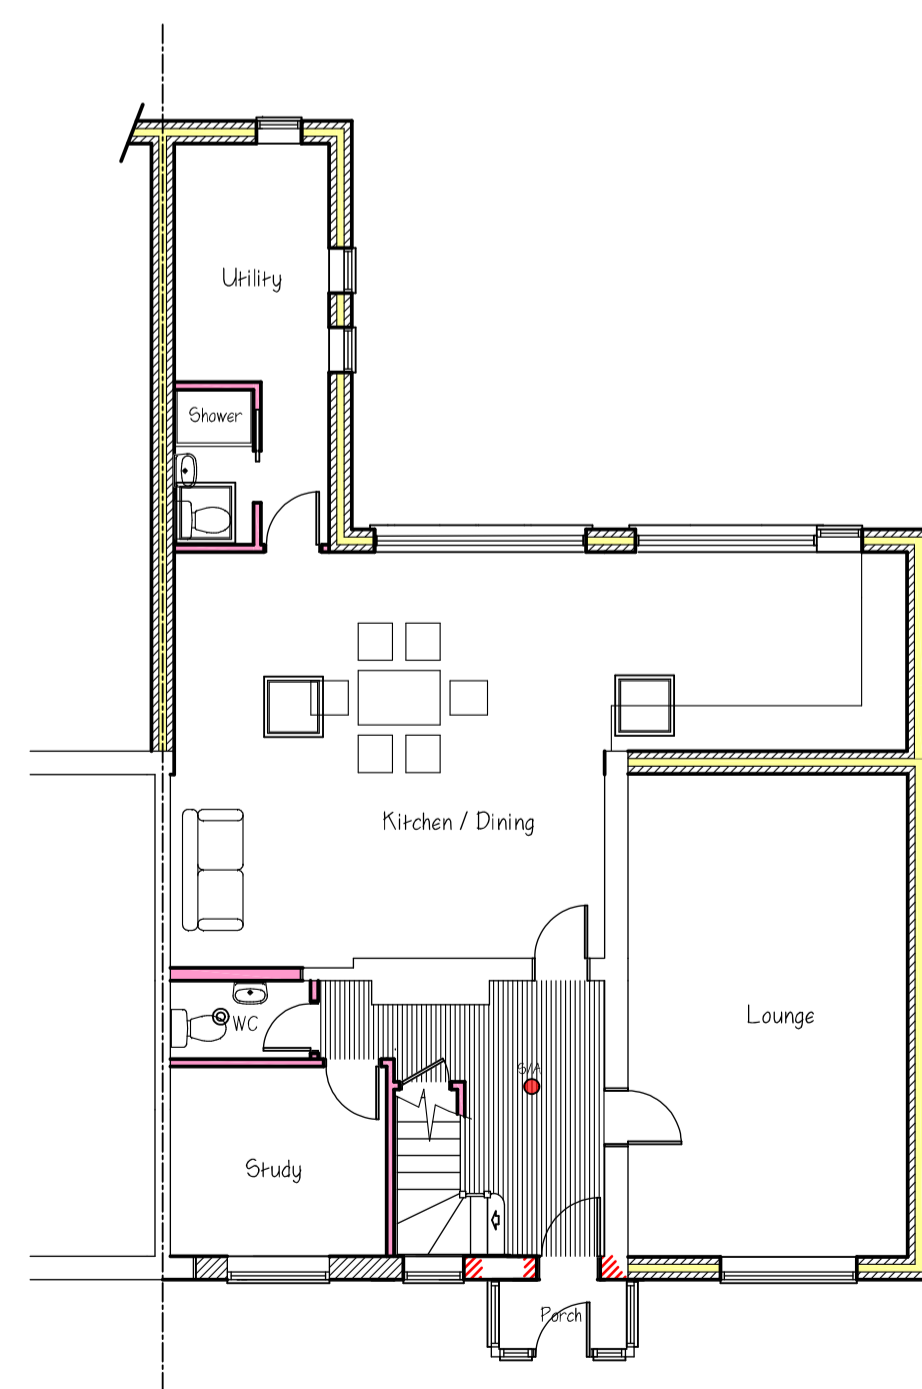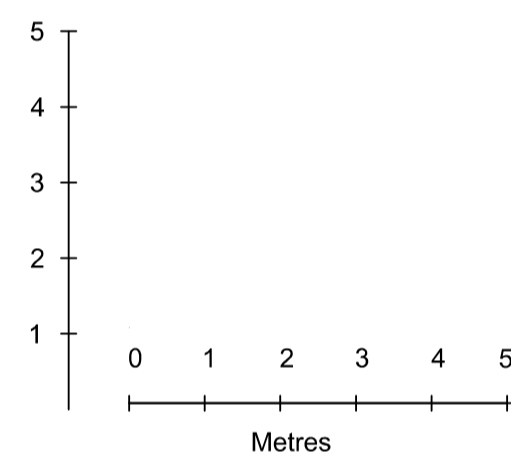

Ground Floor Plan

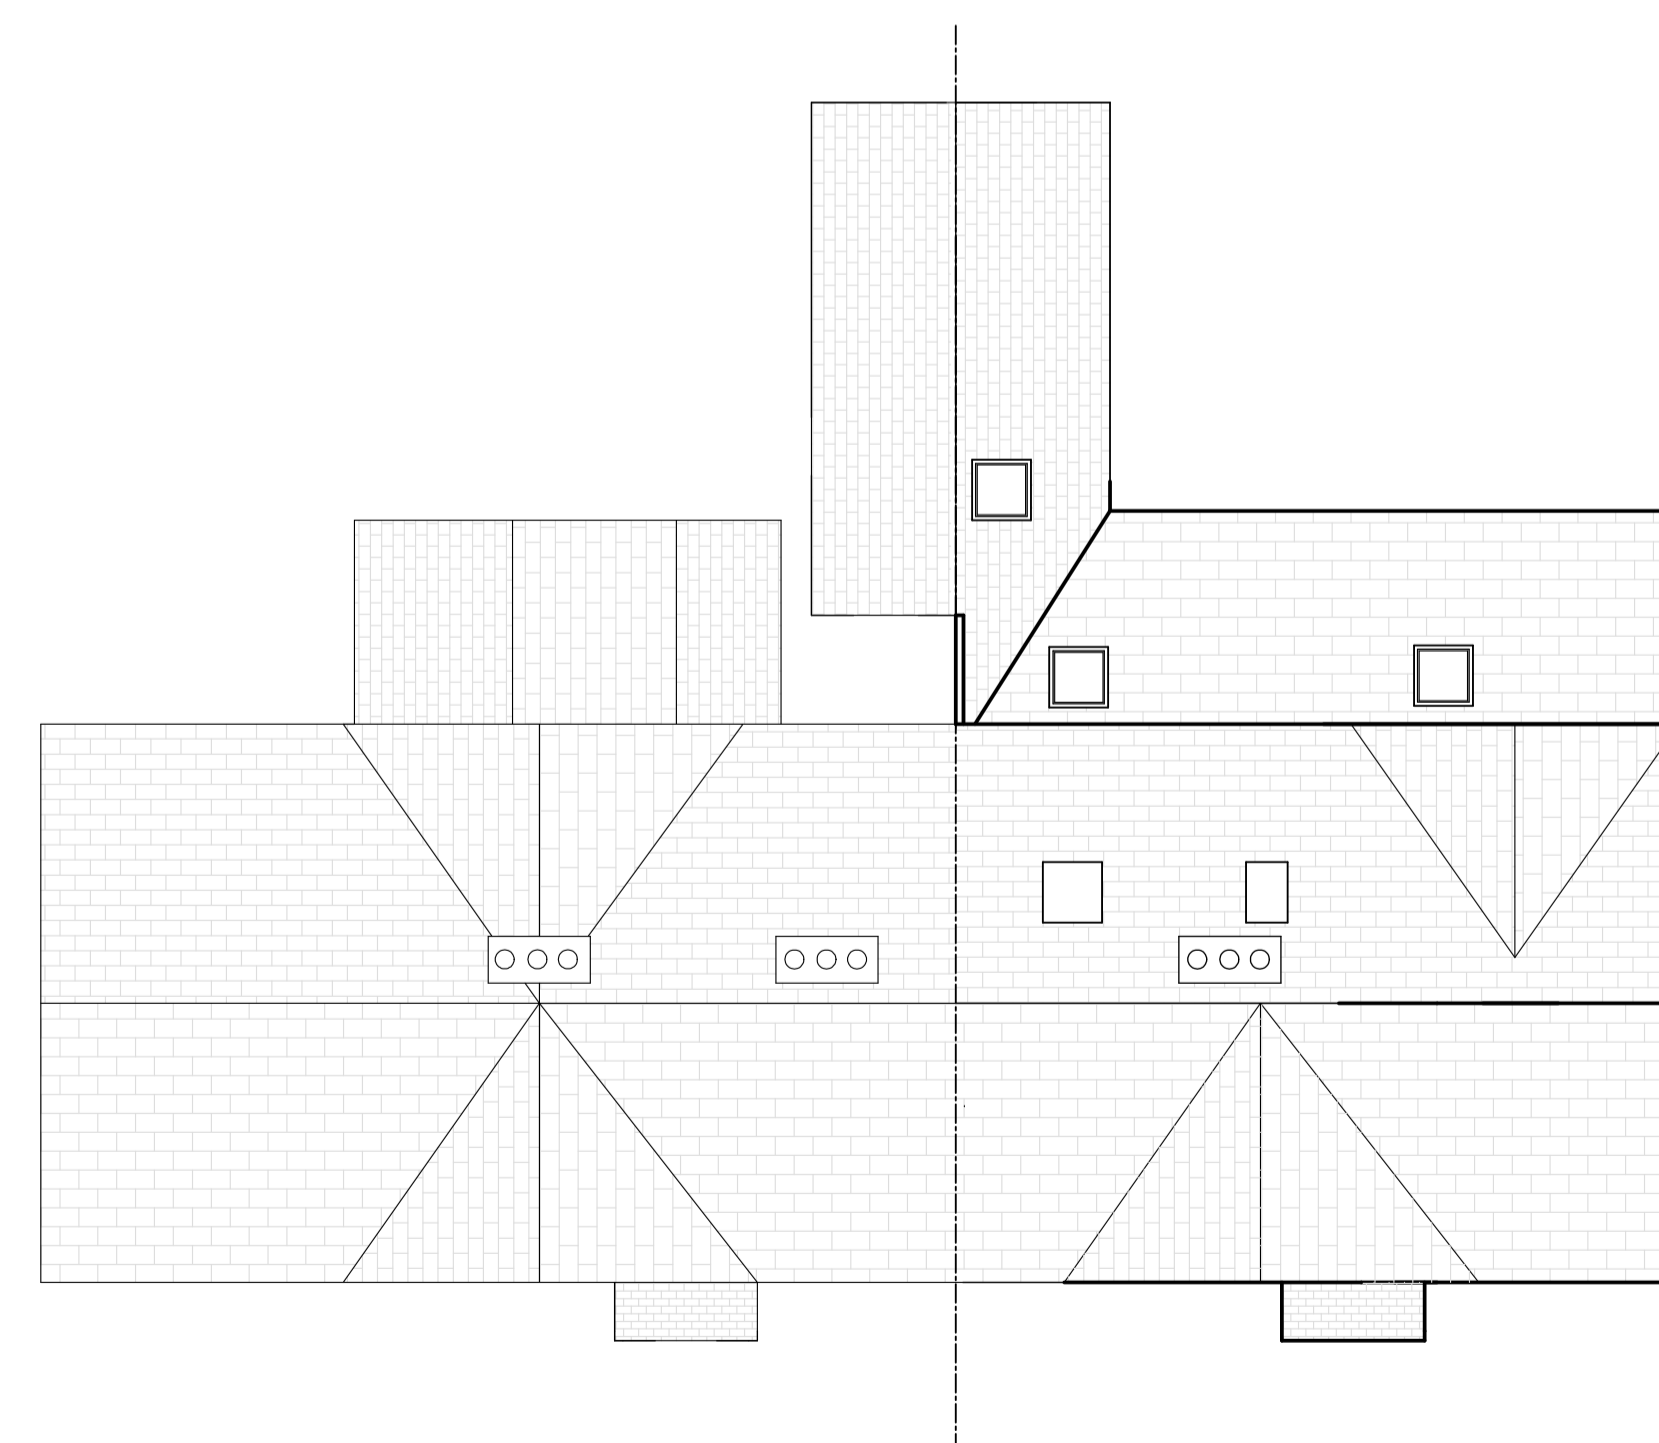

As Built Roof Plan

MONARCH
Design and Build Ltd

9 Bury Lane
Bramfield
Hertfordshire
SG14 2QL
Tel: 01992 500008
Mobile: 07812 243399
Email: nethankins@hotmail.com

Project

Proposed outbuilding
36 Pye Corner
Gilston
Herts

Drawing Title

As built:-
Plans and Elevations
Roof Plan

Scale 1/100 @ A1	Date March 2024	Drawn by NH
---------------------	--------------------	----------------

Drawing No.	Rev.
-------------	------

NH/174/02