



Chainage	00.000	10.000	20.000	330.000	336.996			
Existing Levels	45.144	45.073	45.009	44.938	44.873	44.794	44.712	44.647	44.560	44.458	44.365	44.305	44.298	44.339	44.427	44.452	44.452	43.988	43.884	43.747	43.671	43.615	43.527	43.416	43.294	43.159	42.992	42.885	42.728	42.591	42.424	42.274	42.144	41.982	41.850	41.685	41.487	41.372
Proposed Central Alignment Levels	45.549	45.455	45.360	45.266	45.171	45.077	44.983	44.888	44.794	44.699	44.605	44.511	44.416	44.322	44.227	44.133	44.039	43.988	43.884	43.747	43.671	43.615	43.527	43.396	43.241	43.117	42.992	42.885	42.728	42.591	42.424	42.274	42.144	41.982	41.850	41.685	41.487	41.372
Horizontal Geometry	STRAIGHT L=40.522										STRAIGHT L=296.474																											
Vertical Geometry	G=-0.9% L=140.002										K=22.072 L=6.643		G=-1.2% L=96.058								K=99.127 L=92.663						G=2.2% L=18.892											

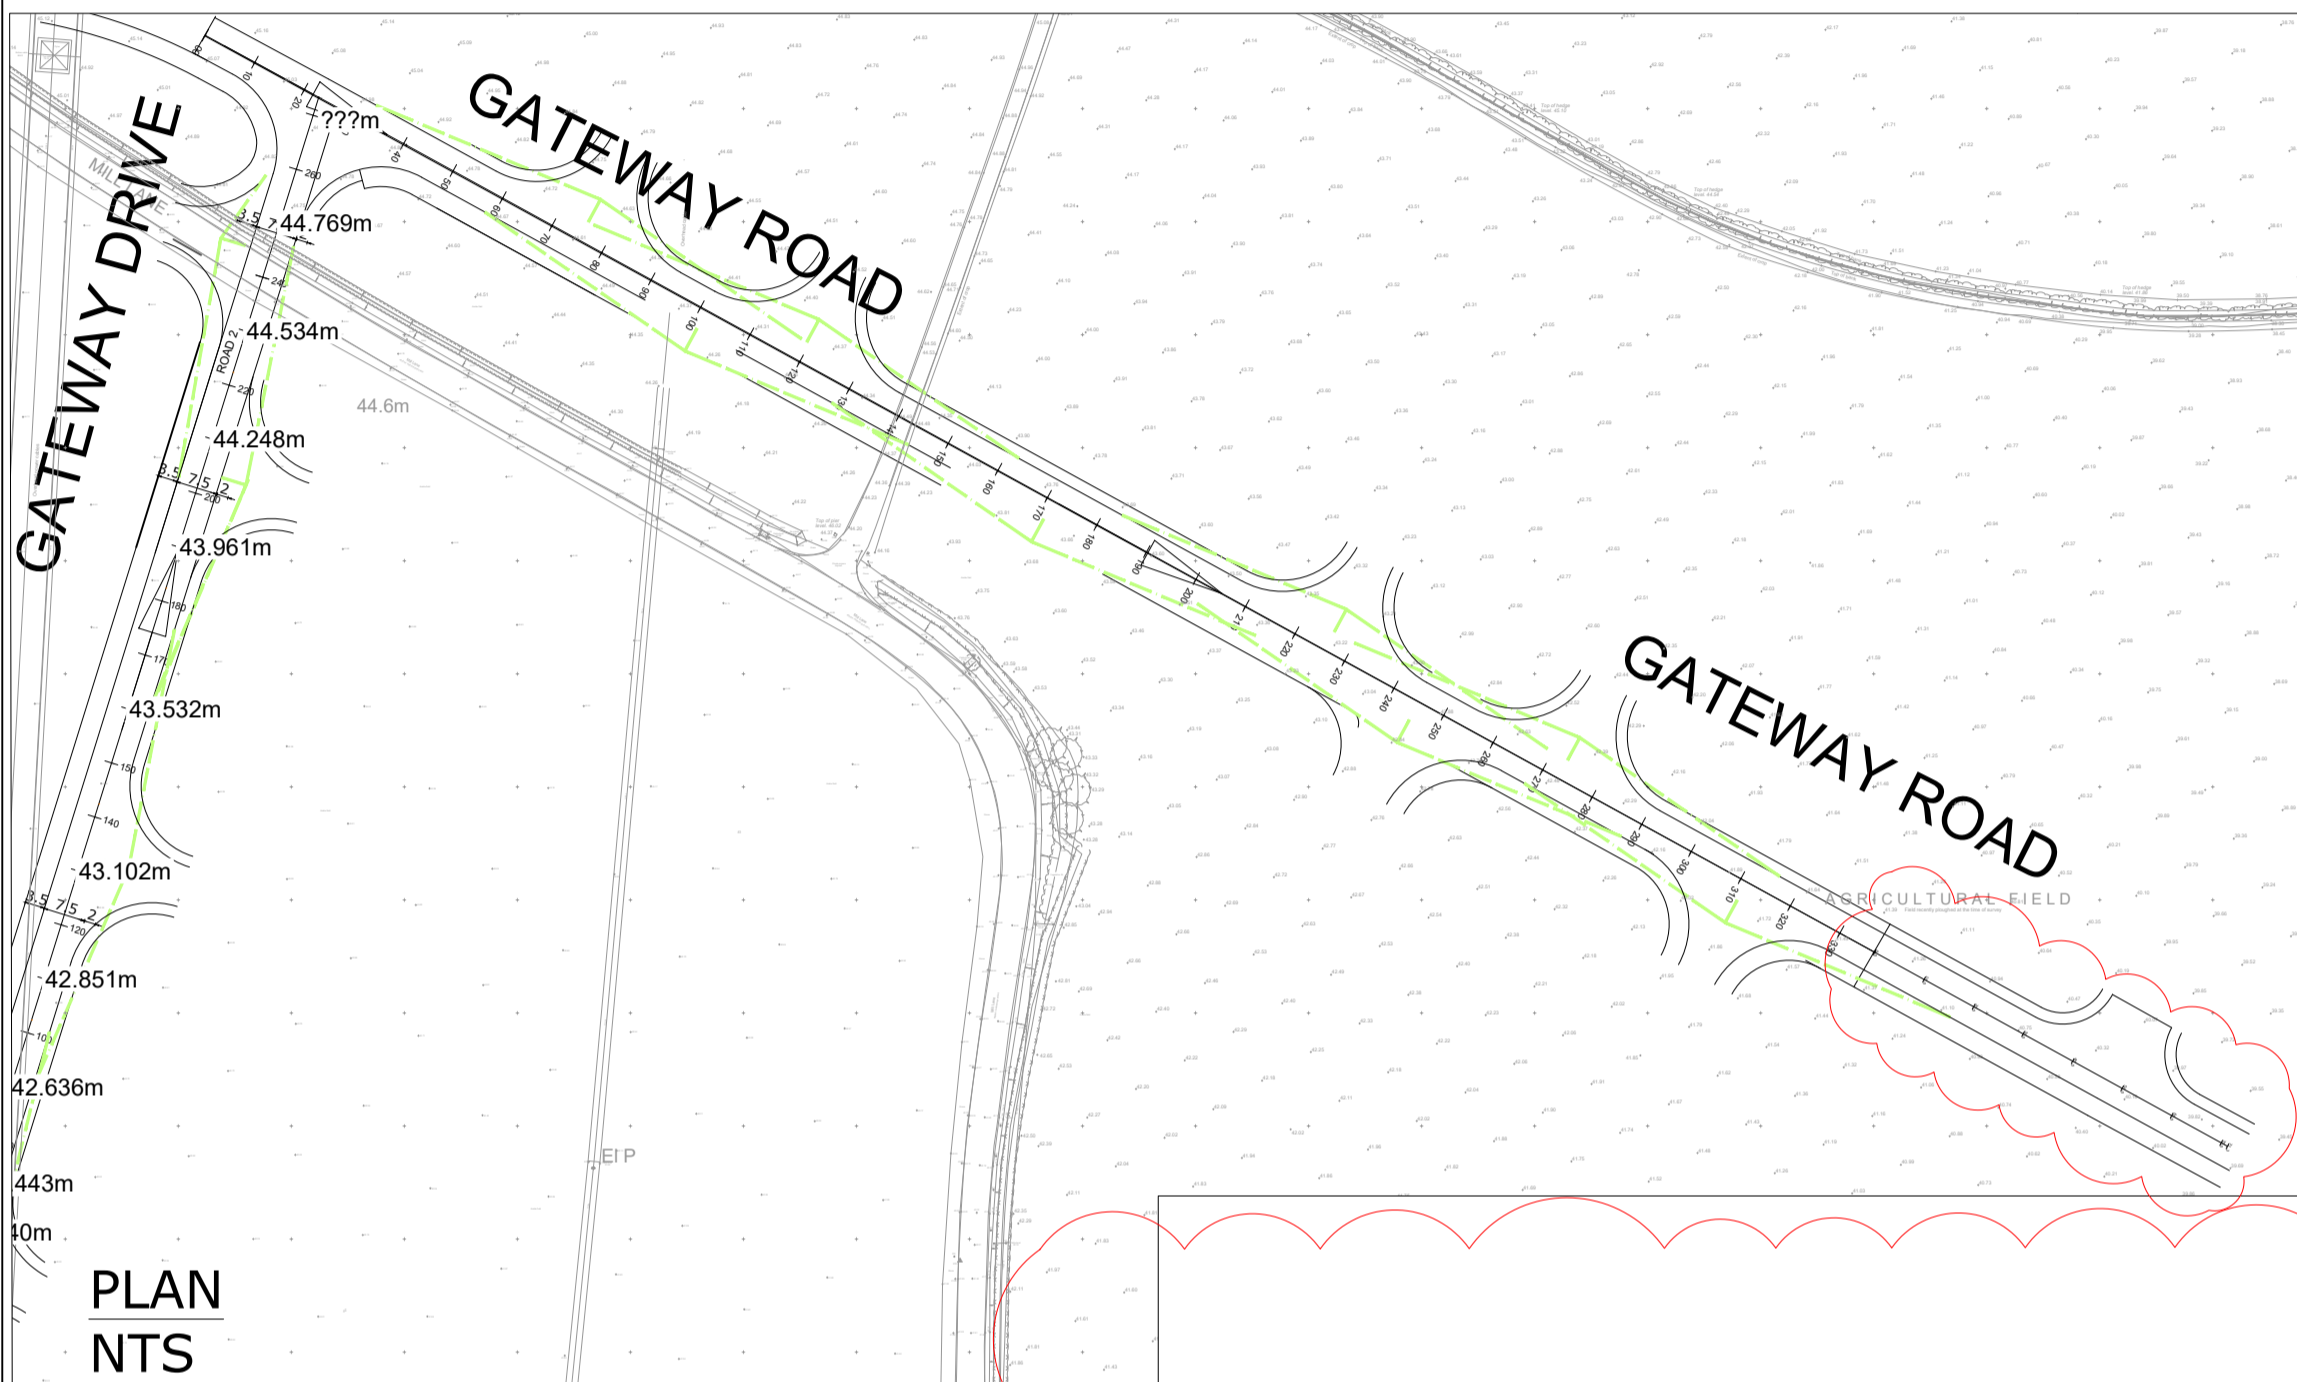

GATEWAY ROAD - LONGSECTION
SCALE: H 1:100, V 1:100. DATUM: 35.000

PLAN
NTS

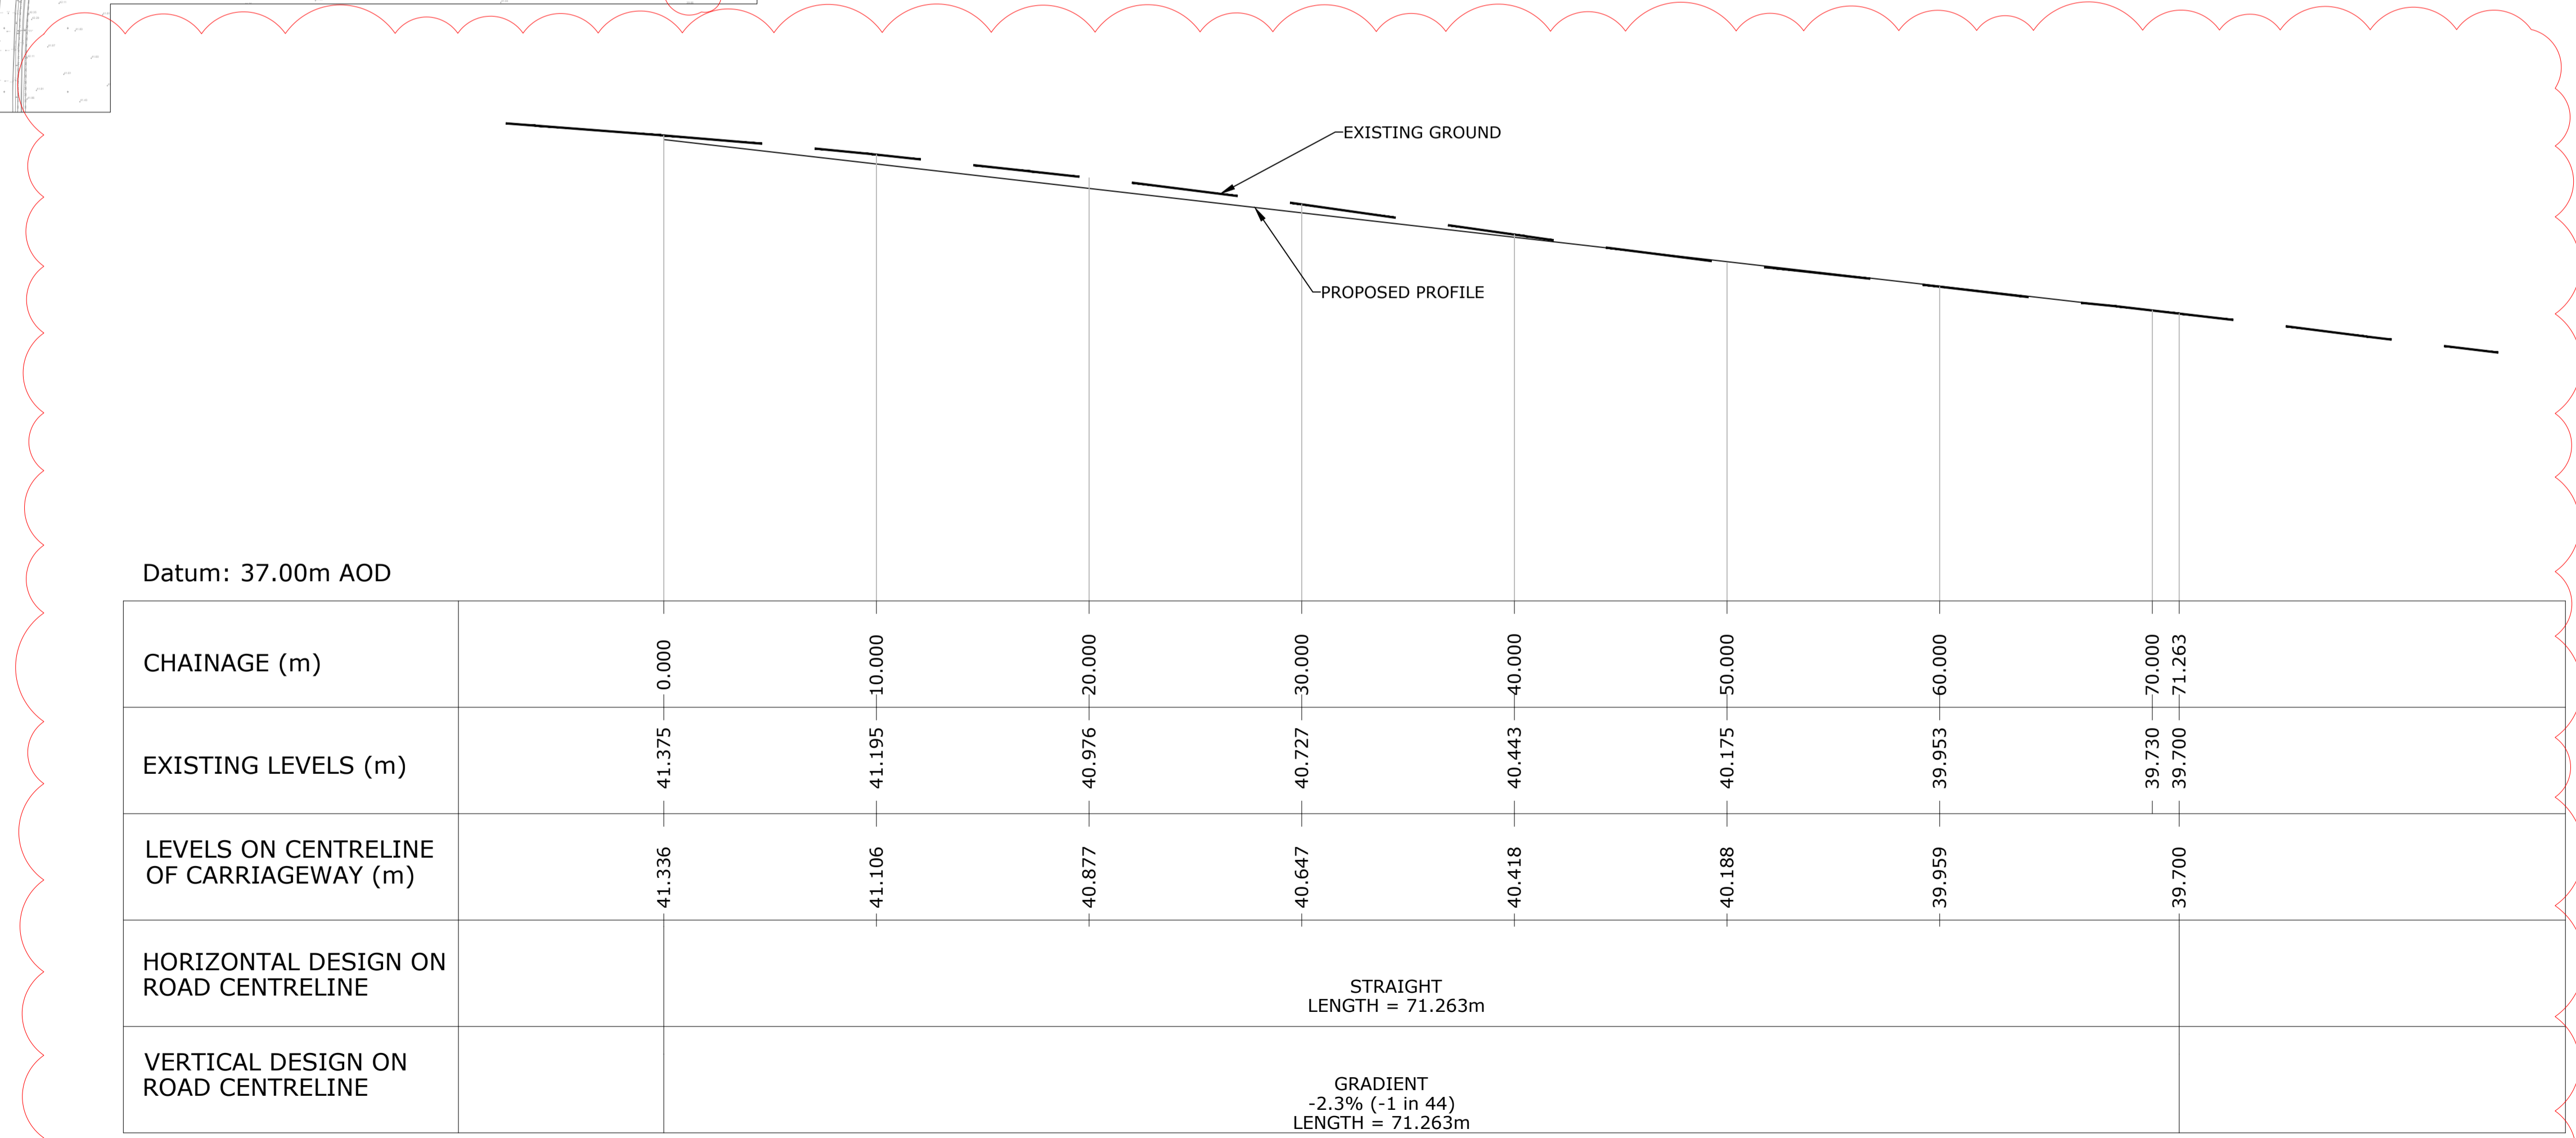

Datum: 37.00m AOD

CHAINAGE (m)	0.000	10.000	20.000	30.000	40.000	50.000	60.000	70.000	71.263
EXISTING LEVELS (m)	41.375	41.195	40.976	40.727	40.443	40.175	39.953	39.730	39.700
LEVELS ON CENTRELINE OF CARRIAGEWAY (m)	41.336	41.106	40.877	40.647	40.418	40.188	39.959	39.700	
HORIZONTAL DESIGN ON ROAD CENTRELINE	STRAIGHT LENGTH = 71.263m								
VERTICAL DESIGN ON ROAD CENTRELINE	GRADIENT -2.3% (-1 in 44) LENGTH = 71.263m								

EXTENSION OF GATEWAY ROAD TO PLOT 1600
SCALE - HOR. 1:200, VER. 1:1000

REV	DATE	DESCRIPTION	DRAWN	CHKD
C	06/03/24	EXTENSION OF ACCESS ROAD TO PLOT 1600 SHOWN	S.L.S	J.J.T
B	24/12/20	GATEWAY ROAD AMENDED	N.B.	M.G.
A	01/12/20	SECTION AMENDED TO LATEST LAYOUT	N.B.	M.G.

REVISIONS
This drawing is to be read in conjunction with all other Engineer's drawings and all other project information. Any discrepancy between the Engineer's drawing and other project information is to be reported to the Engineer immediately.



Project
**GATEWAY 14
STOWMARKET
SUFFOLK**

Title
**ROAD LONG SECTIONS
(SHEET 2 OF 2)**

Client
GATEWAY 14 LTD

Scale	AS SHOWN @ A1	Drawn	A.T.	Date	OCTOBER 2020
Job Manager	Checked	Approved	M.G.		

Richard Jackson Engineering Consultants
 847 The Crescent, Colchester, Essex CO4 9JQ Tel: 01206 228900
 14th Floor, 50th Floor, Adelaide Tower, 25 Abchurch Lane, London EC4A 3DF Tel: 020 7448 8910
 1 Queen House, Mill Court, Great Shelford, Cambs CB22 5JD Tel: 01223 344794
 4 The Old Church, St. Matthews Road, Norwich, Norfolk NR6 5JF Tel: 01603 230540
 The Wheelhouse, Bonds Mill, Stonehouse, Gloucestershire GL10 3HF Tel: 01172 030070
 Email: info@rjeng.co.uk Website: www.rjeng.co.uk

Drawing No.	Revision
60417-C-009	C
Drawing Status <input type="checkbox"/> INFORMATION <input type="checkbox"/> APPROVAL <input type="checkbox"/> COSTING <input type="checkbox"/> TENDER <input type="checkbox"/> CONSTRUCTION <input type="checkbox"/> AS CONSTRUCTED	