




FRONT ELEVATION
(AS BUILT)



SIDE ELEVATION
(AS BUILT)



REAR ELEVATION
(AS BUILT)

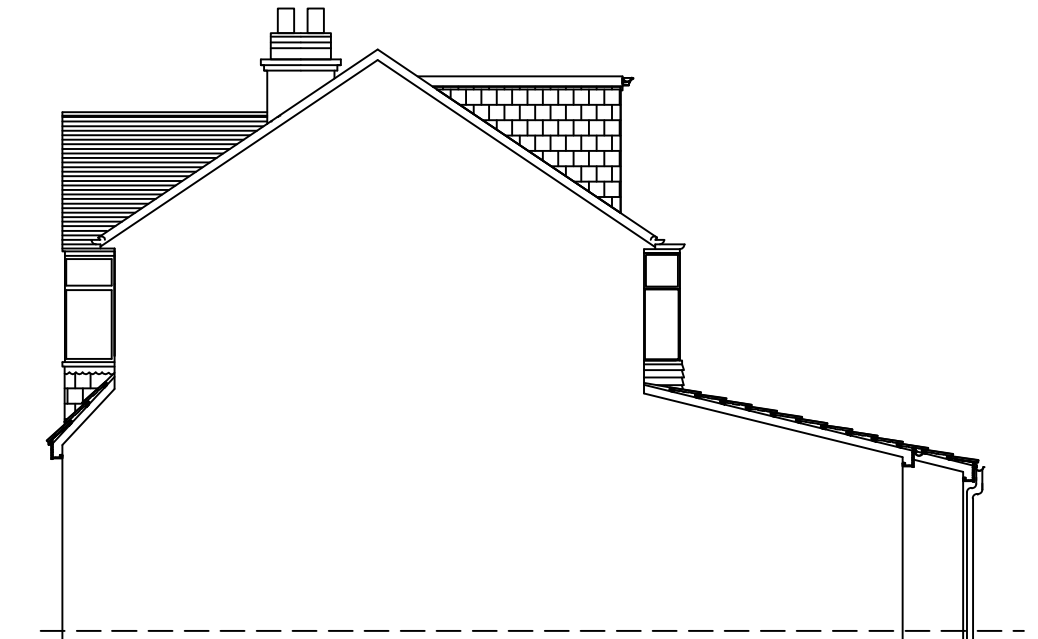

SIDE ELEVATION
(AS BUILT)

Scale 1 : 100 @ A3



Property Address	Client		Scale	ARM Design & Build Ltd Suit 210, Kingfisher House, Restmor Way, Wallington, England, SM6 7AH Telephone: 07816587548
469 & 469A Gander Green Lane, North Cheam, SM3 9RA	Description	Drawing No.	1:100 @ A3	
	As Built Elevations	006-469GGL-REV1		