




**GROUND FLOOR PLAN  
(AS BUILT)**

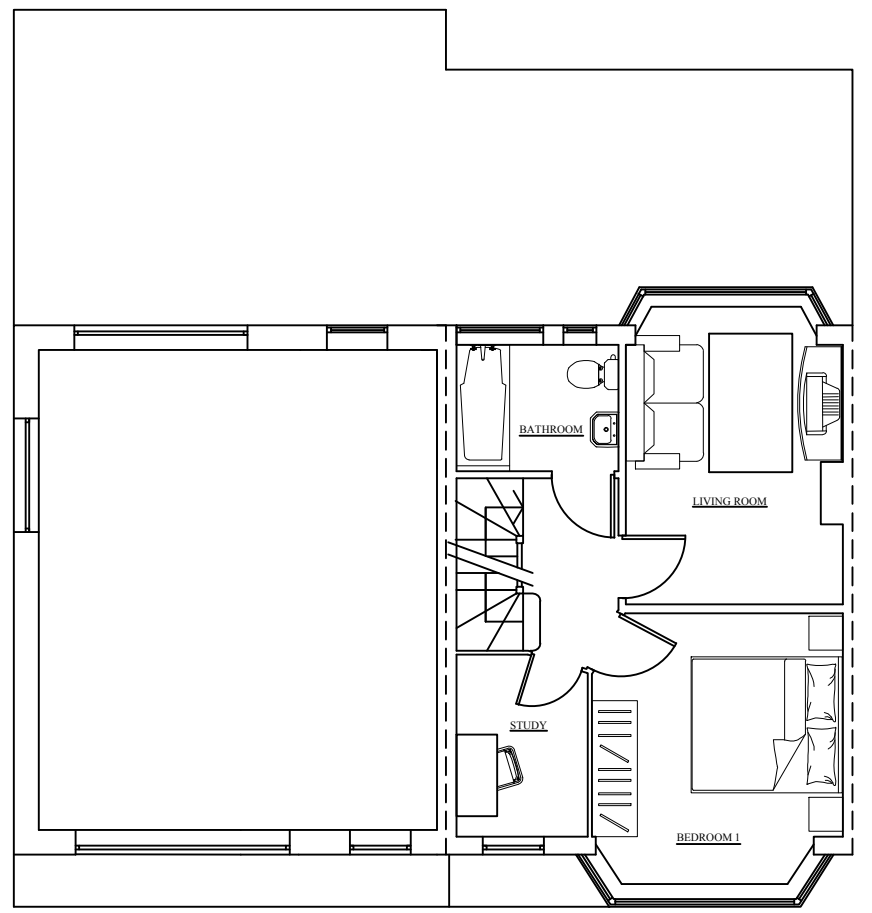

**FIRST FLOOR PLAN  
(AS BUILT)**

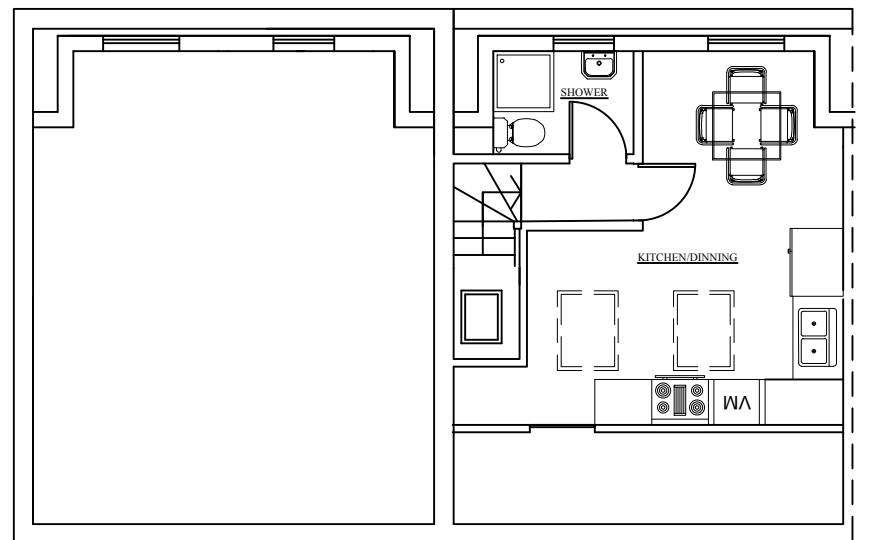

**LOFT PLAN  
(AS BUILT)**

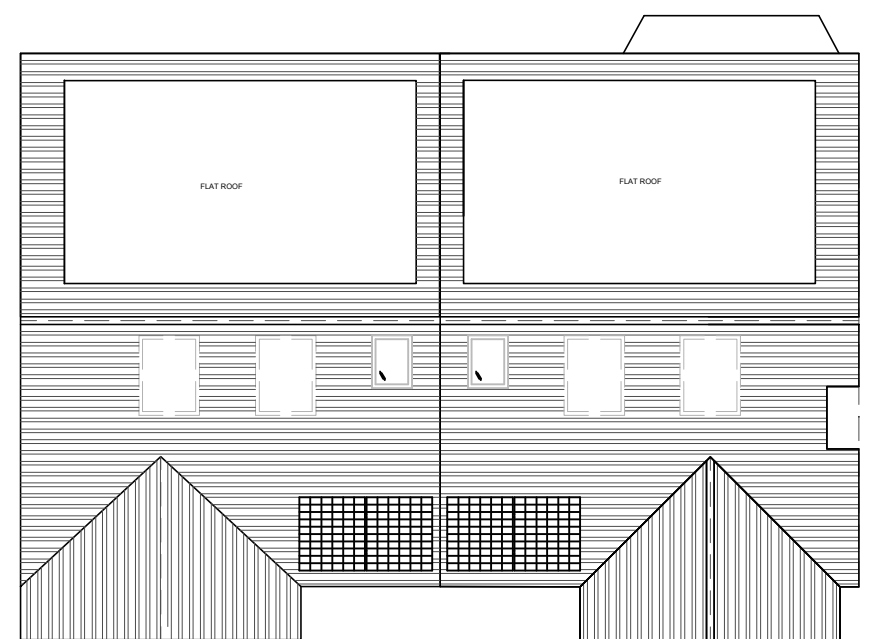

**ROOF PLAN  
(AS BUILT)**

Scale 1 : 100 @ A3  
0 1 2 3 4 5m

<b>Property Address</b>	<b>Client</b>	<b>Scale</b>	<b>ARM Design &amp; Build Ltd</b> Suit 210, Kingfisher House, Restmor Way, Wallington, England, SM6 7AH Telephone: 07816587548
469 & 469A Gander Green Lane, North Cheam, SM3 9RA	<b>Description</b>	1:100 @ A3	
	As Built Plans	<b>Drawing No.</b> 005-469GGL-REV1	