



THIS MAP IS REPRODUCED FROM ORDNANCE SURVEY © MATERIAL BY WSP Group ON BEHALF OF National Grid WITH THE PERMISSION OF THE CONTROLLER OF HER MAJESTY'S STATIONARY OFFICE.  
 ©CROWN COPYRIGHT. UNAUTHORISED REPRODUCTION INFRINGES CROWN COPYRIGHT AND MAY LEAD TO PROSECUTION OR CIVIL PROCEEDINGS  
 LICENCE NUMBER: 100024241

- NOTES:
- THIS DRAWING IS TO BE READ IN CONJUNCTION WITH ALL OTHER RELEVANT DRAWINGS, DOCUMENTS AND SPECIFICATIONS.
  - DO NOT SCALE OFF THIS DRAWING. WORK ONLY TO DIMENSIONS SHOWN.

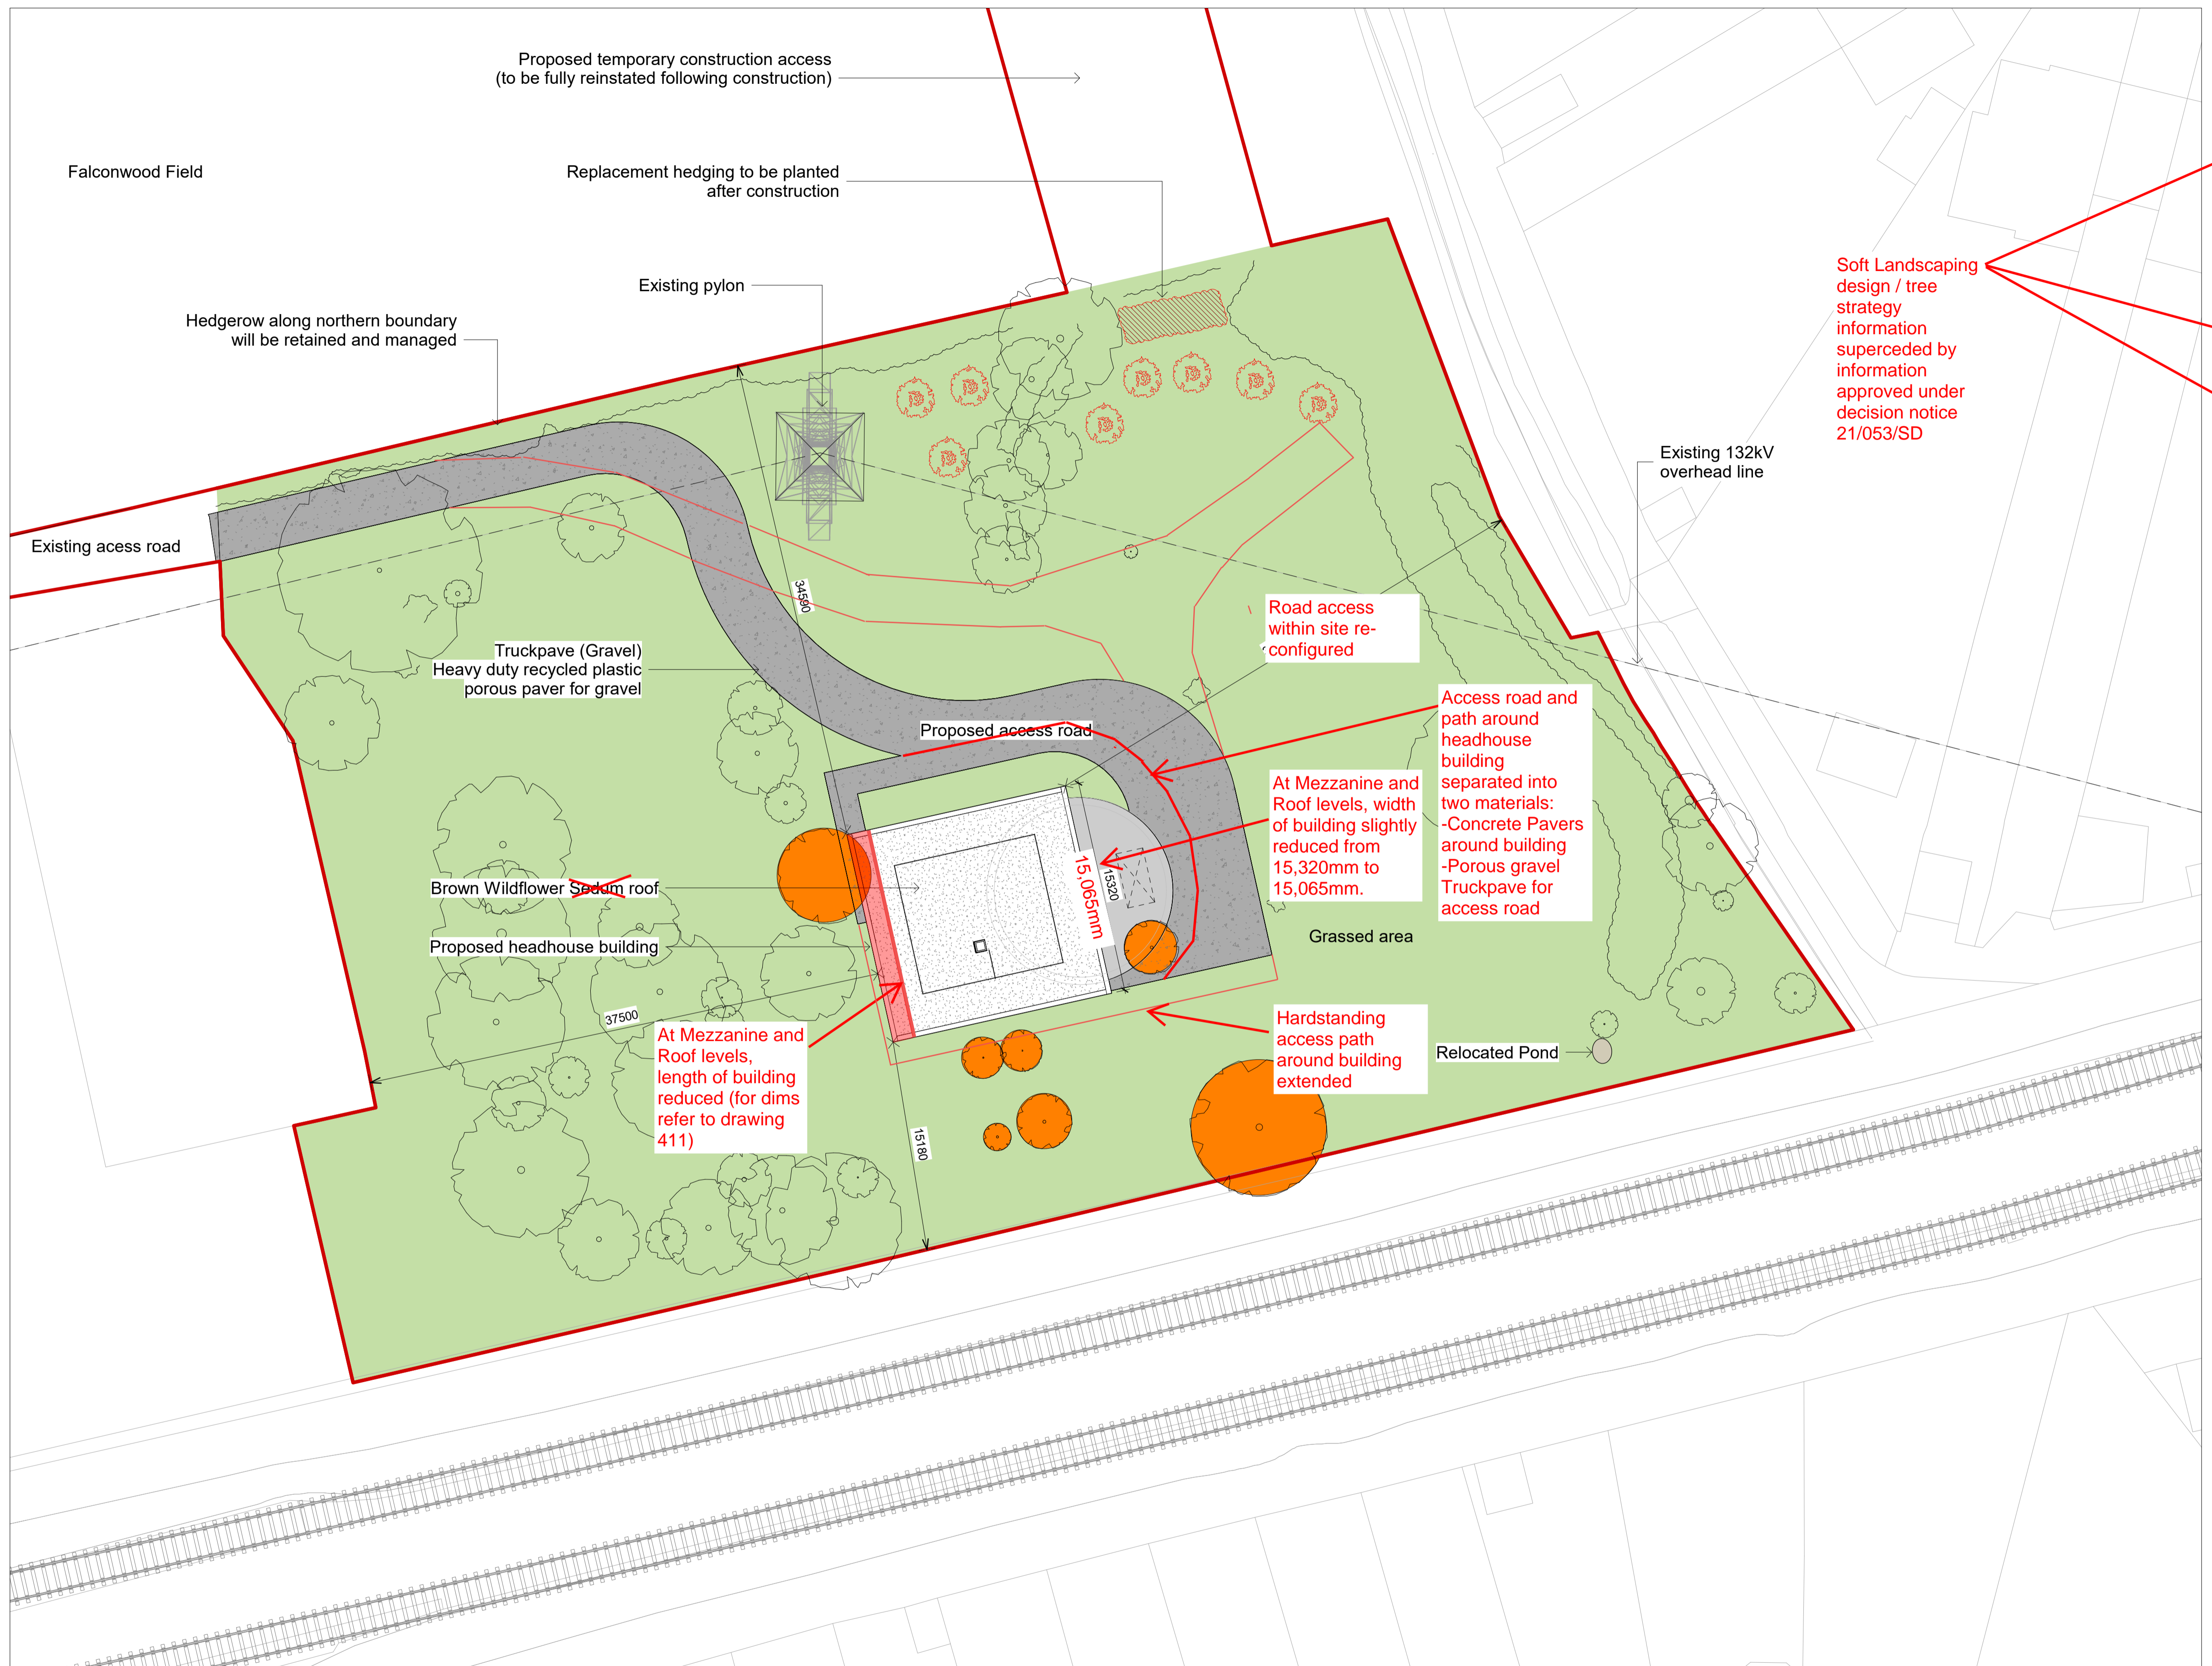

- Existing trees identified for removal
- Access road and hardstanding
- Existing trees retained
- Proposed tree
- Planning application boundary

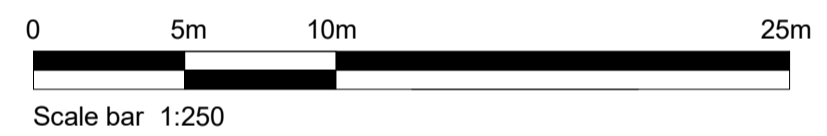

Rev	Description	Cre'd	Ch'kd	App'd	Date
G	PLANNING APPLICATION	JR	CM	SS	21.11.2018
F	DRAFT PLANNING	JR	CM	SS	16.11.2018
E	DRAFT PLANNING	JR	CM	SS	02.11.2018
D	DRAFT PLANNING DRAWING - SWEPT PATH UPDATE	JR	CM	SS	26.09.2018
C	DRAFT PLANNING DRAWING - COMMENTS	JR	JA	SS	22.08.2018
B	DRAFT PLANNING DRAWING	JR	CM	SS	15.08.2018
A		GF	TH	SS	30.04.2018

**wsp**  
 Mournbatten House, Basing View, Basingstoke RG21 4HJ, UK  
 T +44 (0) 1256 318 800 | wsp.com

**fp**  
 30 Kings Bench Street, London SE1 0QX, UK  
 T +44 (0)20 7253 0303 | admin@freddy-pollard.co.uk

**nationalgrid**  
 National Grid plc, Warwick Technology Park, Galloway Hill, Warwick, CV34 6DA

Master Scheme No: 11524	Sub-Scheme No: PROJECT	Site: PROJECT WIDE
----------------------------	---------------------------	-----------------------

Scheme Name:  
LPT2

Document Title:  
ELTHAM HEAD HOUSE  
PROPOSED SITE PLAN


Created by: JR	Date: 21/11/2018	Checked by: CM	Date: 21/11/2018	Approved by: SS	Date: 21/11/2018
-------------------	---------------------	-------------------	---------------------	--------------------	---------------------

Development Eng: NR	Document Type: ARC	Scale: 1 : 250	Format: A1	Sheet(s): 1 OF 1	Rev: G
------------------------	-----------------------	-------------------	---------------	---------------------	-----------

National Grid Document Number:  
PDD-11524-ARC- 403

**Amendment Markup**


**Proposed Site Plan**  
1 : 250

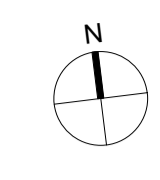


THIS MAP IS REPRODUCED FROM ORDNANCE SURVEY © MATERIAL BY WSP Group ON BEHALF OF National Grid WITH THE PERMISSION OF THE CONTROLLER OF HER MAJESTY'S STATIONARY OFFICE.  
 ©CROWN COPYRIGHT. UNAUTHORISED REPRODUCTION INFRINGES CROWN COPYRIGHT AND MAY LEAD TO PROSECUTION OR CIVIL PROCEEDINGS  
 LICENCE NUMBER: 100024241

- NOTES:
- THIS DRAWING IS TO BE READ IN CONJUNCTION WITH ALL OTHER RELEVANT DRAWINGS, DOCUMENTS AND SPECIFICATIONS.
  - DO NOT SCALE OFF THIS DRAWING. WORK ONLY TO DIMENSIONS SHOWN.


- Control Access
- Control Room
- Lobby
- Ventilation Area
- Mezzanine Area Maintenance Access

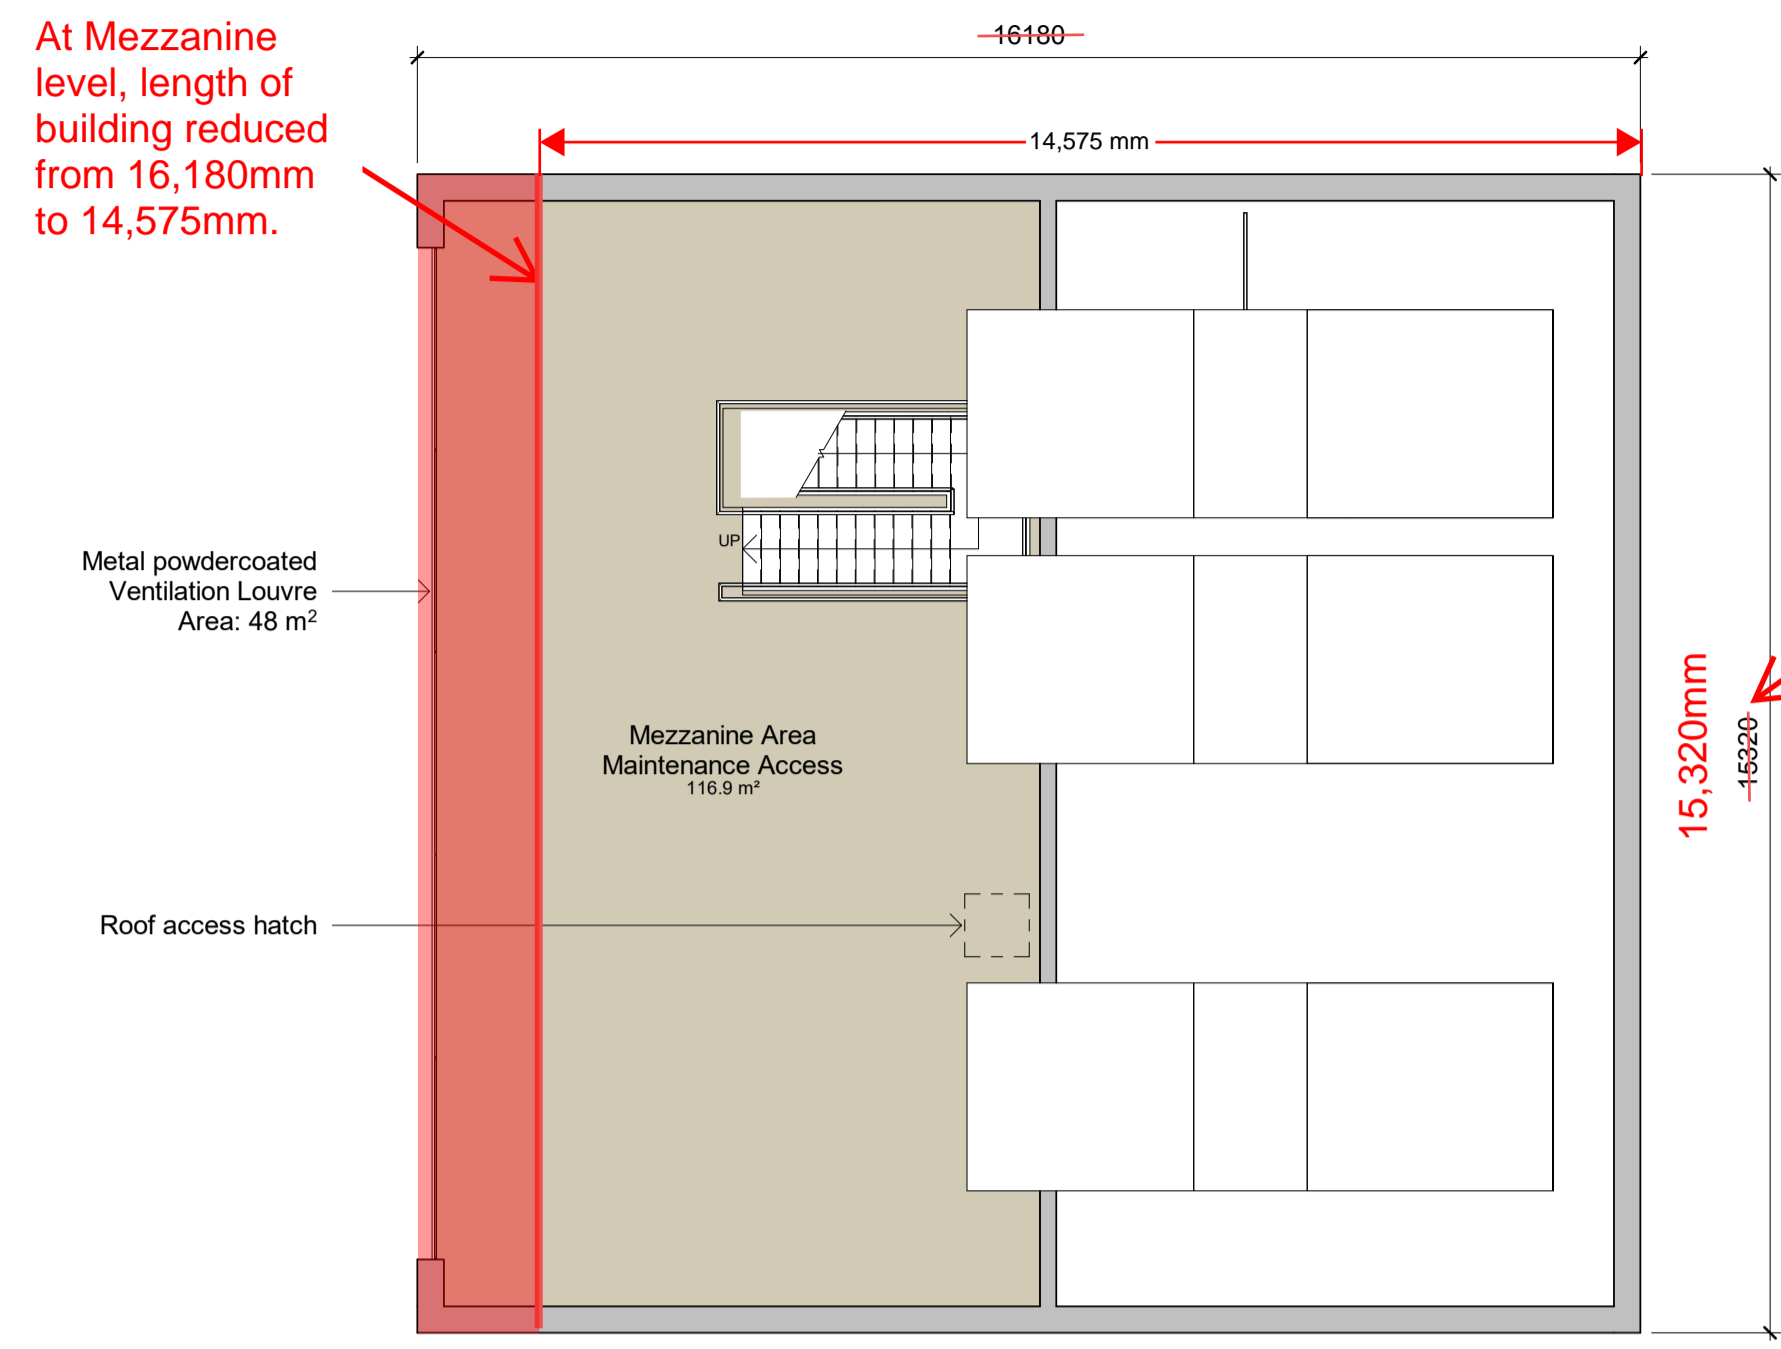


**002 Mezzanine Level**  
1 : 100

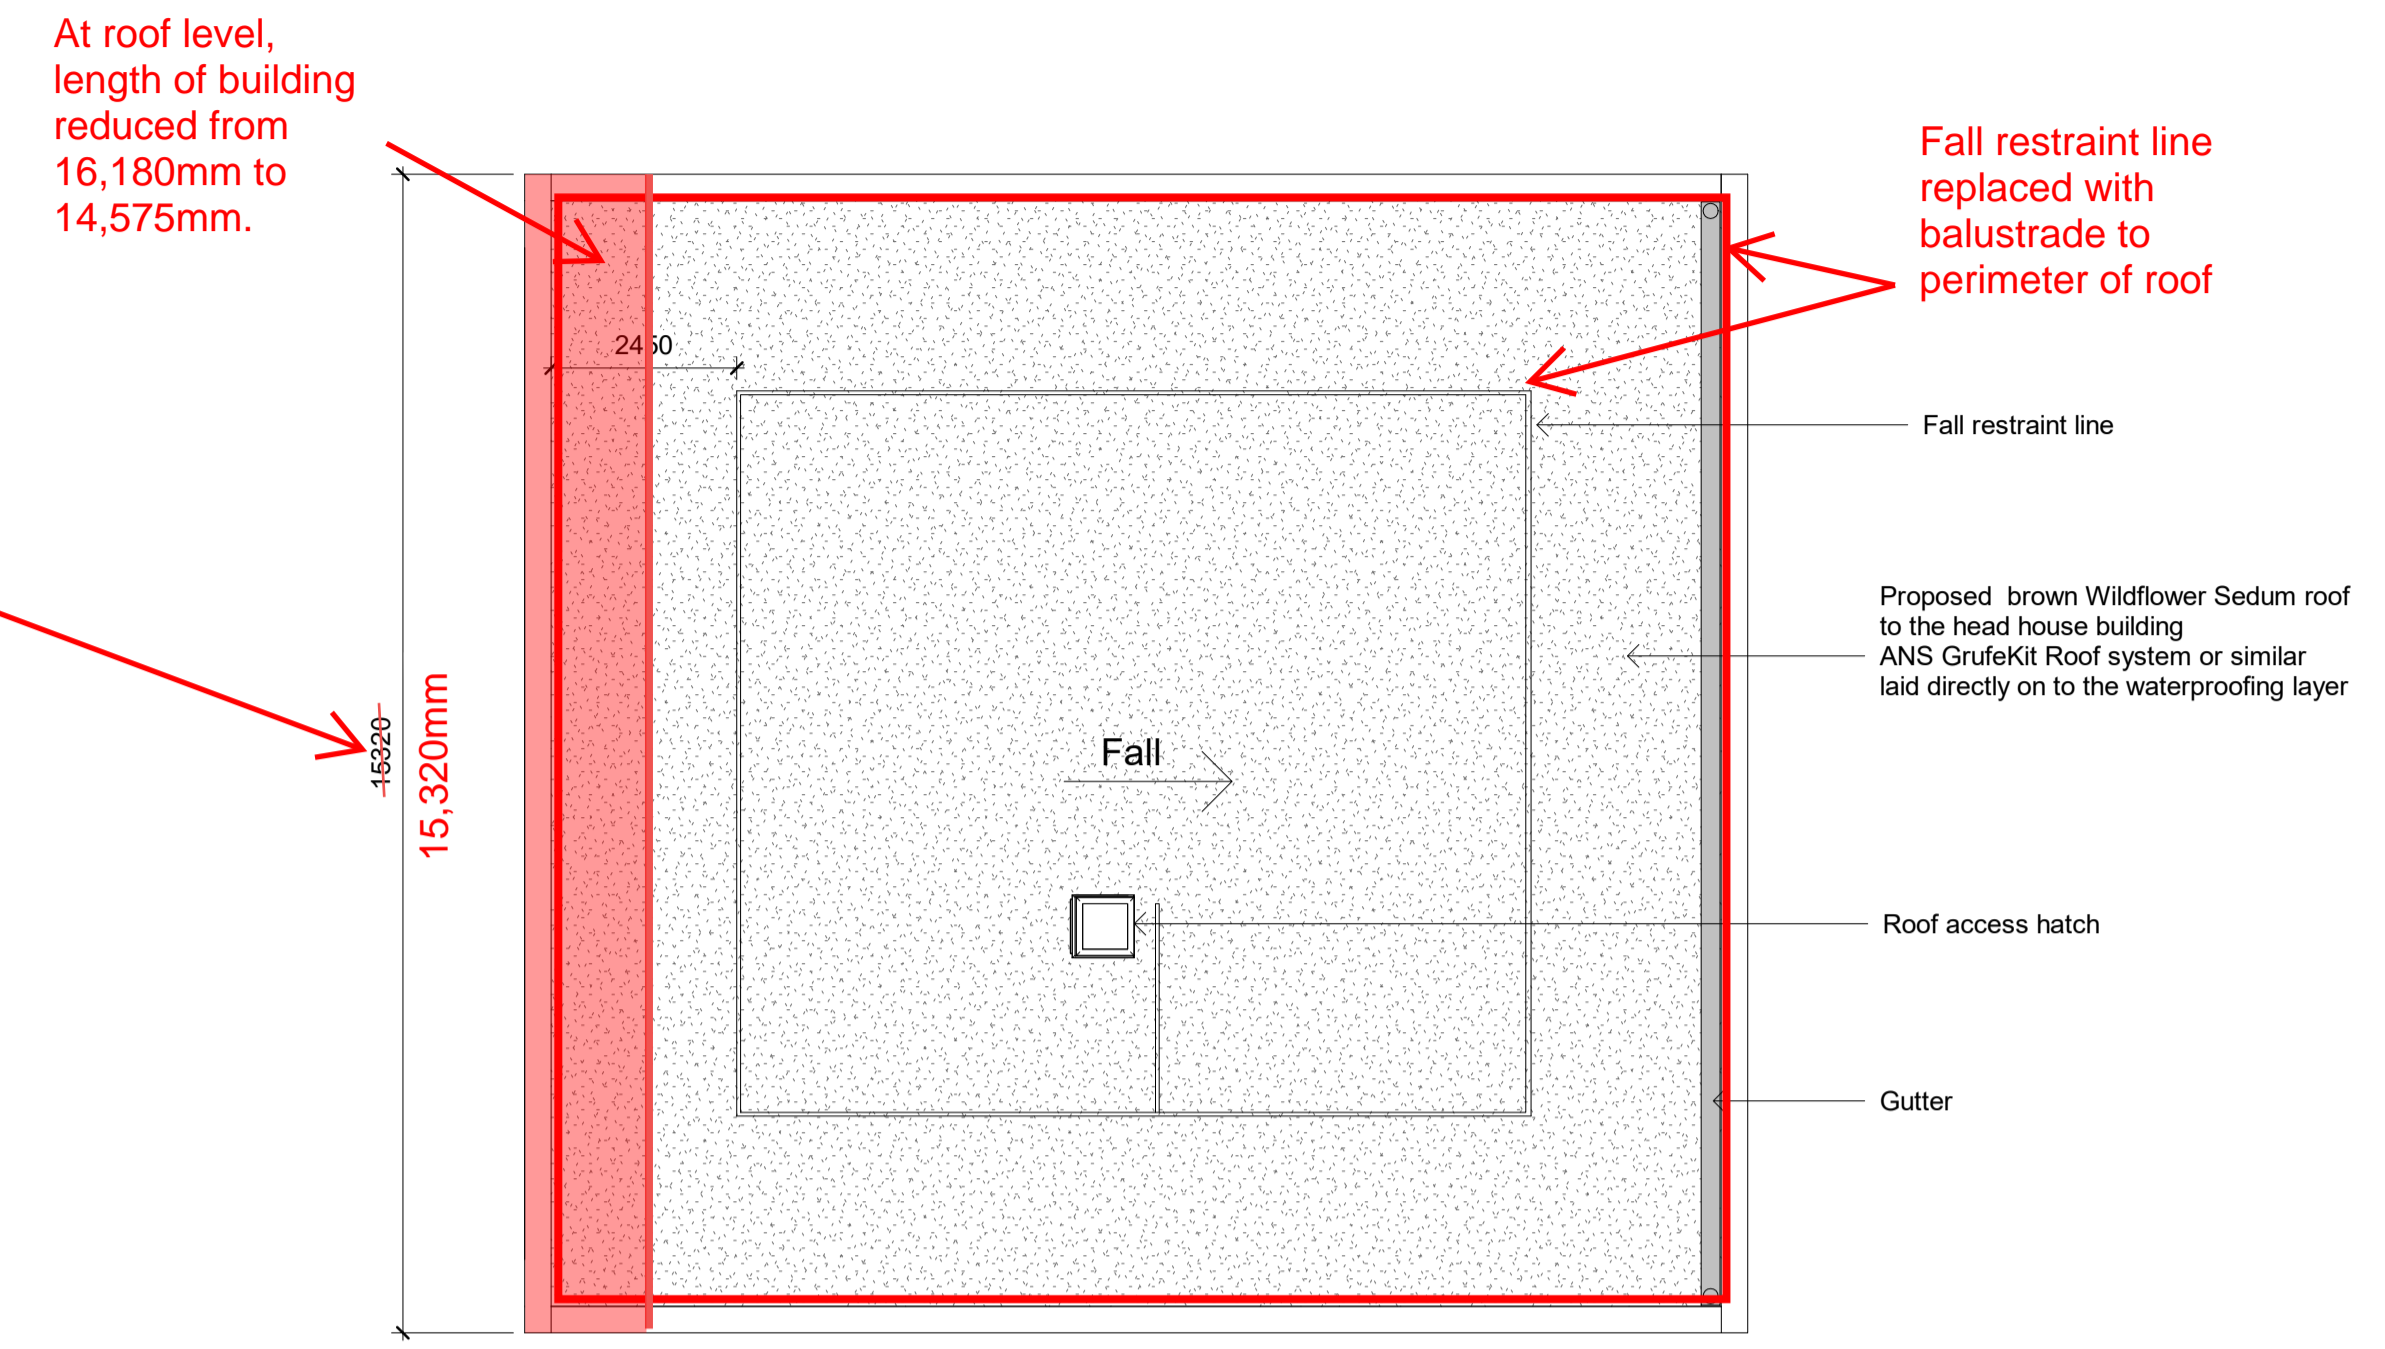

**003 Roof Level**  
1 : 100

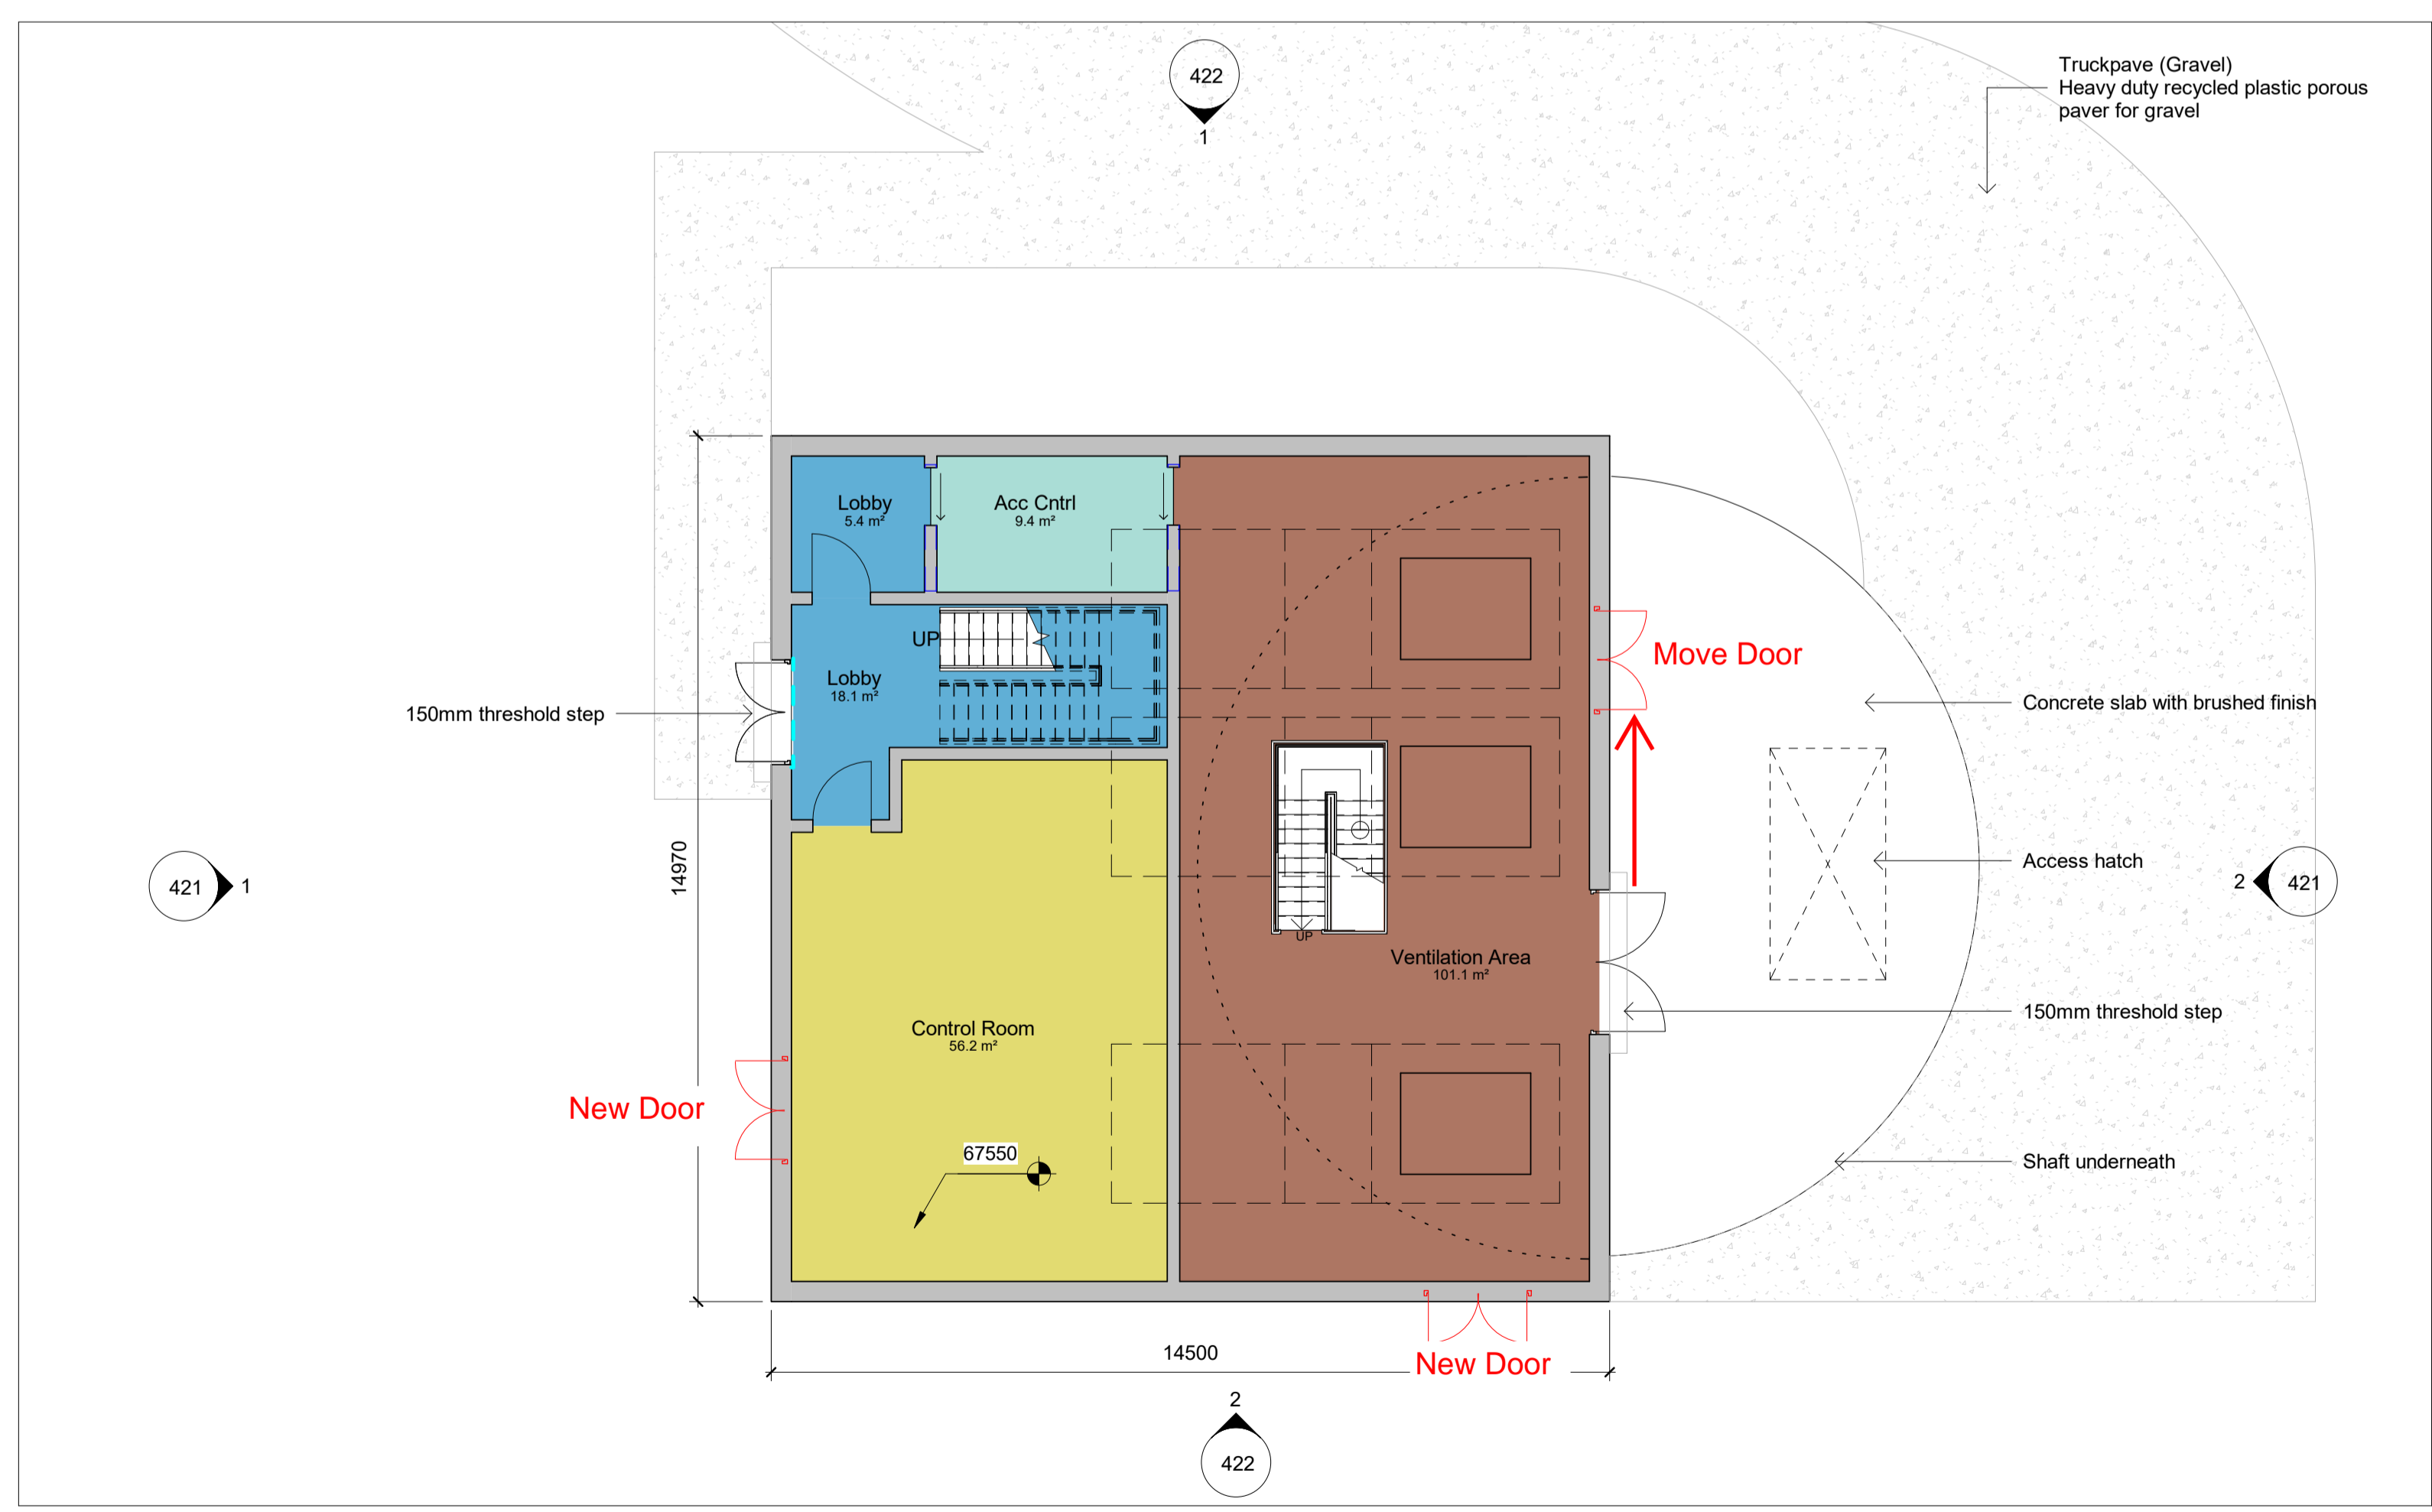

**001 Ground Level**  
1 : 100

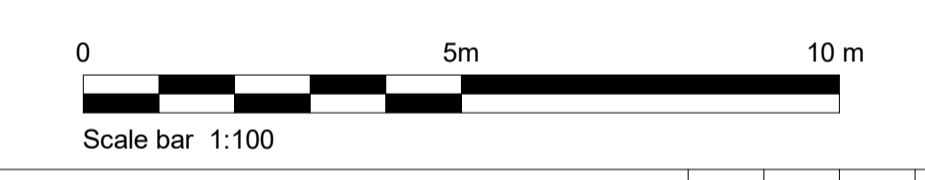

Rev	Description	Cre'd	Ch'kd	App'd	Date
F	PLANNING APPLICATION	JR	CM	SS	21.11.2018
E	DRAFT PLANNING	JR	CM	SS	16.11.2018
D	DRAFT PLANNING	JR	CM	SS	02.11.2018
C	DRAFT PLANNING DRAWING - COMMENTS	JR	JA	SS	22.08.2018
B	DRAFT PLANNING DRAWING	JR	CM	SS	15.08.2018
A		GF	TH	SS	30.04.2018

Mourbatten House, Basing View, Basingstoke RG21 4HJ, UK  
T +44 (0) 1256 318 800 wsp.com

30 Kings Bench Street, London SE1 0QX, UK  
T +44 (0) 203 7233 0303 admin@freddy-pollard.co.uk

nationalgrid

National Grid plc, Warwick Technology Park, Galloway Hill, Warwick, CV34 6DA

Master Scheme No: 11524	Sub-Scheme No: PROJECT	Site: PROJECT WIDE
----------------------------	---------------------------	-----------------------

Scheme Name:  
LPT2

Document Title:  
ELTHAM HEAD HOUSE  
PROPOSED FLOOR PLANS & ROOF PLAN


Created by: JR	Date: 21/11/18	Checked by: CM	Date: 21/11/18	Approved by: SS	Date: 21/11/18
Development Eng: NK	Document Type: ARC	Scale: 1 : 100	Format: A1	Sheet(s): 1 OF 1	Rev: F

National Grid Document Number:  
PDD-11524-ARC- 411


Amendment Markup

THIS MAP IS REPRODUCED FROM ORDNANCE SURVEY © MATERIAL BY WSP Group ON BEHALF OF National Grid WITH THE PERMISSION OF THE CONTROLLER OF HER MAJESTY'S STATIONARY OFFICE.  
 ©CROWN COPYRIGHT. UNAUTHORISED REPRODUCTION INFRINGES CROWN COPYRIGHT AND MAY LEAD TO PROSECUTION OR CIVIL PROCEEDINGS  
 LICENCE NUMBER: 100024241




- NOTES:
1. THIS DRAWING IS TO BE READ IN CONJUNCTION WITH ALL OTHER RELEVANT DRAWINGS, DOCUMENTS AND SPECIFICATIONS.
  2. DO NOT SCALE OFF THIS DRAWING. WORK ONLY TO DIMENSIONS SHOWN.

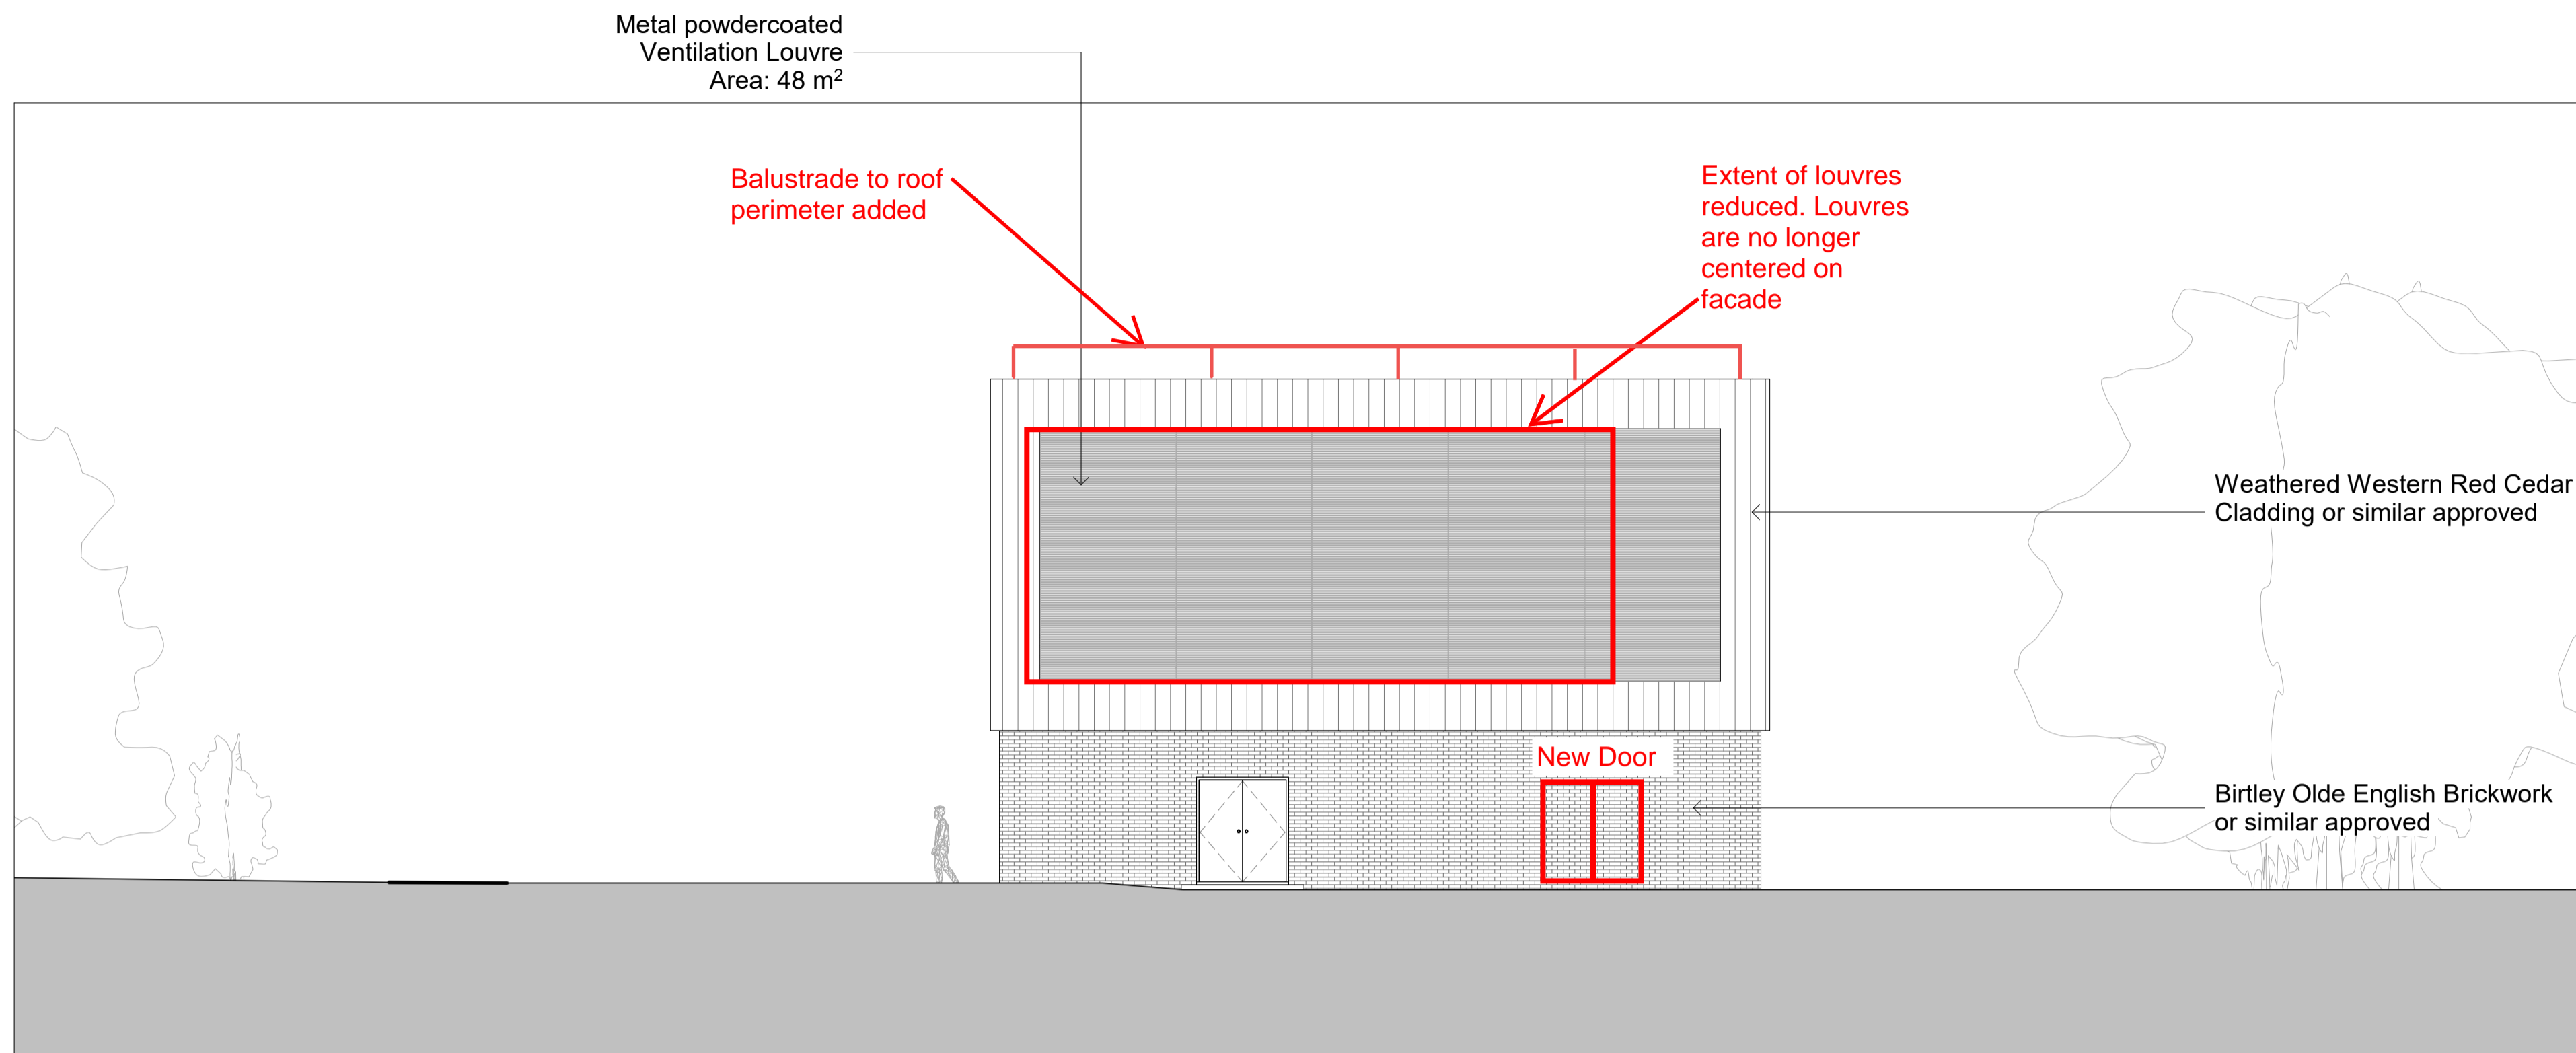

**Proposed West Elevation**  
1 : 100

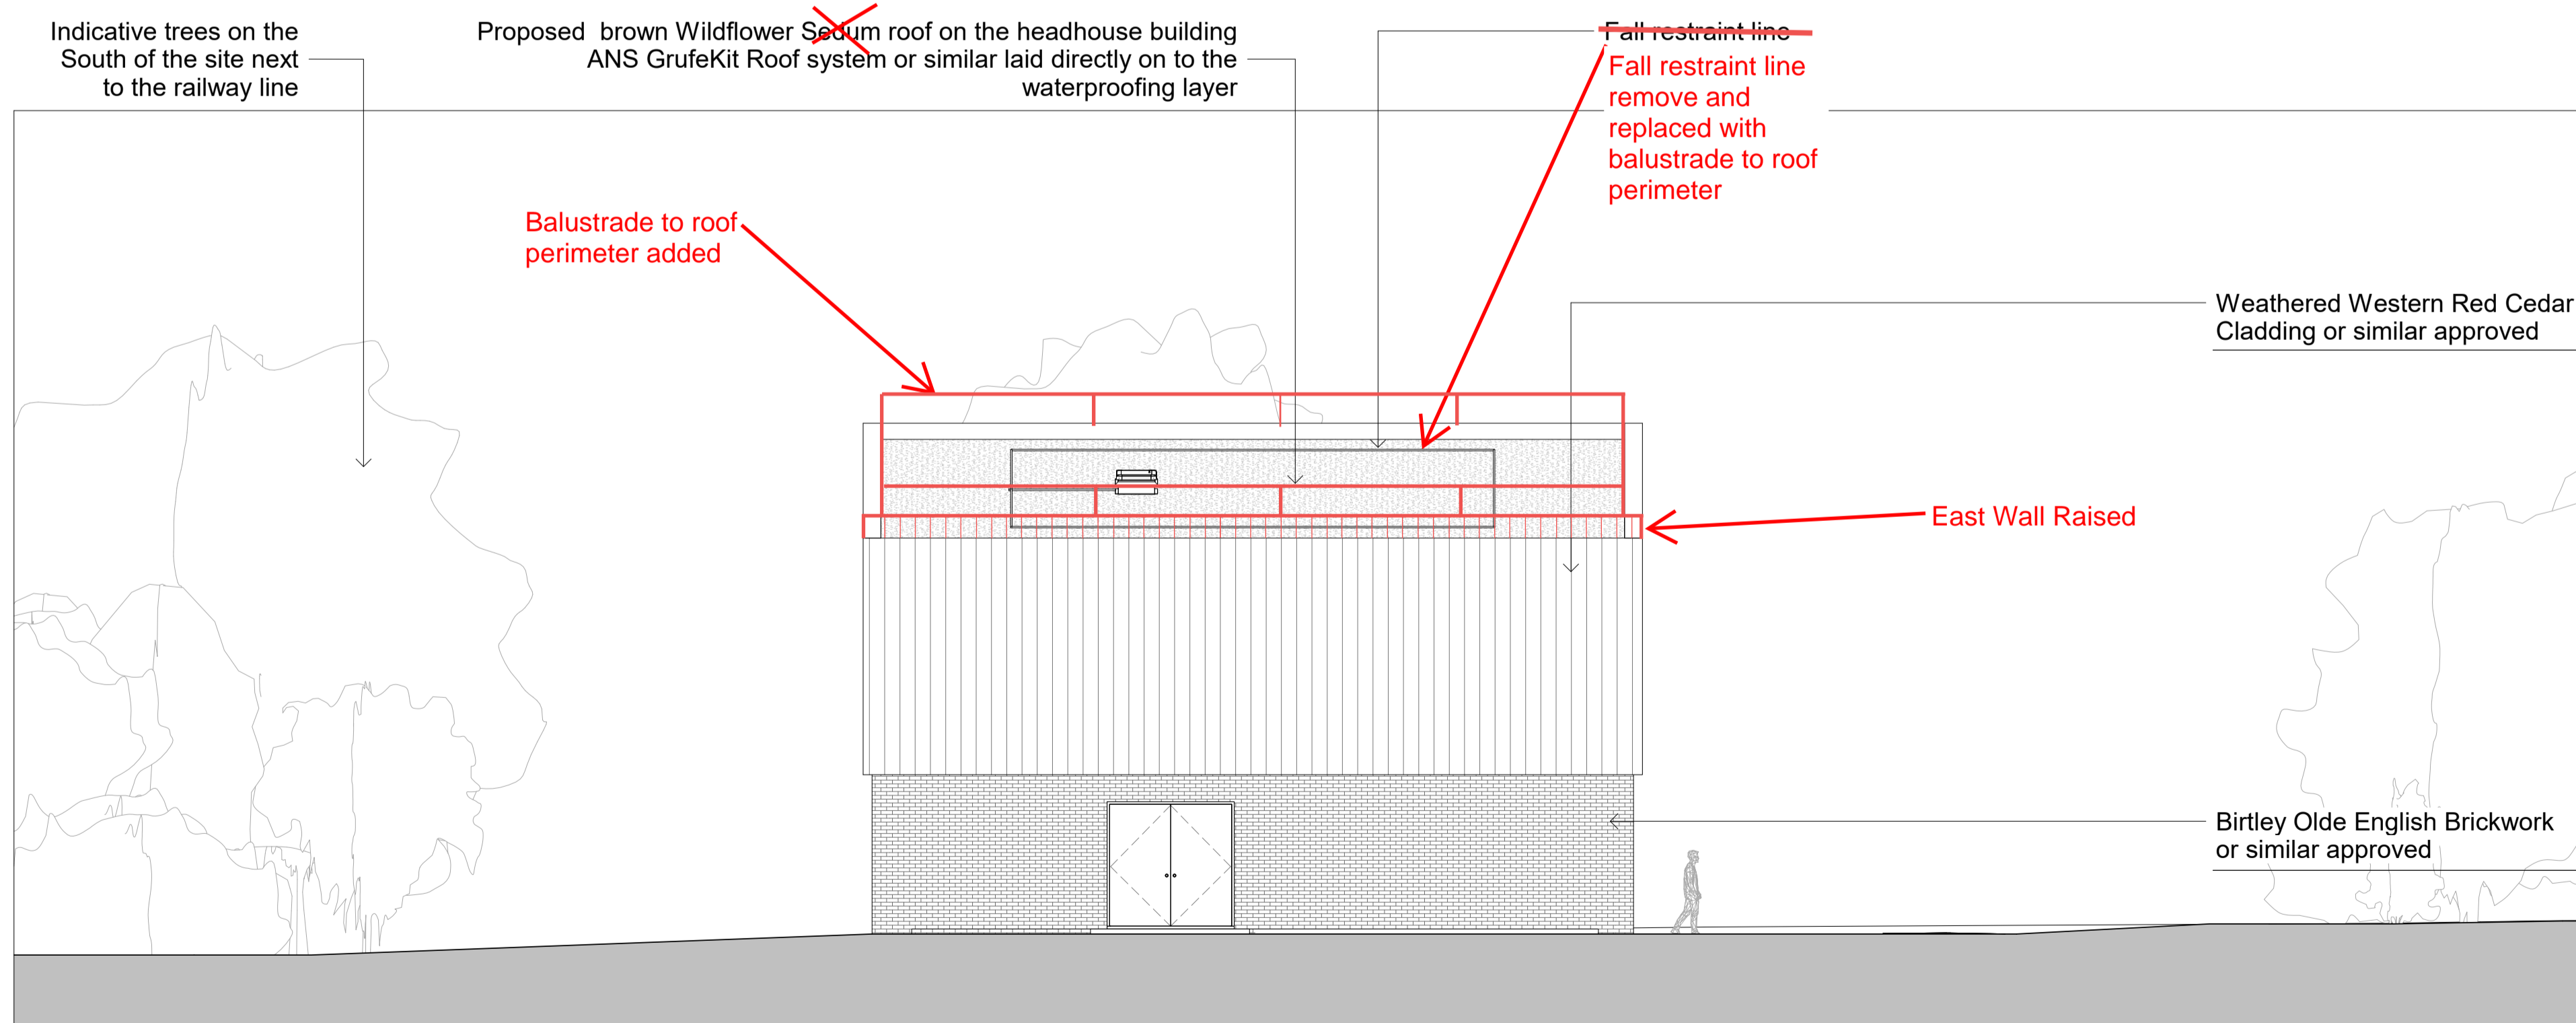

**Proposed East Elevation**  
1 : 100

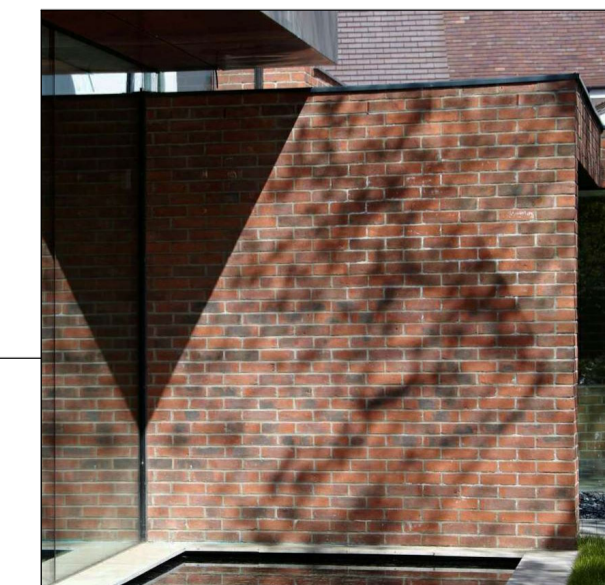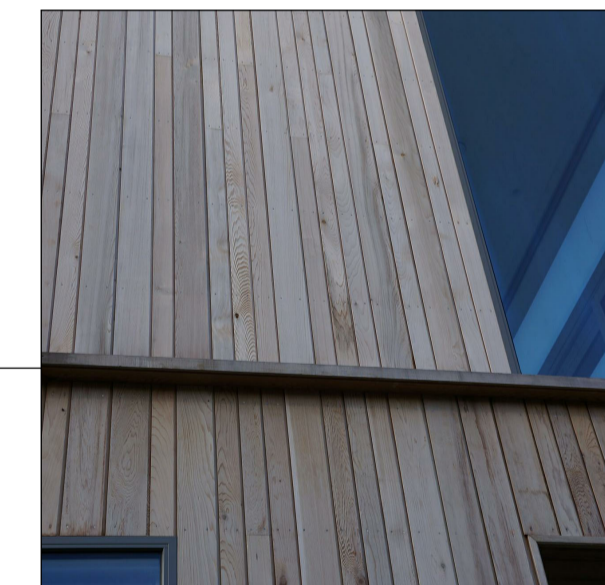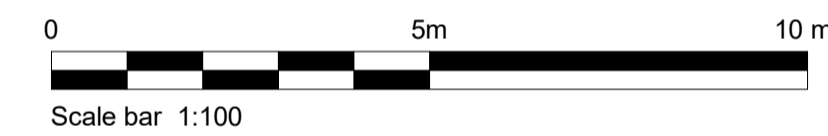

Rev	Description	Cre'd	Ch'g'd	App'd	Date
F	PLANNING APPLICATION	JR	CM	SS	21.11.2018
E	DRAFT PLANNING	JR	CM	SS	16.11.2018
D	DRAFT PLANNING	JR	CM	SS	02.11.2018
C	DRAFT PLANNING DRAWING - COMMENTS	JR	JA	SS	22.08.2018
B	DRAFT PLANNING DRAWING	JR	CM	SS	15.08.2018
A		GF	TH	SS	30.04.2018

**wsp**  
 Mournbatten House, Basing View, Basingstoke RG21 4JL, UK  
 T +44 (0) 1256 318 800 wsp.com

**fp**  
 30 Kings Bench Street, London SE1 0QX, UK  
 T +44 (0)20 7253 0303 admin@freedayspollard.co.uk

**nationalgrid**  
 National Grid plc, Warwick Technology Park, Galloway Hill, Warwick, CV34 6DA

Master Scheme No: 11524	Sub-Scheme No: PROJECT	Site: PROJECT WIDE
----------------------------	---------------------------	-----------------------

Scheme Name:  
LPT2

Document Title:  
ELTHAM HEAD HOUSE

PROPOSED ELEVATIONS SHEET 1 FO 2


Created by: JR	Date: 21/11/18	Checked by: CM	Date: 21/11/18	Approved by: SS	Date: 21/11/18
Development Eng: NR	Document Type: ARC	Scale: 1 : 100	Format: A1	Sheet(s): 1 OF 1	Rev: F

National Grid Document Number:  
PDD-11524-ARC- 421


FEED Document Number:  
**Amendment Markup**

THIS MAP IS REPRODUCED FROM ORDNANCE SURVEY © MATERIAL BY WSP Group ON BEHALF OF National Grid WITH THE PERMISSION OF THE CONTROLLER OF HER MAJESTY'S STATIONARY OFFICE.  
 ©CROWN COPYRIGHT. UNAUTHORISED REPRODUCTION INFRINGES CROWN COPYRIGHT AND MAY LEAD TO PROSECUTION OR CIVIL PROCEEDINGS  
 LICENCE NUMBER: 100024241




- NOTES:
1. THIS DRAWING IS TO BE READ IN CONJUNCTION WITH ALL OTHER RELEVANT DRAWINGS, DOCUMENTS AND SPECIFICATIONS.
  2. DO NOT SCALE OFF THIS DRAWING. WORK ONLY TO DIMENSIONS SHOWN.

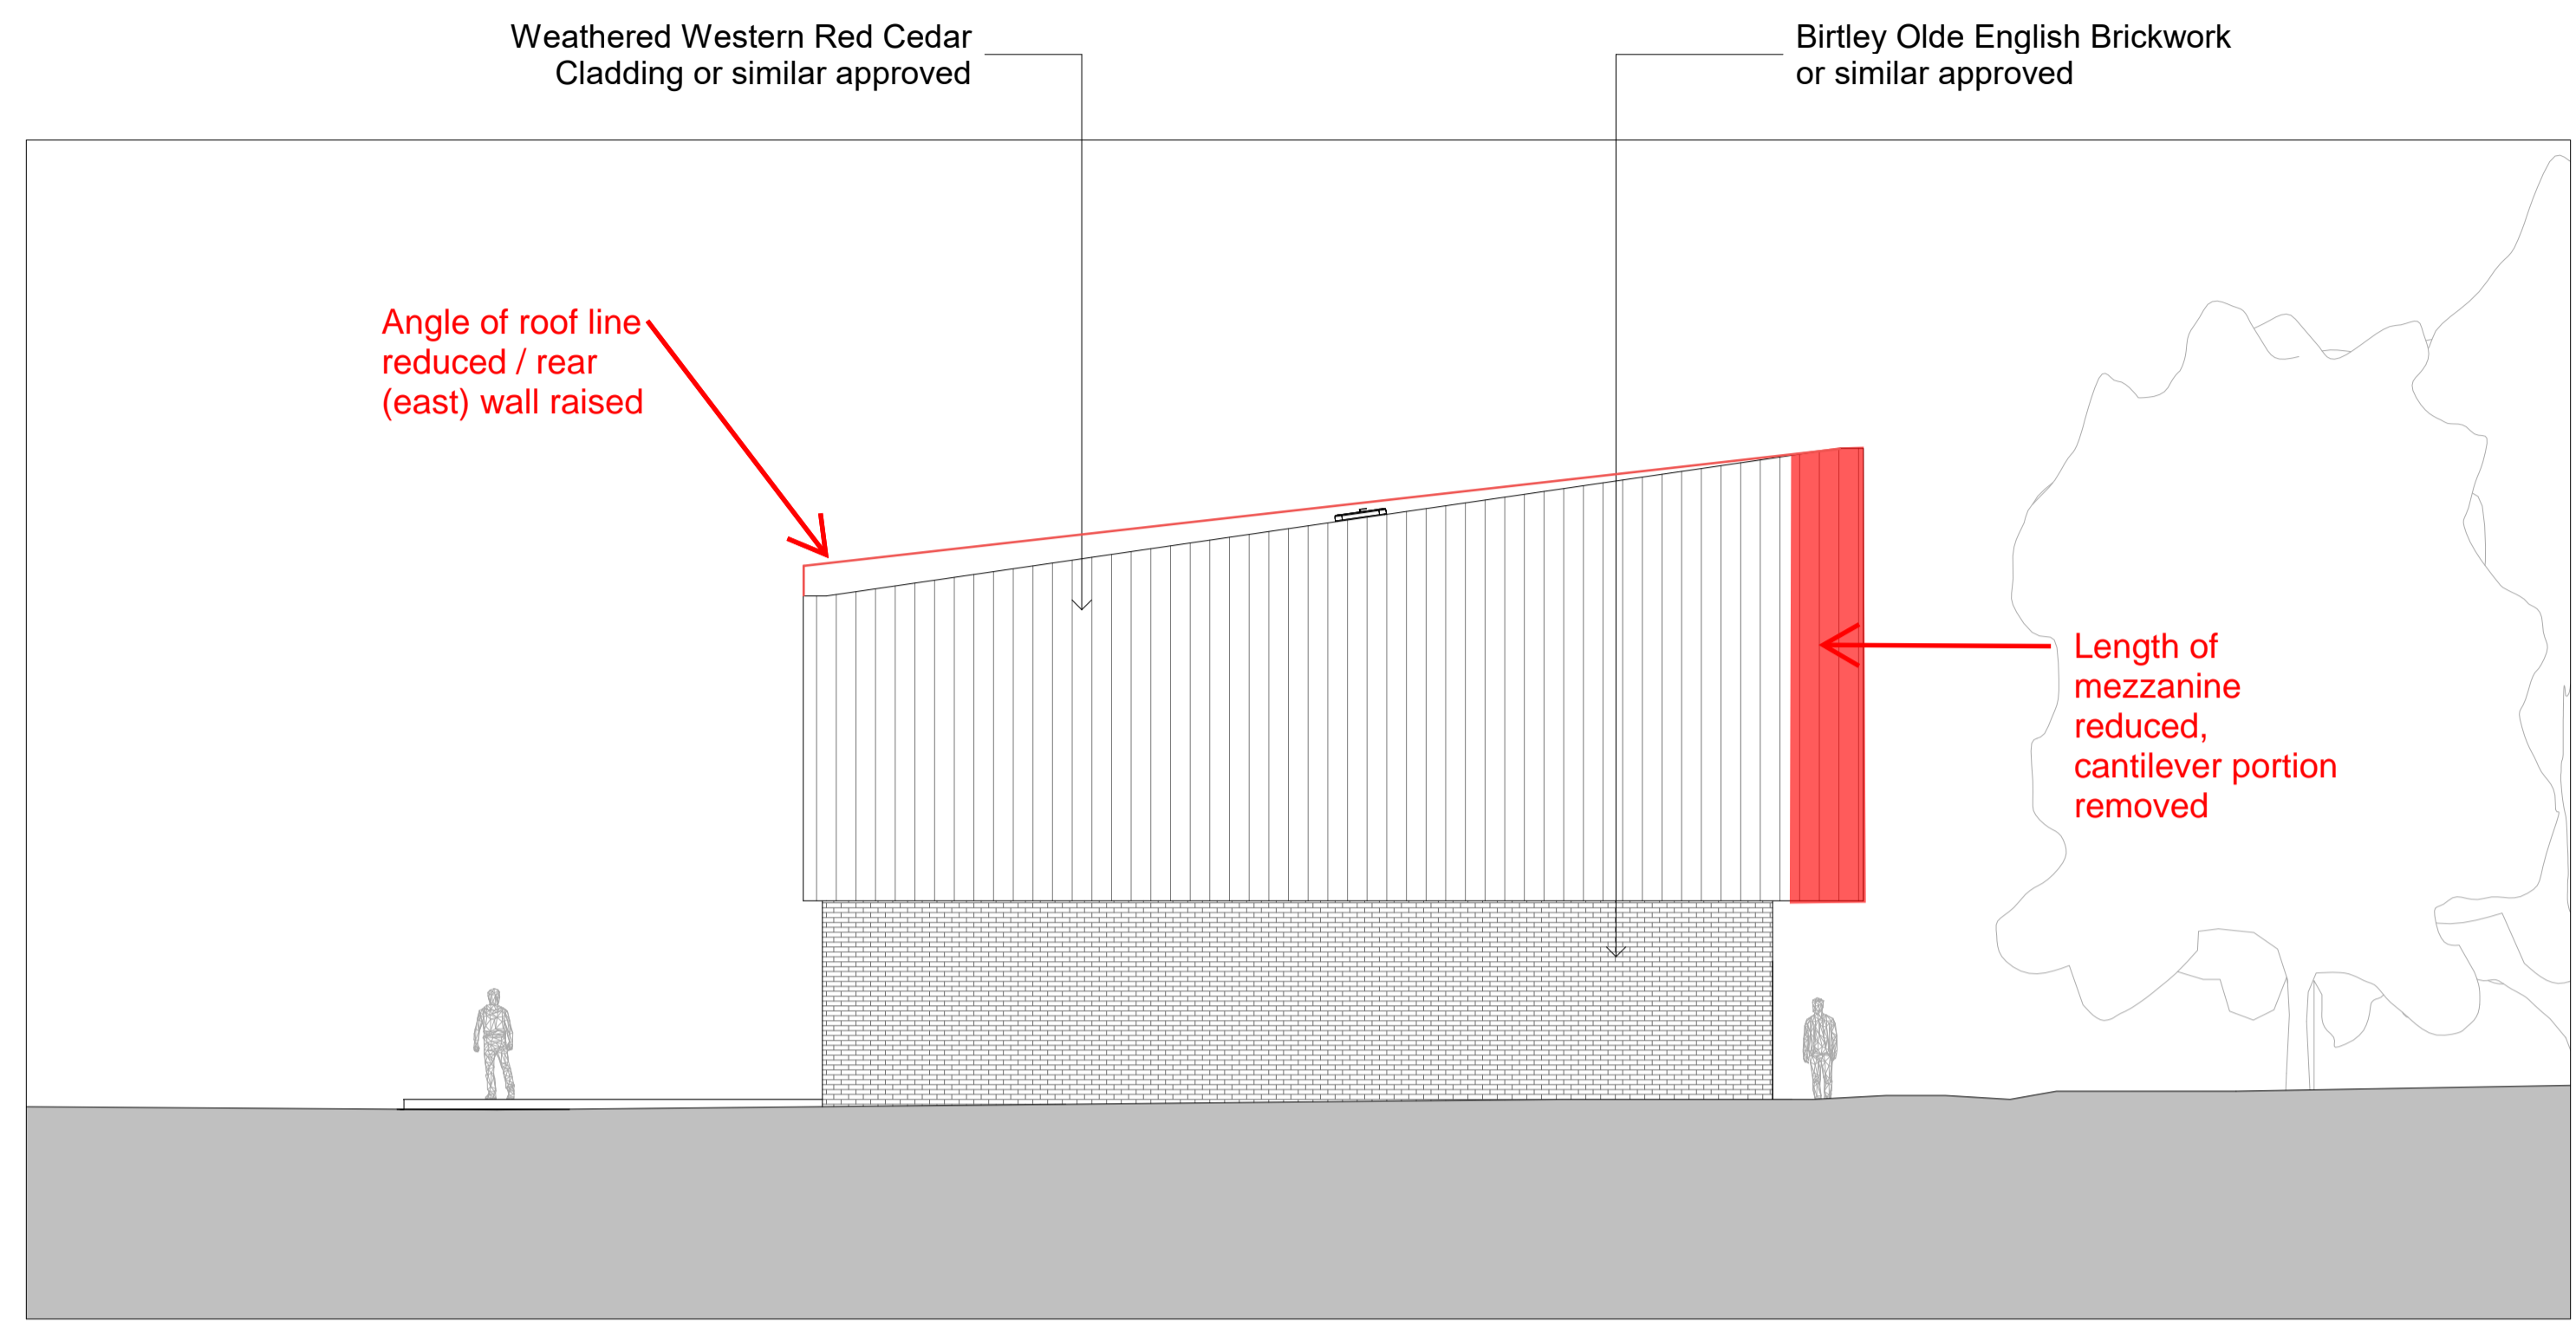


**Proposed North Elevation**  
1 : 100

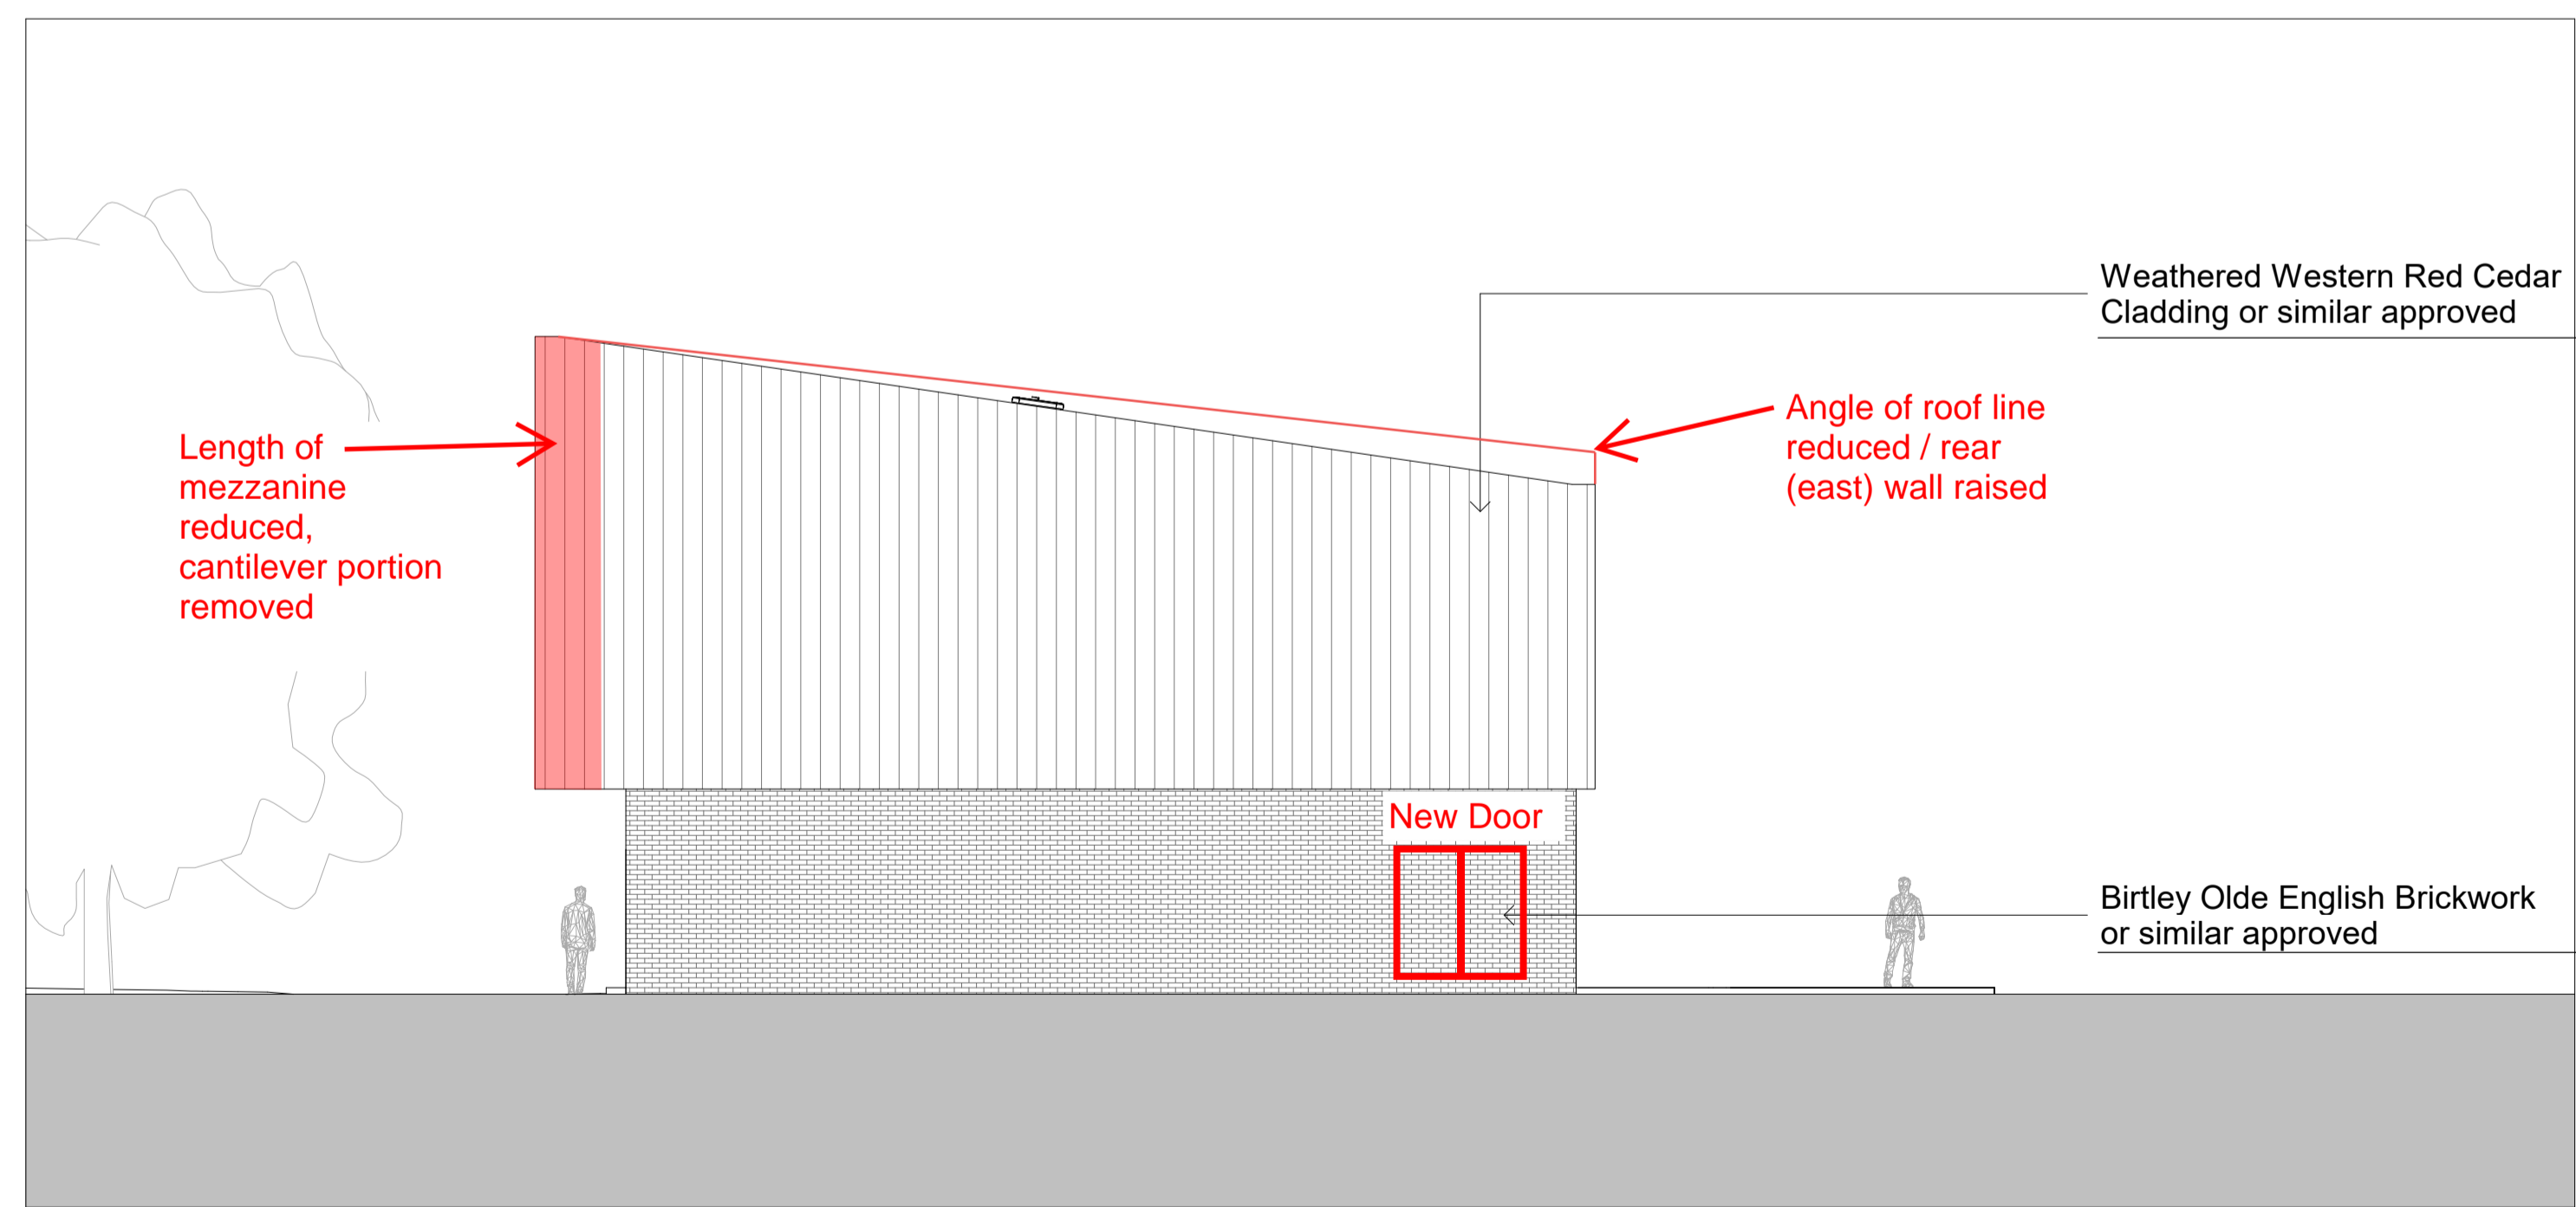


**Proposed South Elevation**  
1 : 100

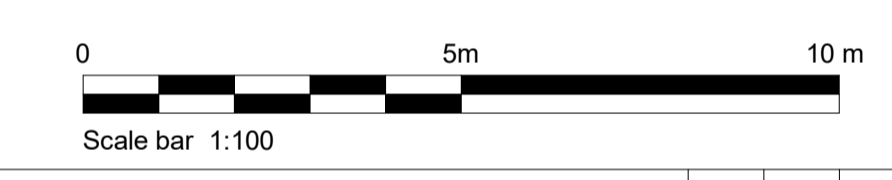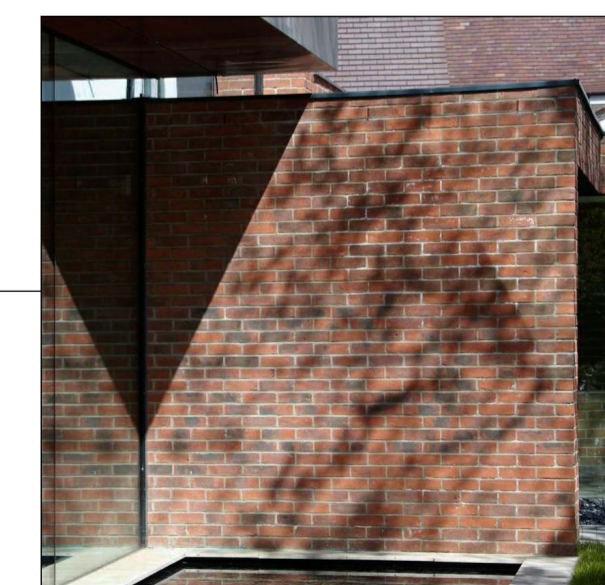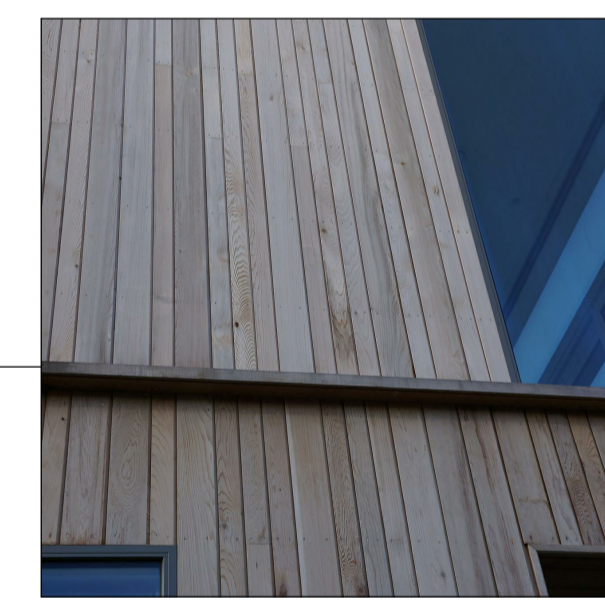

Rev	Description	Cre'd	Ch'kd	App'd	Date
F	PLANNING APPLICATION	JR	CM	SS	21.11.2018
E	DRAFT PLANNING	JR	CM	SS	16.11.2018
D	DRAFT PLANNING	JR	CM	SS	02.11.2018
C	DRAFT PLANNING DRAWING - COMMENTS	JR	JA	SS	22.08.2018
B	DRAFT PLANNING DRAWING	JR	CM	SS	15.08.2018
A		GF	TH	SS	30.04.2018



WSP  
Mourthatten House, Basing View, Basingstoke RG21 4HJ, UK  
T +44 (0) 1256 318 800 wsp.com



fp  
30 Kings Bench Street, London SE1 0QX, UK  
T +44 (0)20 7253 0303 admin@freeddy-pollard.co.uk



National Grid plc, Warwick Technology Park, Gallews Hill, Warwick, CV34 6DA

Master Scheme No: 11524	Sub-Scheme No: PROJECT	Site: PROJECT WIDE
----------------------------	---------------------------	-----------------------

Scheme Name:  
LPT2

Document Title:  
ELTHAM HEAD HOUSE  
PROPOSED ELEVATIONS SHEET 2 OF 2

Created by: JR	Date: 21/11/18	Checked by: CM	Date: 21/11/18	Approved by: SS	Date: 21/11/18
Development Eng: NR	Document Type: ARC	Scale: 1 : 100	Format: A1	Sheet(s): 1 OF 1	Rev: F


National Grid Document Number:  
PDD-11524-ARC- 422

Amendment Markup




FEED Document Number:

THIS MAP IS REPRODUCED FROM ORDNANCE SURVEY © MATERIAL BY WSP Group ON BEHALF OF National Grid WITH THE PERMISSION OF THE CONTROLLER OF HER MAJESTY'S STATIONARY OFFICE.  
 ©CROWN COPYRIGHT. UNAUTHORISED REPRODUCTION INFRINGES CROWN COPYRIGHT AND MAY LEAD TO PROSECUTION OR CIVIL PROCEEDINGS  
 LICENCE NUMBER: 100024241

- NOTES:
1. THIS DRAWING IS TO BE READ IN CONJUNCTION WITH ALL OTHER RELEVANT DRAWINGS, DOCUMENTS AND SPECIFICATIONS.
  2. DO NOT SCALE OFF THIS DRAWING. WORK ONLY TO DIMENSIONS SHOWN.

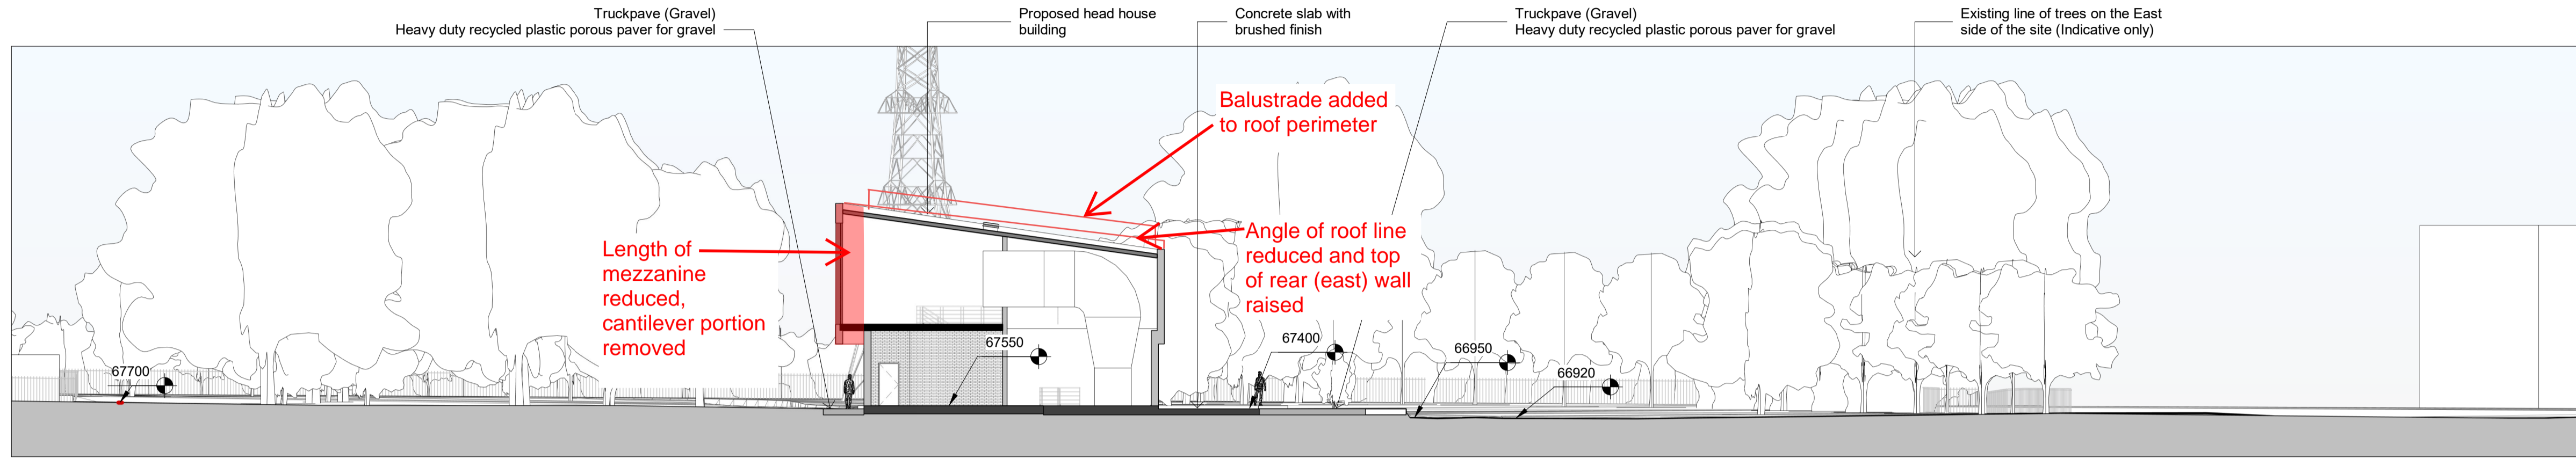

**East West Site Section**  
 1 : 200

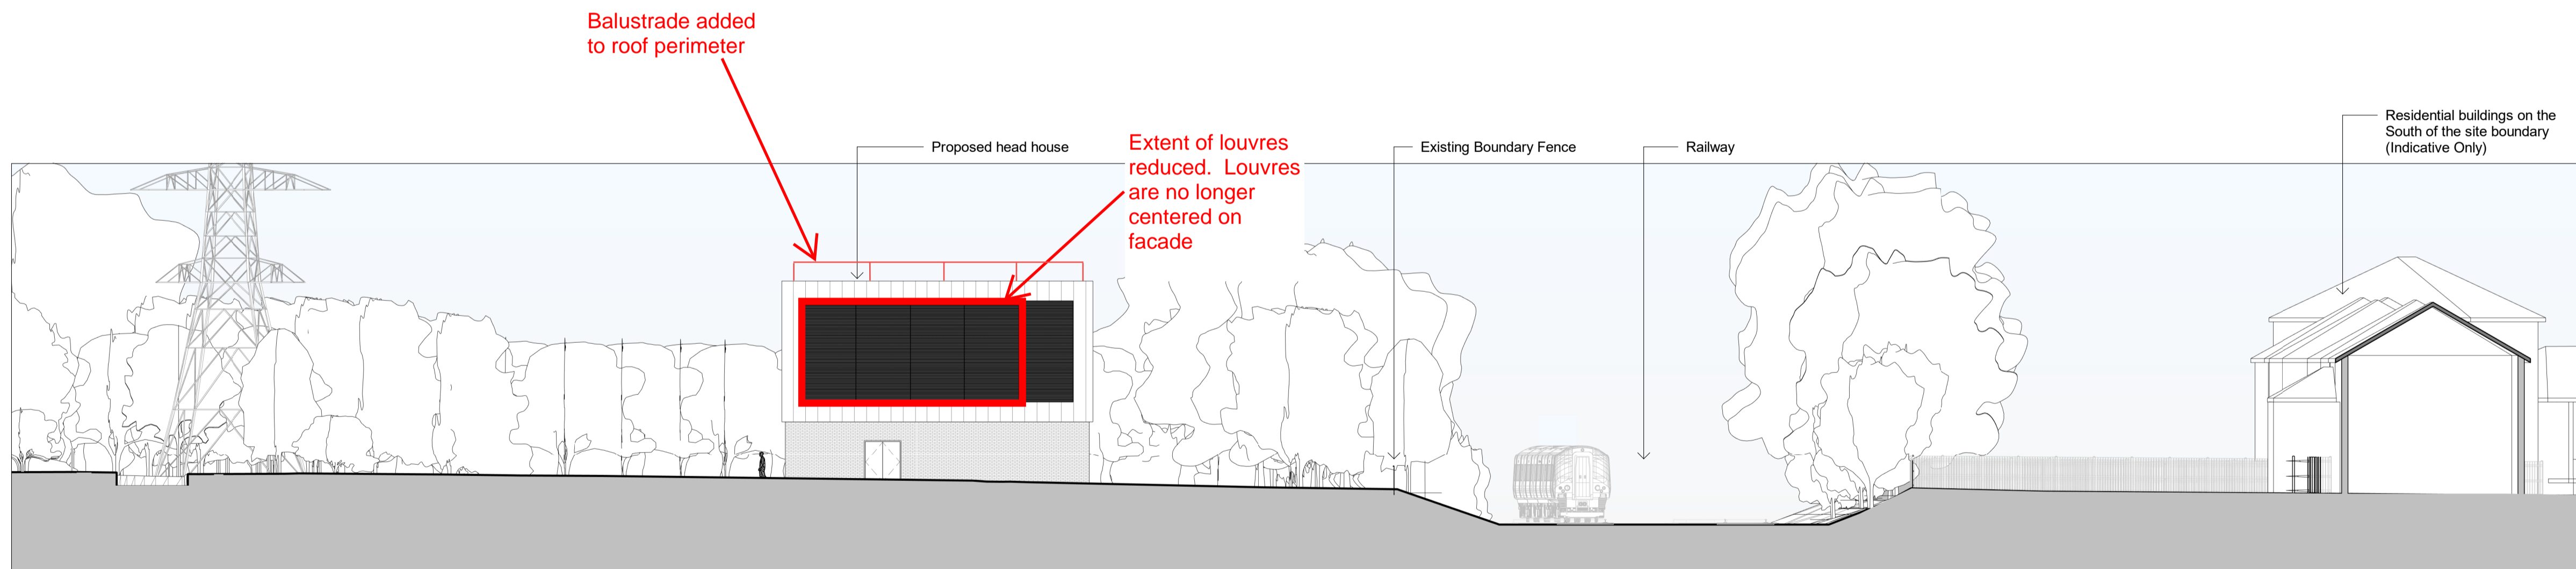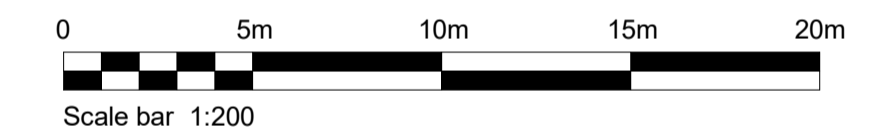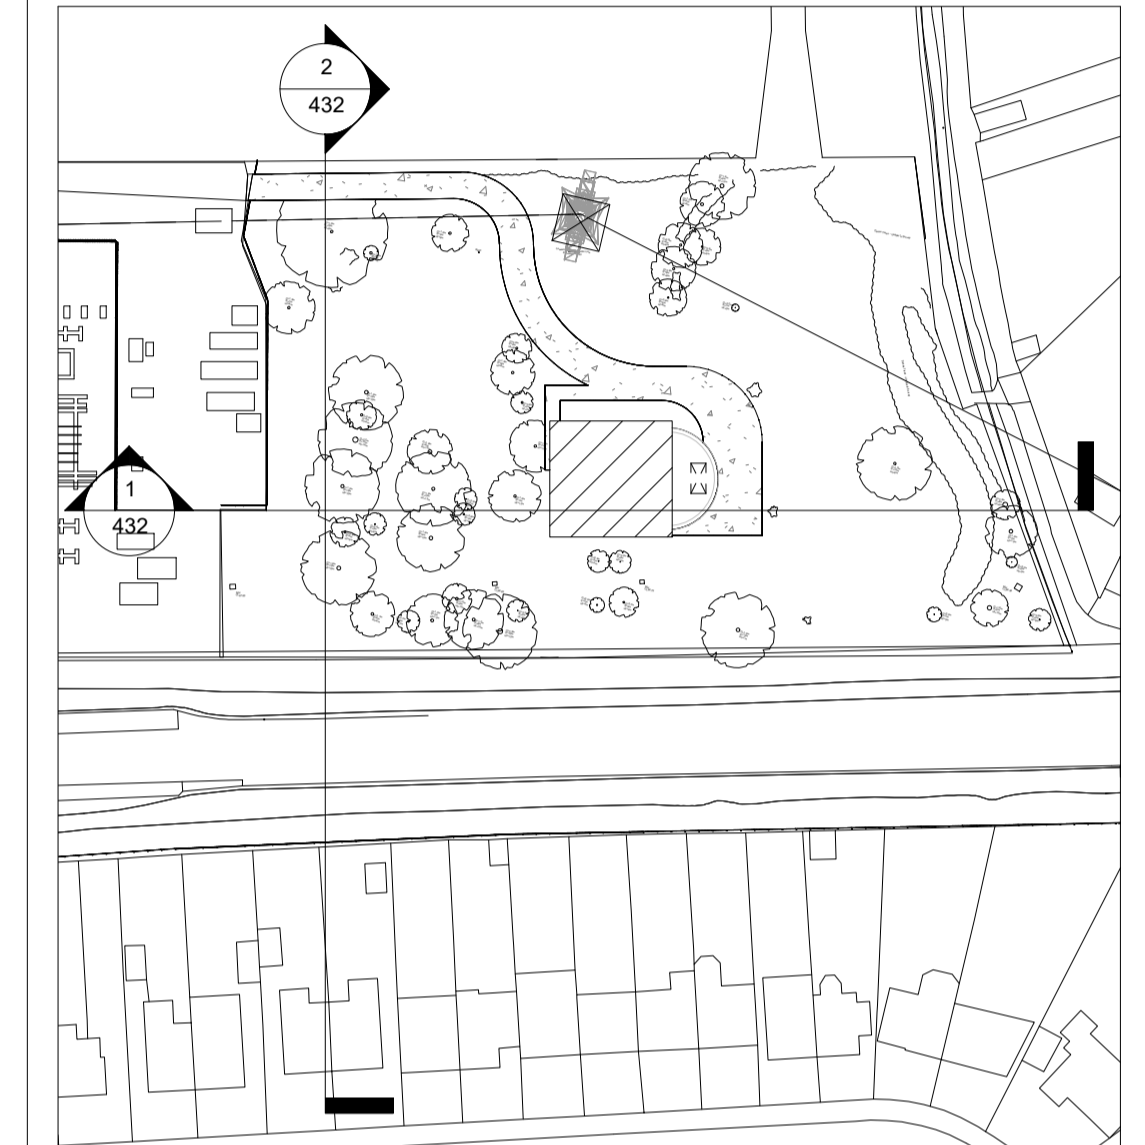

**North South Site Section**  
 1 : 200

Rev	Description	Cre'd	Ch'kd	App'd	Date
F	PLANNING APPLICATION	JR	CM	SS	21.11.2018
E	DRAFT PLANNING	JR	CM	SS	16.11.2018
D	DRAFT PLANNING	JR	CM	SS	02.11.2018
C	DRAFT PLANNING DRAWING - COMMENTS	JR	JA	SS	22.08.2018
B	DRAFT PLANNING DRAWING	JR	CM	SS	15.08.2018
A		GF	TH	SS	30.04.2018

**wsp**  
 Mournhallen House, Basing View, Basingstoke RG21 4HJ, UK  
 T +44 (0) 1256 318 800  
 wsp.com

**fp**  
 30 Kings Bench Street, London SE1 0QX, UK  
 T +44 (0)20 7253 0303  
 admin@freedayspollard.co.uk

**nationalgrid**  
 National Grid plc, Warwick Technology Park, Galloway Hill, Warwick, CV34 6DA

Master Scheme No: 11524	Sub-Scheme No: PROJECT	Site: PROJECT WIDE
----------------------------	---------------------------	-----------------------

Scheme Name:  
LPT2

Document Title:  
ELTHAM HEAD HOUSE  
PROPOSED SECTIONS

Created by: JR	Date: 21/11/18	Checked by: CM	Date: 21/11/18	Approved by: SS	Date: 21/11/18
-------------------	-------------------	-------------------	-------------------	--------------------	-------------------

Development Eng: NR	Document Type: ARC	Scale: 1 : 200	Format: A1	Sheet(s): 1 OF 1	Rev: F
------------------------	-----------------------	-------------------	---------------	---------------------	-----------

National Grid Document Number:  
PDD-11524-ARC- 432

FEED Document Number:  
**Amendment Markup**