
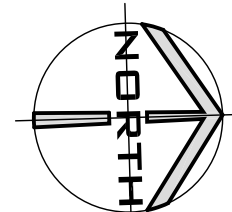


SITE PLAN - SOUTH END - AS INSTALLED 1:500

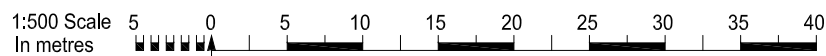

SHEET SIZE
A3

PROJECT
St. Catherine's College
Reinforced Autoclaved Aerated Concrete Roofs
Temporary Lecture Theatre Marquees &
Additional Food Preparation Units
CLIENT
St Catherine's College
TITLE
Site Plan - South End - As Installed

Pendery Architecture & Heritage Ltd

23 Orchard Road Hook Norton Banbury Oxon OX15 5LX
d.pendery@btinternet.com 07482 557577

ALL DIMENSIONS IN MILLIMETRES UNLESS STATED OTHERWISE. DO NOT SCALE EXCEPT FOR PLANNING PURPOSES. USE GIVEN DIMENSIONS ONLY.
LATEST REVISION

SCALE @ A3
1:500
DATE
Jan'24
© Pendery Architecture & Heritage Ltd

DWG NO.
2315-41
REV