
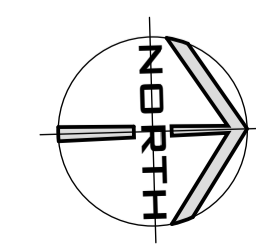


LECTURE THEATRE MARQUEE FLOOR PLAN - AS INSTALLED 1:100

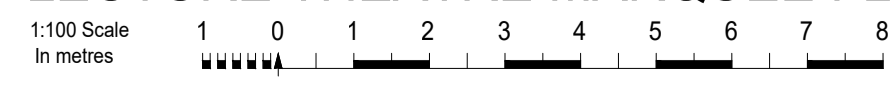

St. Catherine's College
 Reinforced Autoclaved Aerated Concrete Roofs
 Temporary Lecture Theatre Marquees &
 Additional Food Preparation Units
 Client: St. Catherine's College
 Project: Lecture Theatre Marquee Floor Plan - As Installed

Pendery Architecture & Heritage Ltd
 23 Orchard Road Hook Norton Banbury Oxon OX15 5LX
 d.pendery@btinternet.com 07482 557577
ALL DIMENSIONS UNLESS OTHERWISE STATED OTHERWISE. DO NOT SCALE EXCEPT FOR PLANNED PURPOSES. USE GRID DIMENSIONS ONLY.
 LATEST REVISION: 1:100 DATE: JULY 24 DRAWING NO: 2315-43

A1