



PHOTOGRAPHS
(as built)

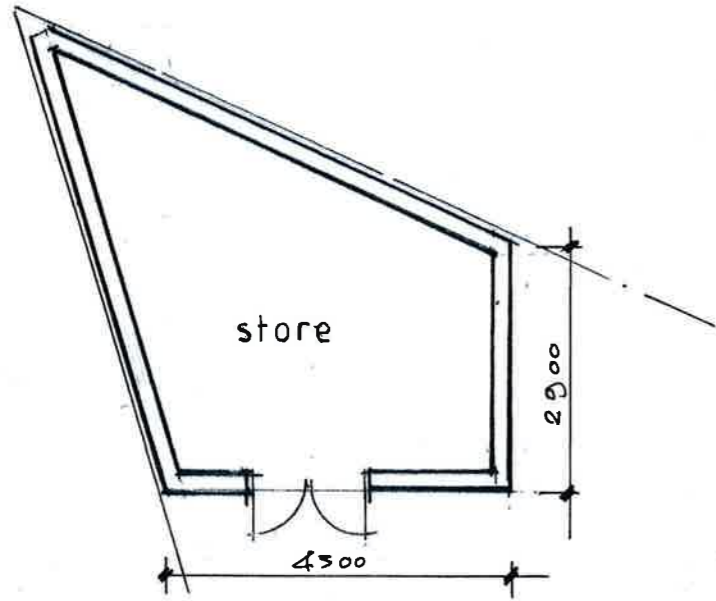


OUTBUILDING PLAN
(as built)


- felt covered flat roof
- rendered concrete blockwork
- uPVC framed double glazed doors

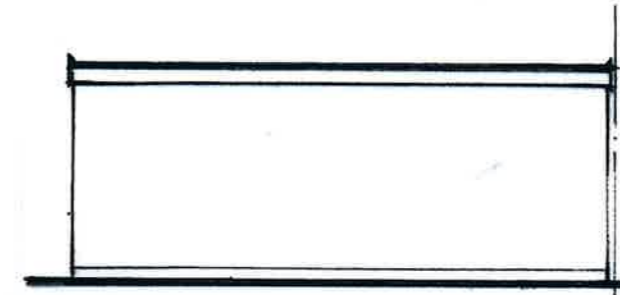

REAR ELEVATION
(as built)

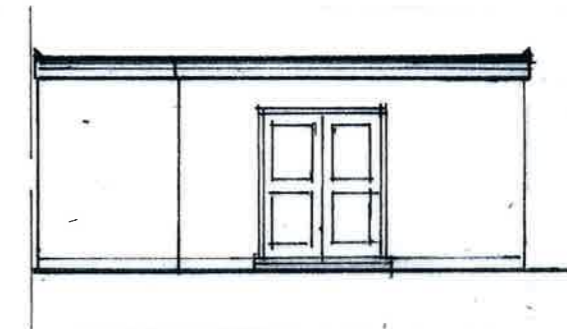

FRONT ELEVATION
(as built)

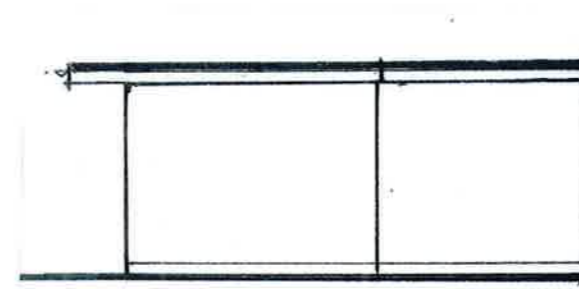

SIDE ELEVATION
(as built)



Scale 1 : 100 @ A3 paper size

Job:	135 ARAGLEN AVENUE SOUTH OCKENDON ESSEX RM15 5DQ	Date: Mar 2024
Drawing No. PP/02	ARCHITECTURAL SERVICES	Scale: 1:100
		Mobile: 07400 444 070