



- Key**
- Existing**
- Woodland and tree groups
  - Trees
  - Hedgerow
  - Pond
  - Existing post and wire stockproof fence
- Proposed**
- Application site boundary
  - Landscape Buffer Zones (refer to Parameter Plan and Landscape Strategy)
  - Ecological Mitigation Zone (refer to Parameter Plan and Landscape Strategy)
  - Woodland planting
  - Woodland edge planting
  - Standard tree planting
  - General amenity grassland (existing grassland to be retained where ground undisturbed)
  - General species-rich grassland
  - Tussock grassland and wildflower mix (to maximise habitat value for amphibians)
  - Pond edge wildflower mix
  - Mixed native hedgerow
  - Extent of earthworks and proposed contours
  - Meadow mixture for wetlands (if attenuation basin here, otherwise general species-rich grassland seeding)
  - Wildlife ponds (planted with marginal and aquatic plants and seeded with pond edge wildflower mixture)
  - Marginal aquatic planting to edges of wildlife ponds
  - Newt hibernacula
  - Footpath routes surfaced in buff self-binding gravel
  - Footpath routes surfaced in tarmac
  - Post and wire fence
  - Galvanised metal field access gate

Landscape Buffer Zones and Ecological Mitigation Zone derived from Parameter Plan as the green areas shown below (RPS drawing ref. NK018161-SK062 Rev H)



Reproduced by permission of Ordnance Survey on behalf of Her Majesty's Stationery Office.  
© Crown Copyright and database right 2022. All rights reserved.

Rev	Description	Drawn	Approved	Date

**TEP THE ENVIRONMENT PARTNERSHIP**

Genesis Centre, Birchwood Science Park, Warrington WA3 7BH  
Tel 01925 844004 e-mail tep@tep.uk.com www.tep.uk.com

Project  
**Land West of Wingates Industrial Estate, Westhoughton**

Title  
**Landscape Masterplan for Landscape Buffer and Ecological Mitigation Zones**




Drawing Number  
**D9645.001** DRAFT 304/10/22

Scale <b>1:2,000 @ A1</b>	Date <b>22/09/2022</b>
Drawn <b>CH</b>	Checked <b>RJC</b>
	Approved <b>RJC</b>


Notes

1. This drawing has been prepared in accordance with the scope of RPS's appointment with its client and is subject to the terms and conditions of that appointment. RPS accepts no liability for any use of this document other than by its client and only for the purposes for which it was prepared and provided.
2. If received electronically it is the recipient's responsibility to print to correct scale. Only written dimensions should be used.
3. This drawing should be read in conjunction with all other relevant drawings and specifications.

KEY

-  Site Boundary (33.14 Ha / 81.90 acres)
-  Plot Boundary (Indicative outline only)
-  Possible retaining structure/slope (Indicative only, subject to detailed design by specialist consultant)

Finished Floor Level heights based on BE Design drawing NWK180009-BED-EX-00-DR-C-0210\_P01

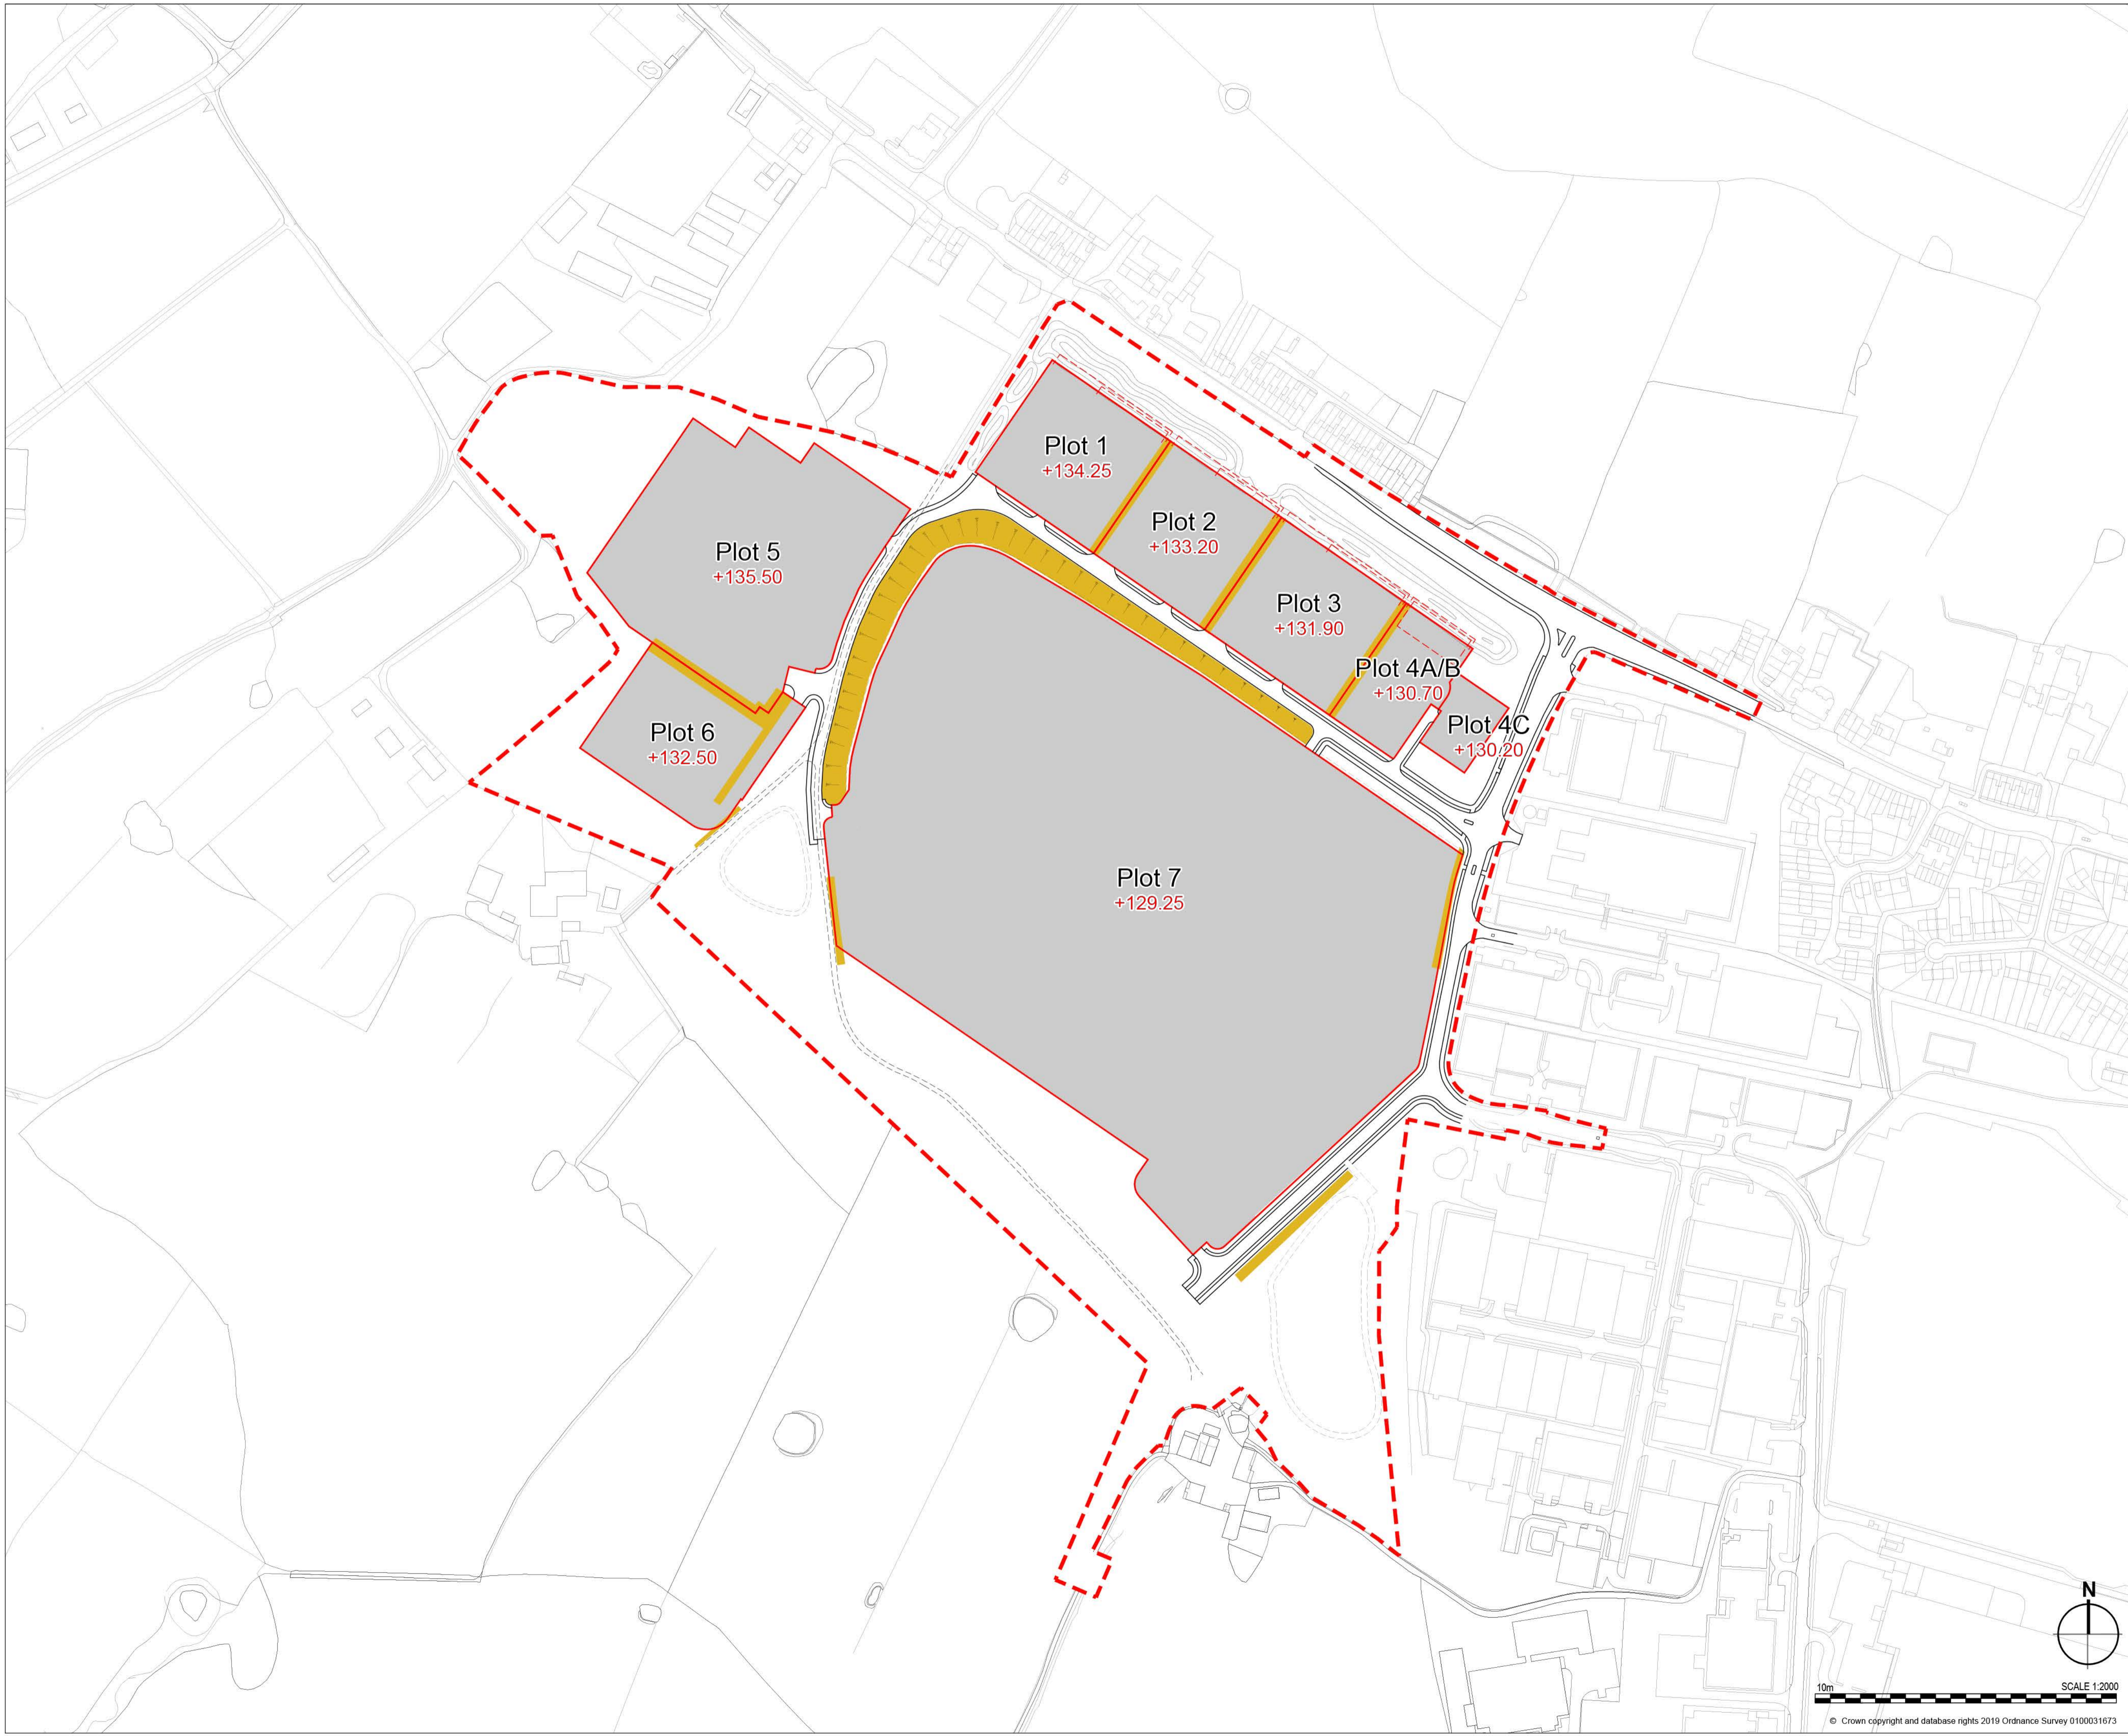

C	Plot 1 reduced, Plots 4a & 4b merged	AE	DEC	04.12.19
B	Redline Amended	AE	MJH	11.10.18
A	Plots 4a, 4b, 5 & 6 levels amended in line with latest cut & fill analysis	AE	MJH	10.09.18
Rev	Description	By	Ckd	Date



Sherwood House, Sherwood Avenue,  
Newark, Nottinghamshire, NG24 1QQ  
T: 01636 605 700 E: rpsnewark@rpsgroup.com

Client  
**Harworth**

Project Wingates, Bolton


Title Plot Levels Plan

Status	Scale	Date Created
Preliminary	1:2000 @A1	09.08.18
Task Team Manager	Information Author	Task Information Manager
MJH	AE	MJH


Document Number  
SK089

Project Code - Originator - Zone - Level - Type - Role - Drawing Number	Suitability	Revision
RPS Project Number NK018161	S0	C

rpsgroup.com

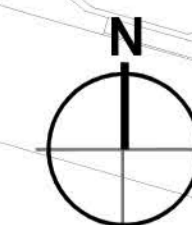

10m SCALE 1:2000

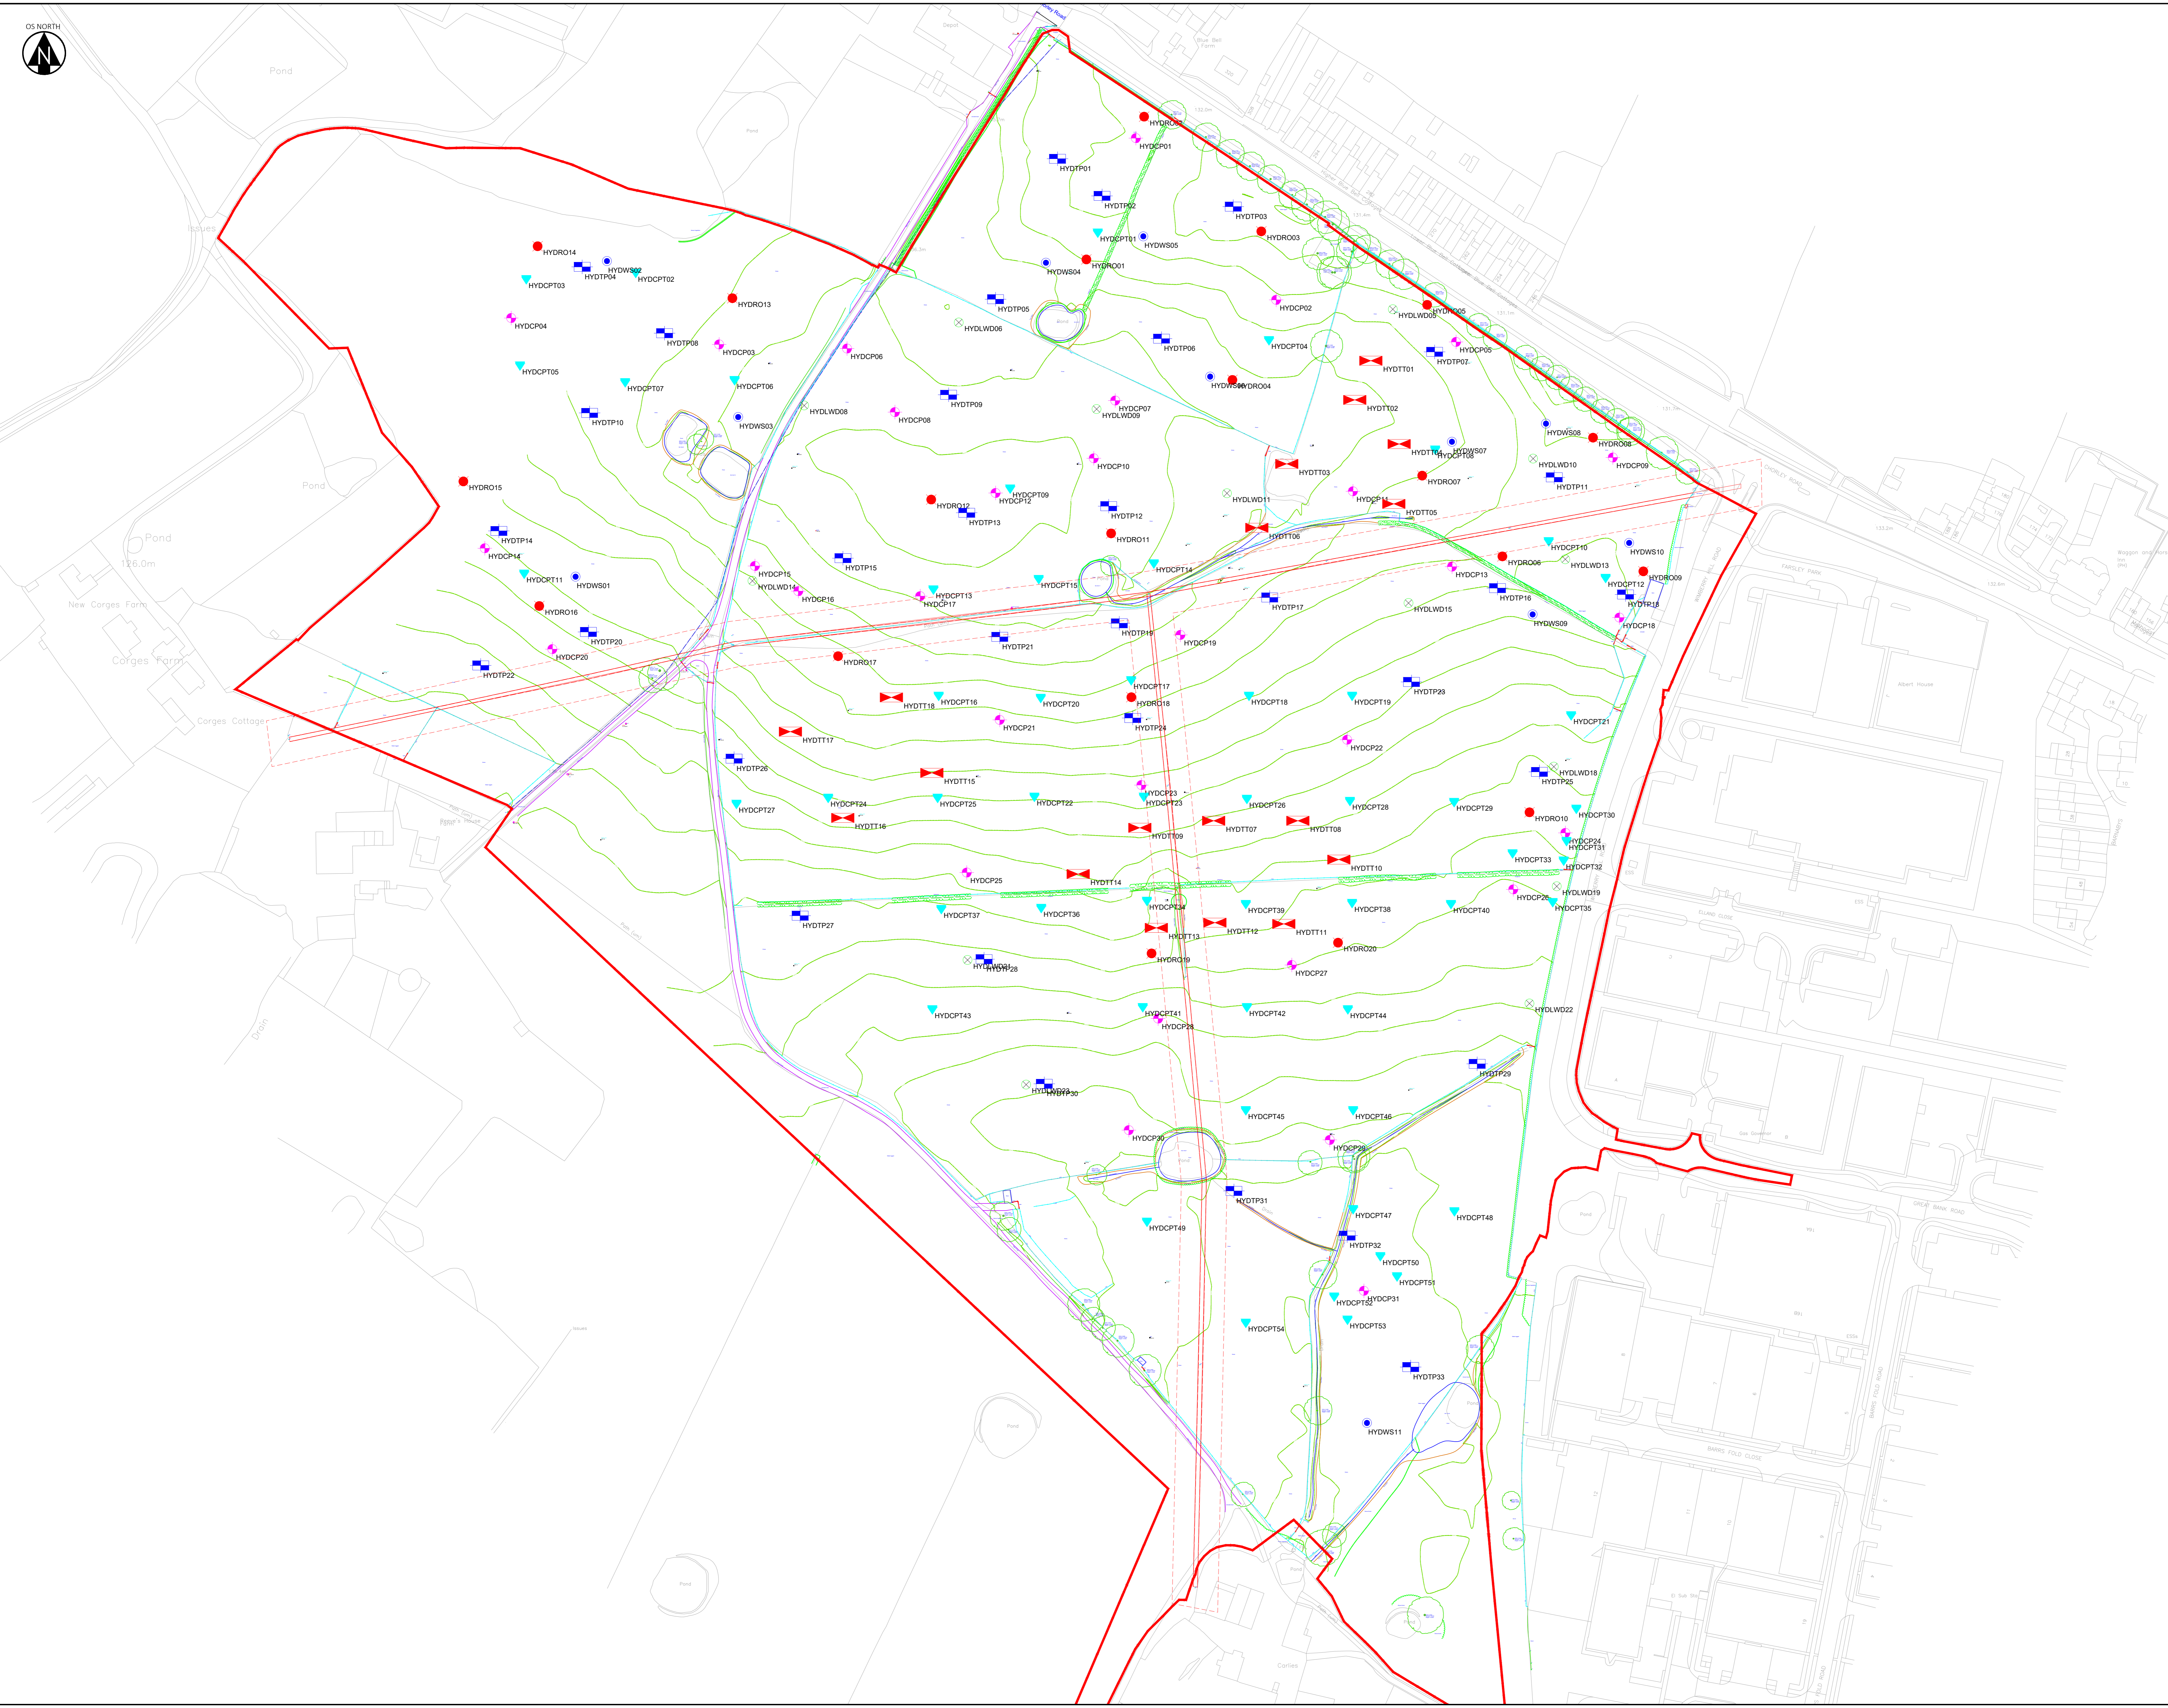

**KEY**

- ROTARY BOREHOLE
- TRIAL PIT
- CBR
- BOREHOLE
- WINDOW SAMPLE
- TRIAL TRENCH
- CABLE PERCUSSIVE BOREHOLE
- DYNAMIC CONE PENETROMETER TESTING
- STAND-OFF ZONE FROM OVERHEAD CABLES

**NOTES**

1. All dimensions are to be checked on site before the commencement of works. Any discrepancies are to be reported to the Architect & Engineer for verification. Figured dimensions only are to be taken from this drawing.
2. This drawing is to be read in conjunction with all relevant Engineers' and Service Engineers' drawings and specifications.
3. This drawing has been based on the following drawings and information:  
RSK\_09/04/18 TOPOGRAPHICAL SURVEY, REF. 193556

UPDATED TO AS BUILT FOLLOWING GROUND INVESTIGATION					
P2	#	DATE	BY	DATE	DATE
PROPOSED EXPLORATORY HOLE LOCATIONS					
P1	#	DATE	BY	DATE	DATE
REVISION NOTIFICATIONS					
REV	DRAWN BY	DATE	CHECKED BY	DATE	APPROVED BY

4 Lakeside  
Fensale Way  
Stoke-on-Trent  
ST3 5JF  
t: +44(0) 1782 261919  
e: info@hydrock.com  
or visit www.hydrock.com

**Hydrock**

CLIENT  
**HARWORTH ESTATES**

PROJECT  
**WINGATES INDUSTRIAL ESTATE, BOLTON**

TITLE  
**EXPLORATORY HOLE PLAN**

HYDROCK PROJECT NO. <b>15592-GNMA</b>	SCALE @ A0 <b>1:1000</b>
PURPOSE OF ISSUE <b>SUITABLE FOR INFORMATION</b>	STATUS <b>S2</b>
DRAWING NO. / PROJECT CODE / ORIGINATOR / ZONE LEVEL / TYPE / ROLE / NUMBER <b>15592-HYD-XX-XX-DR-GE-001</b>	REVISION <b>PO2</b>



**KEY**

- ROTARY BOREHOLE
- ✦ BOREHOLE
- WINDOW SAMPLE

**NOTES**

1. All dimensions are to be checked on site before the commencement of works. Any discrepancies are to be reported to the Architect & Engineer for verification. Figured dimensions only are to be taken from this drawing.
2. This drawing is to be read in conjunction with all relevant Engineers' and Service Engineers' drawings and specifications.
3. This drawing has been based on the following drawings and information:  
RSK\_09/04/18 TOPOGRAPHICAL SURVEY, REF. 193556

REV	DATE	BY	CHKD BY	DATE	APPROVED BY	DATE
P1						

**Hydrock**  
 4 Lakeside  
 Festival Way  
 Stoke-on-Trent  
 ST3 3JF  
 t: +44(0) 1782 261919  
 e: info@hydrock.com  
 or visit www.hydrock.com

**CLIENT**  
 HARWORTH ESTATES

**PROJECT**  
 WINGATES INDUSTRIAL ESTATE, BOLTON

**TITLE**  
 MONITORING WELL LOCATION PLAN

HYDROCK PROJECT NO. 15592-GNMA	SCALE @ A0 1:1000
PURPOSE OF ISSUE SUITABLE FOR INFORMATION	STATUS S2
DRAWING NO. / PROJECT CODE / ORIGINATOR / DATE / TYPE / ROLE / NUMBER 15592-HYD-XX-XX-DR-GE-0002	REVISION P01