



Materials to match existing

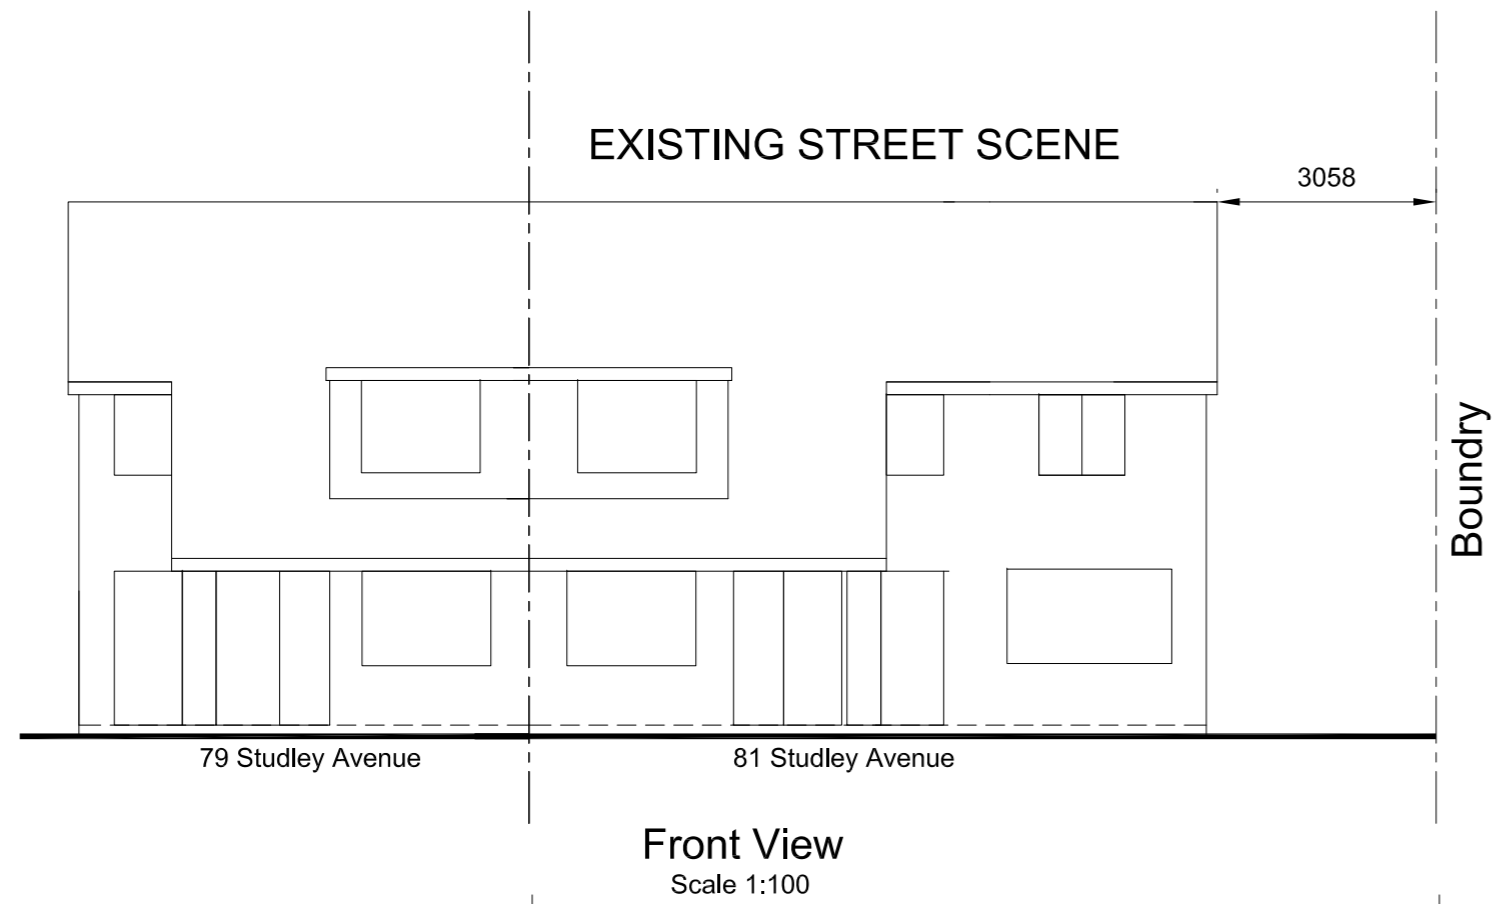

AS BUILT

14/10321 | First-floor side extension; use of garage as ancillary living accommodation; fenestration alterations | 81 STUDLEY AVENUE, HOLBURY, FAWLEY SO45 2PP


28 April 2014

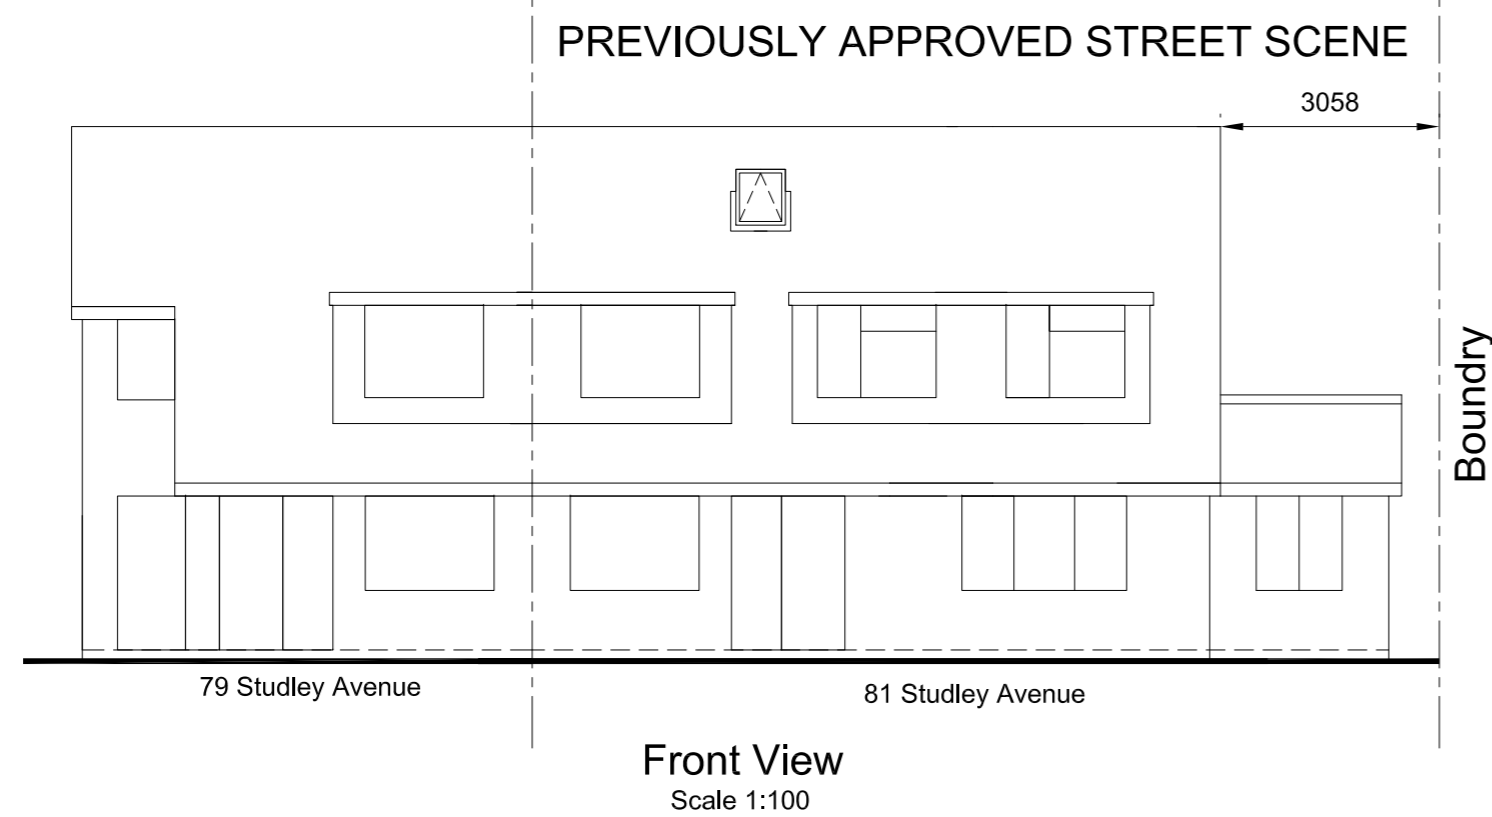


PREVIOUSLY APPROVED

15/11695 | Two-storey front extension; single-storey side extension; front dormer; rooflight | 81 STUDLEY AVENUE, HOLBURY, FAWLEY SO45 2PP

13 January 2016

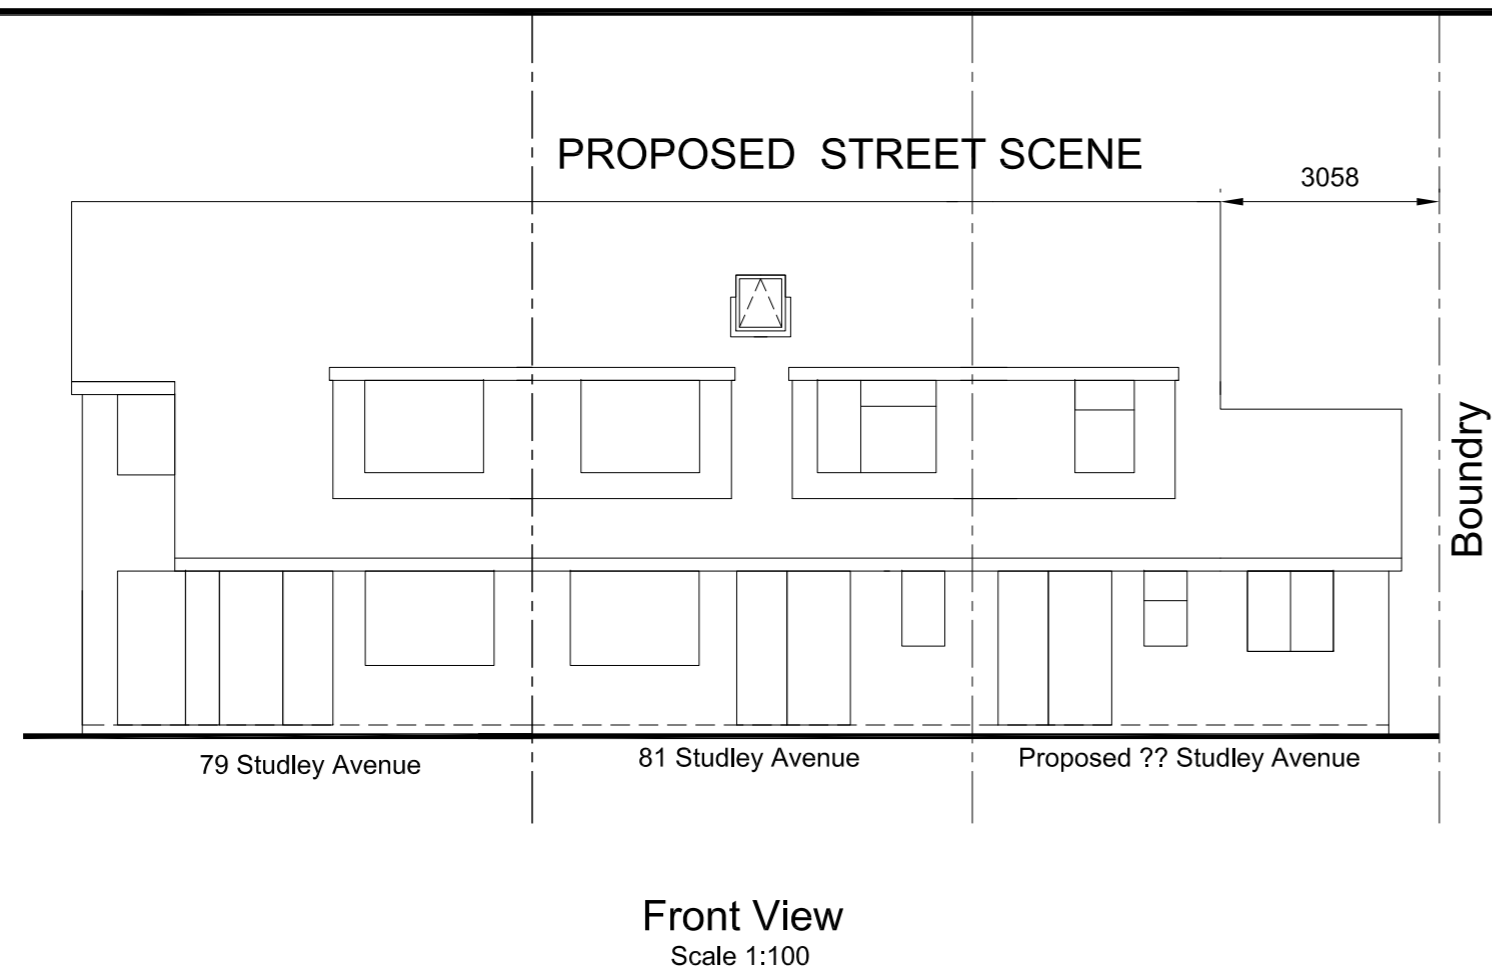

Notes
All dimensions and details to be checked on site by builder prior to commencement of works.
This plan must not be acted upon until it has been approved by the Local Authority.
Client to conform to party wall act of 1996 if required.

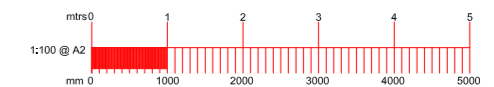

B		
A		
	Date	Revisions
Drawing Title: Street Scenes		

SITE ADDRESS 81 Studley Avenue Holbury Southampton SO45 2PP	CLIENT ADDRESS
---	----------------

Scale.	as noted	PAPER SIZE A2
Date.	March 2024	Drawn by. <i>R.N.S.</i>

Sanders Design Services Ltd
 95 Cedar Road
 Hythe
 Southampton
 SO45 3PX
www.sandersdesignservices.co.uk
info@sandersdesignservices.co.uk
 023 8020 7195

Drawing No	jon sht 4	Revision	x
------------	-----------	----------	---