



PRIOR TO WORKS

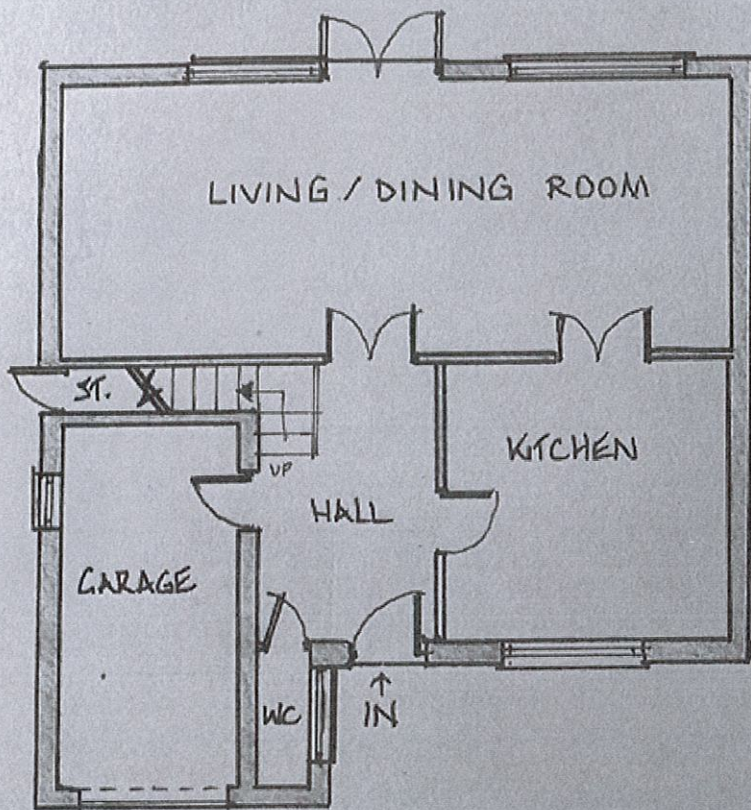


↑ PROPRIETARY GARAGE DOOR

SCALE - 0 1 2 3 4 5 m.

AS BUILT

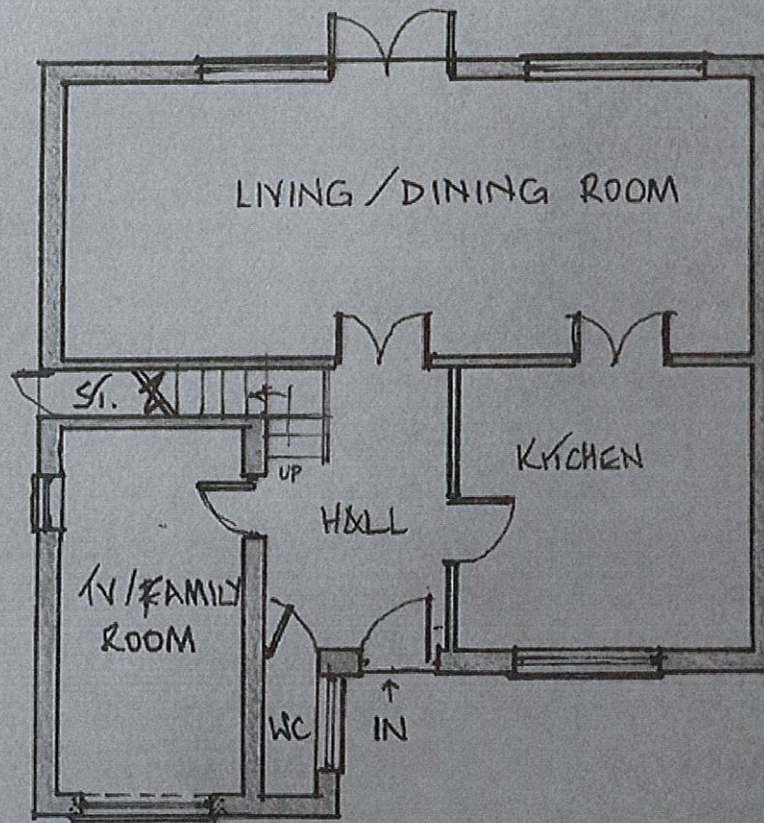

↑ BRICKWORK TOOTHED IN TO MATCH SURROUNDINGS
↑ NEW WINDOW PROVIDED IN PLACE OF GARAGE DOOR

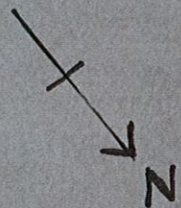

CERTIFICATE OF LAWFULNESS
APPLICATION DRAWING Nr. 1 of 2
1a WOODLANDS ROAD, BUSHEY
HERTFORDSHIRE WD23 2LS

SCALE 1:100 AT A4

AS BUILT, AND PRIOR TO WORKS
GROUND FLOOR PLANS