



PRIOR TO WORKS

SOFFIT BOARDS, FASCIAS AND  
ROOF OF GARAGE NOT  
IMPACTED BY WORKS

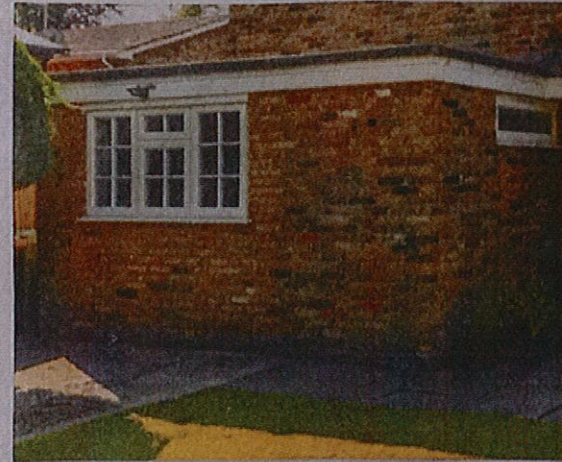

POST WORKS PHOTOGRAPH SHOWING  
WINDOW IN SITU. MULTI YELLOW  
STOCK BRICK TO MATCH REMAINDER  
OF FRONT FACADE

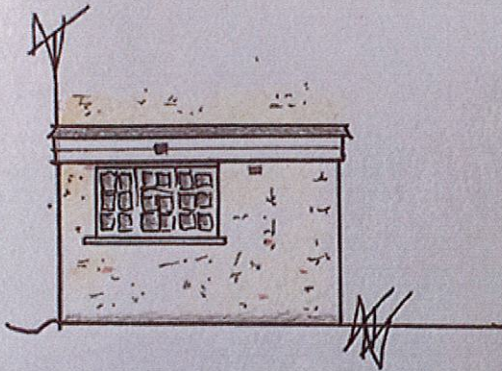

AS BUILT

REMAINDER OF  
FRONT FACADE NOT  
IMPACTED BY WORKS  
APRON BELOW WINDOW  
TOOTHED IN TO SURROUNDING BRICKWORK

SCALE ~ 0 1 2 3 4 5

CERTIFICATE OF LAWFULNESS  
APPLICATION DRAWING Nr. 2 of 2  
1a WOODLANDS ROAD, BUSHEY  
HERTFORDSHIRE WD23 2LS

SCALE 1:100 AT A4

AS BUILT, AND PRIOR TO WORKS  
GROUND FRONT ELEVATION (PART) DRAWINGS  
(REMAINDER OF FRONT ELEVATION NOT AMENDED)