

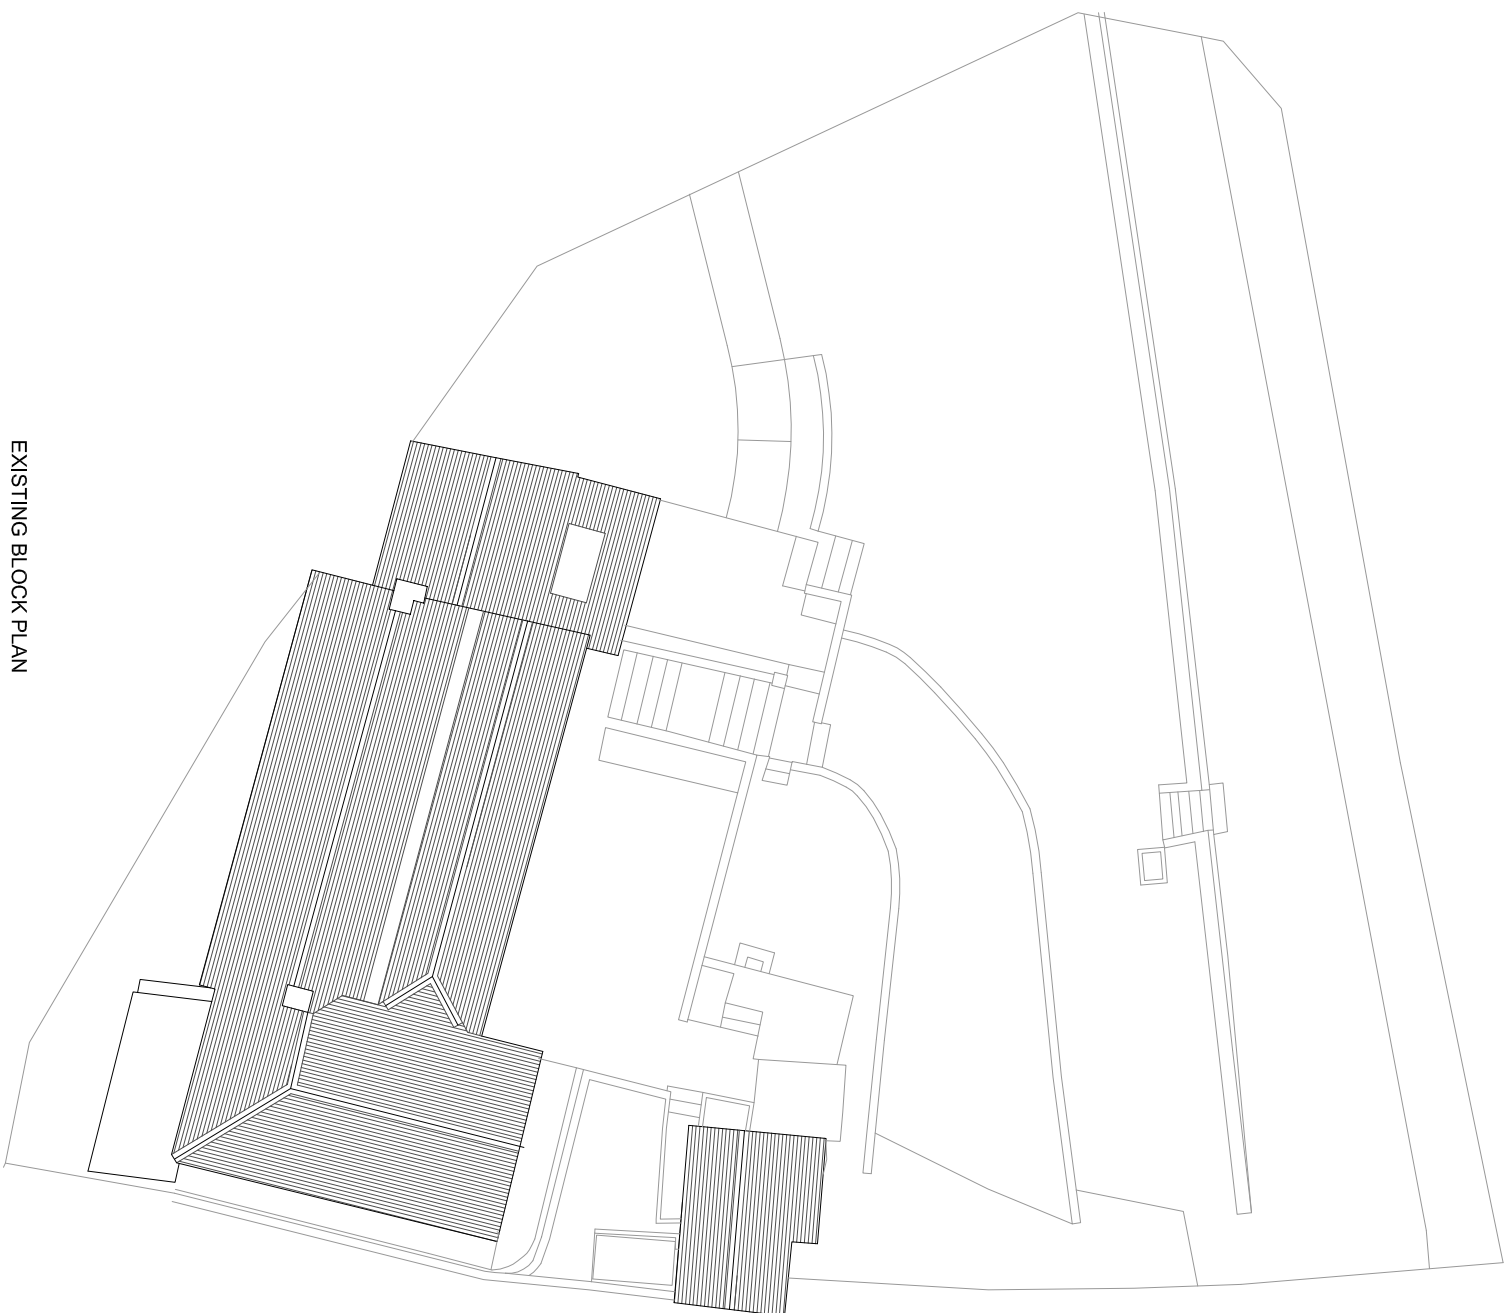


NOTES
These drawings are for planning purposes only and are not
issued for construction

Scale in Metres
0 2 4 6 8 10

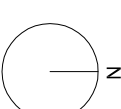

EXISTING BLOCK PLAN

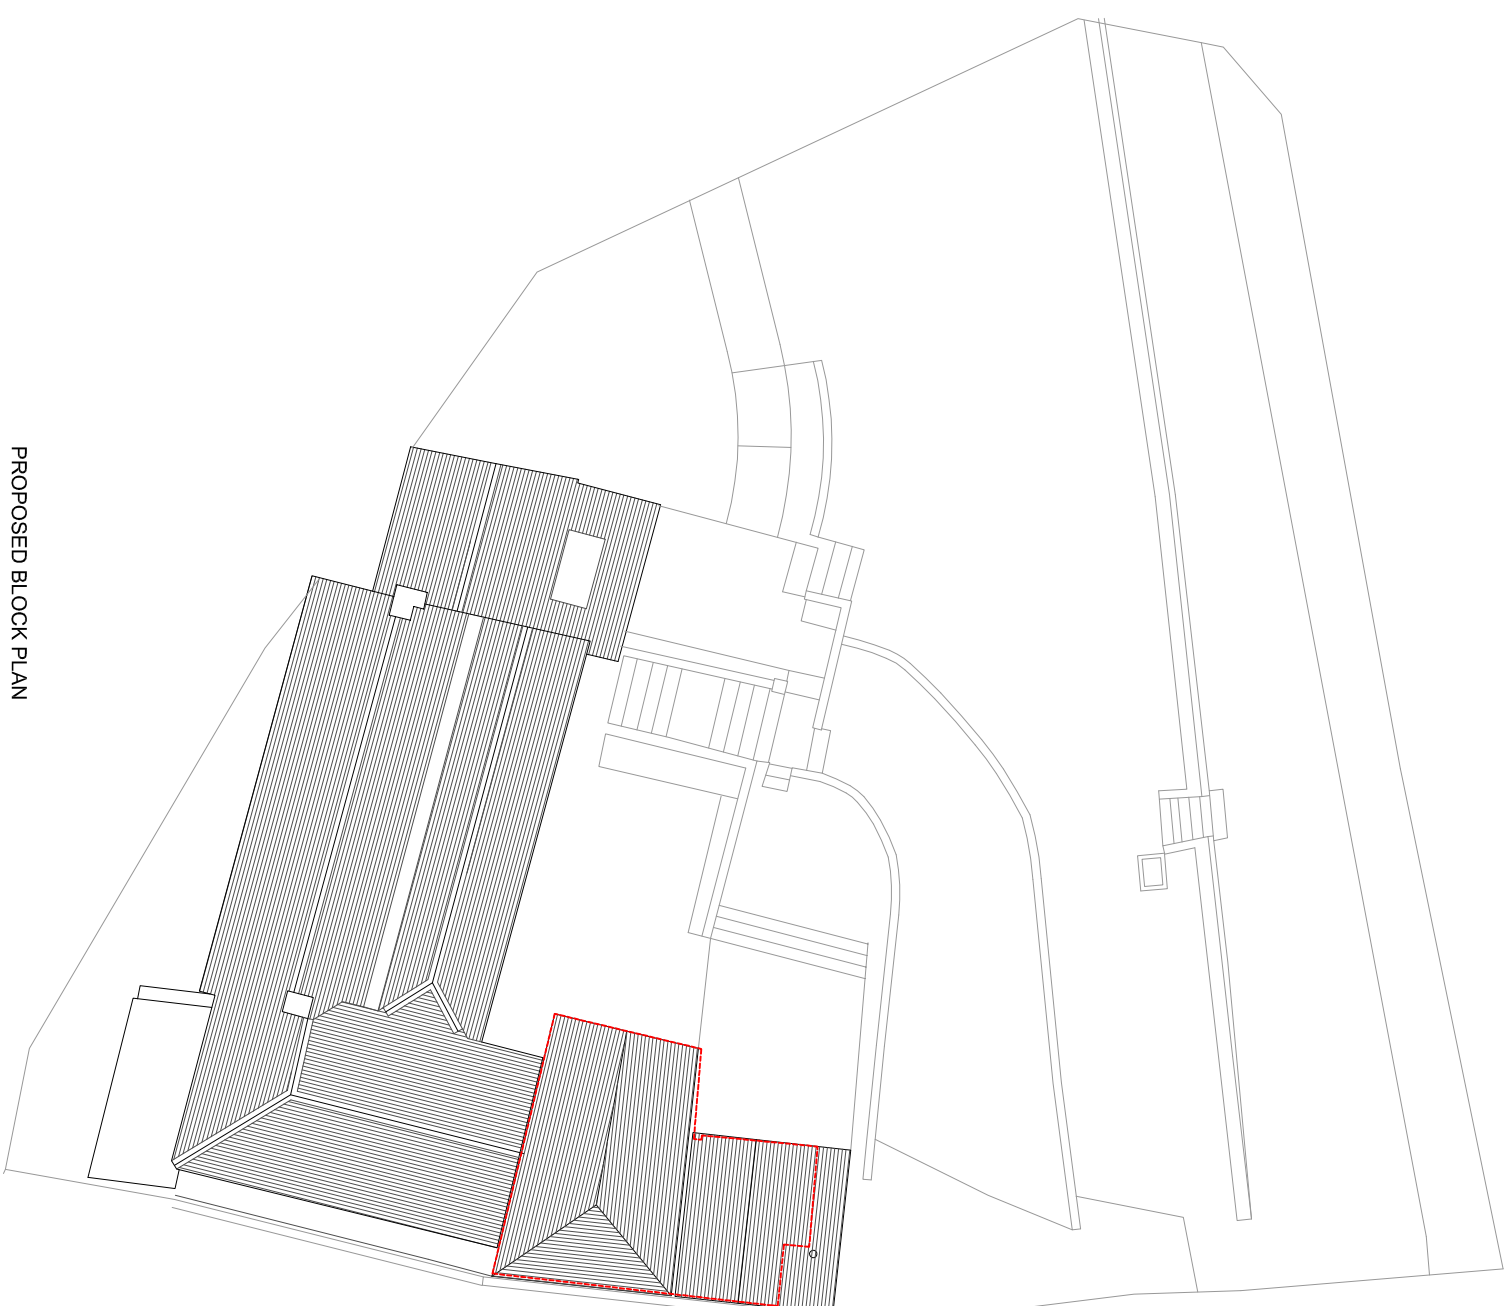

PROPOSED BLOCK PLAN

Dashed red line denotes outline of consented scheme
SDN/P/22/05507/HOUS
SDN/P/22/05508/LIS

MA+D
Maly Architecture and Design Ltd
t +44 (0)1273 311165
f +44 (0)1273 311165
w www.maly.co.uk
e info@maly.co.uk

project
Willow Cottage

drawing title
Existing and proposed block plans

drawing number
0207/PA/002

date
04.04.24

scale
1:100@A1/ 1:200@A3

purpose
ISSUED FOR PLANNING PURPOSES

revision
-

© Maly Architecture and Design Ltd