


Do not scale from this drawing.

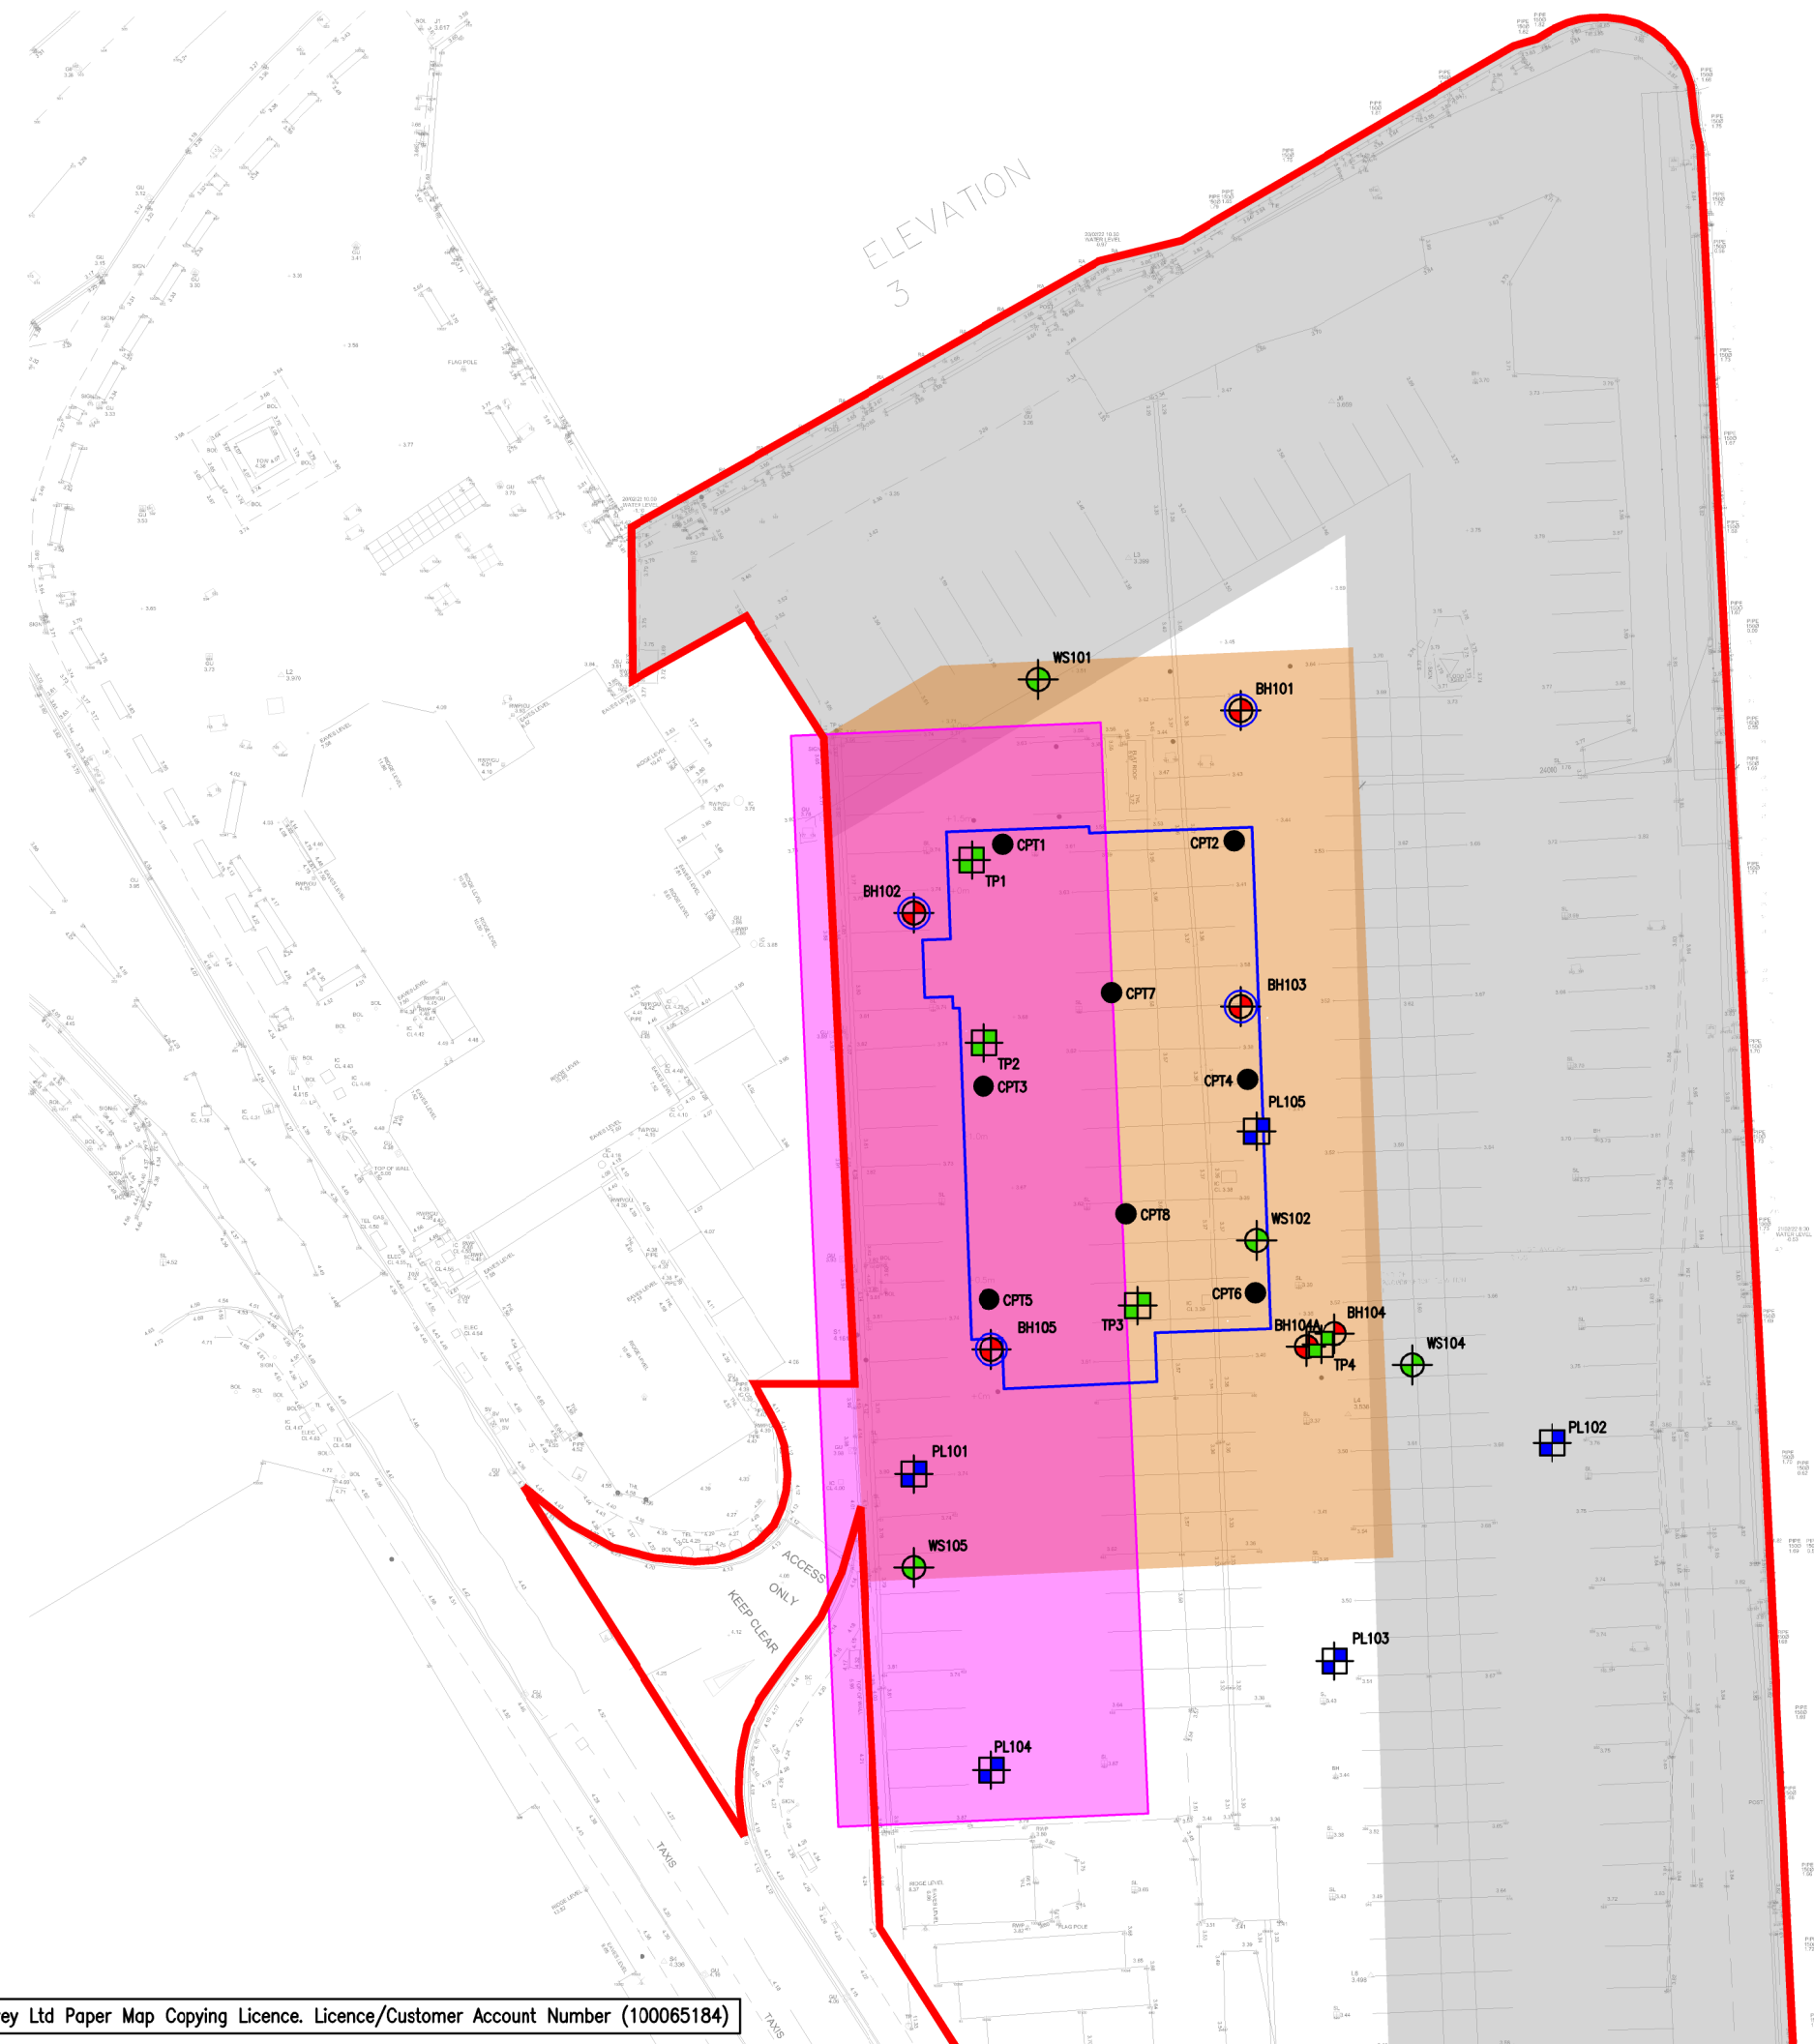

- Key: (As built)**
- Preliminary Site Boundary
  - Indicative Proposed Building Footprint
  - ⊕ Window Sample Borehole
  - ⊕ Cable Percussive Borehole
  - ⊕ Rotary Cored Follow On Drilling
  - ⊕ Plate Load Test
  - Indicative Tie Rod Exclusion Zone (24m)
  - Inferred Extents of Historic Building
  - Extent of New Tarmacadam Surface

- Key: (Proposed)**
- Cone Penetration Test
  - ⊕ Trial Pits
- TP1, TP2 & TP3 – Excavate 2mx2mx4m deep pits. Samples to be recovered at 0.7m, 2m & 4m bgl for chemical testing. Take additional samples if visual or olfactory evidence of contamination.
- TP4 – Excavate 3mx3mx4.5m deep pit in this area to locate obstruction. Samples to be recovered at 0.7m, 2m & 4m bgl for chemical testing.

P02	15/03/24	TRIAL PITS & CONE PENETRATION TESTS ADDED BUILDING FOUNDATIONS ADDED	SB	DD	DD
P01	11/12/23	UPDATED TO REFLECT BIM NAMING CONVENTION	CMC	DD	DD
D	11/12/23	AS BUILT ISSUE	DAU	CMC	DD
C	11/10/23	REVISED TO SHOW PROPOSED EXPLORATORY HOLE COORDINATES AND LARGER EXCLUSION ZONE	RD	CMC	JMM
B	27/03/23	REVISED TO SHOW AS BUILT EXPLORATORY HOLE LOCATIONS AND PHASE 2 PROPOSED LOCATION	RD	DD	DD
A	09/03/23	REVISED TO INCLUDE SITE BOUNDARY AND REVISED EXPLORATORY POSITIONS	RD	CMC	DD

Rev.	Date	Description	Drwn.	Chkd.	Appd.
------	------	-------------	-------	-------	-------

**FAIRHURST**

1 Arngrove Court  
Barrack Road,  
Newcastle-upon-Tyne  
NE4 6DB

Tel: 0191 221 0505  
Fax: 0844 381 4412

Client:



**WILLMOTT DIXON**

Project Title:  
**WHITBY MARITIME HUB**

Drawing Title:  
**EXPLORATORY HOLE LOCATION PLAN**

Scale at A3: 1:500	Status: For Information
Drawn: RD	Checked: CMC
Date: 30/01/23	Approved: DD
Date: 01/02/23	Date: 01/02/23

Drawing No.: **WHIT-FHT-Z1-00-DR-G-09001** P02

