


This is a scaled drawing for planning purposes. Contractor to check all dimensions on site prior to the commencement of the works.

Errors and omissions included. This drawing is for planning purposes only. Although these are scaled drawings, because of reprographic errors, scaling from them is discouraged.


The Red line around this site does not indicate the Legal, Physical or Land Registry Boundaries. It merely identifies the Application Site in its surrounding context.

Errors and Omissions Excepted


This drawing must be read in association with the full Building Regulation Specification

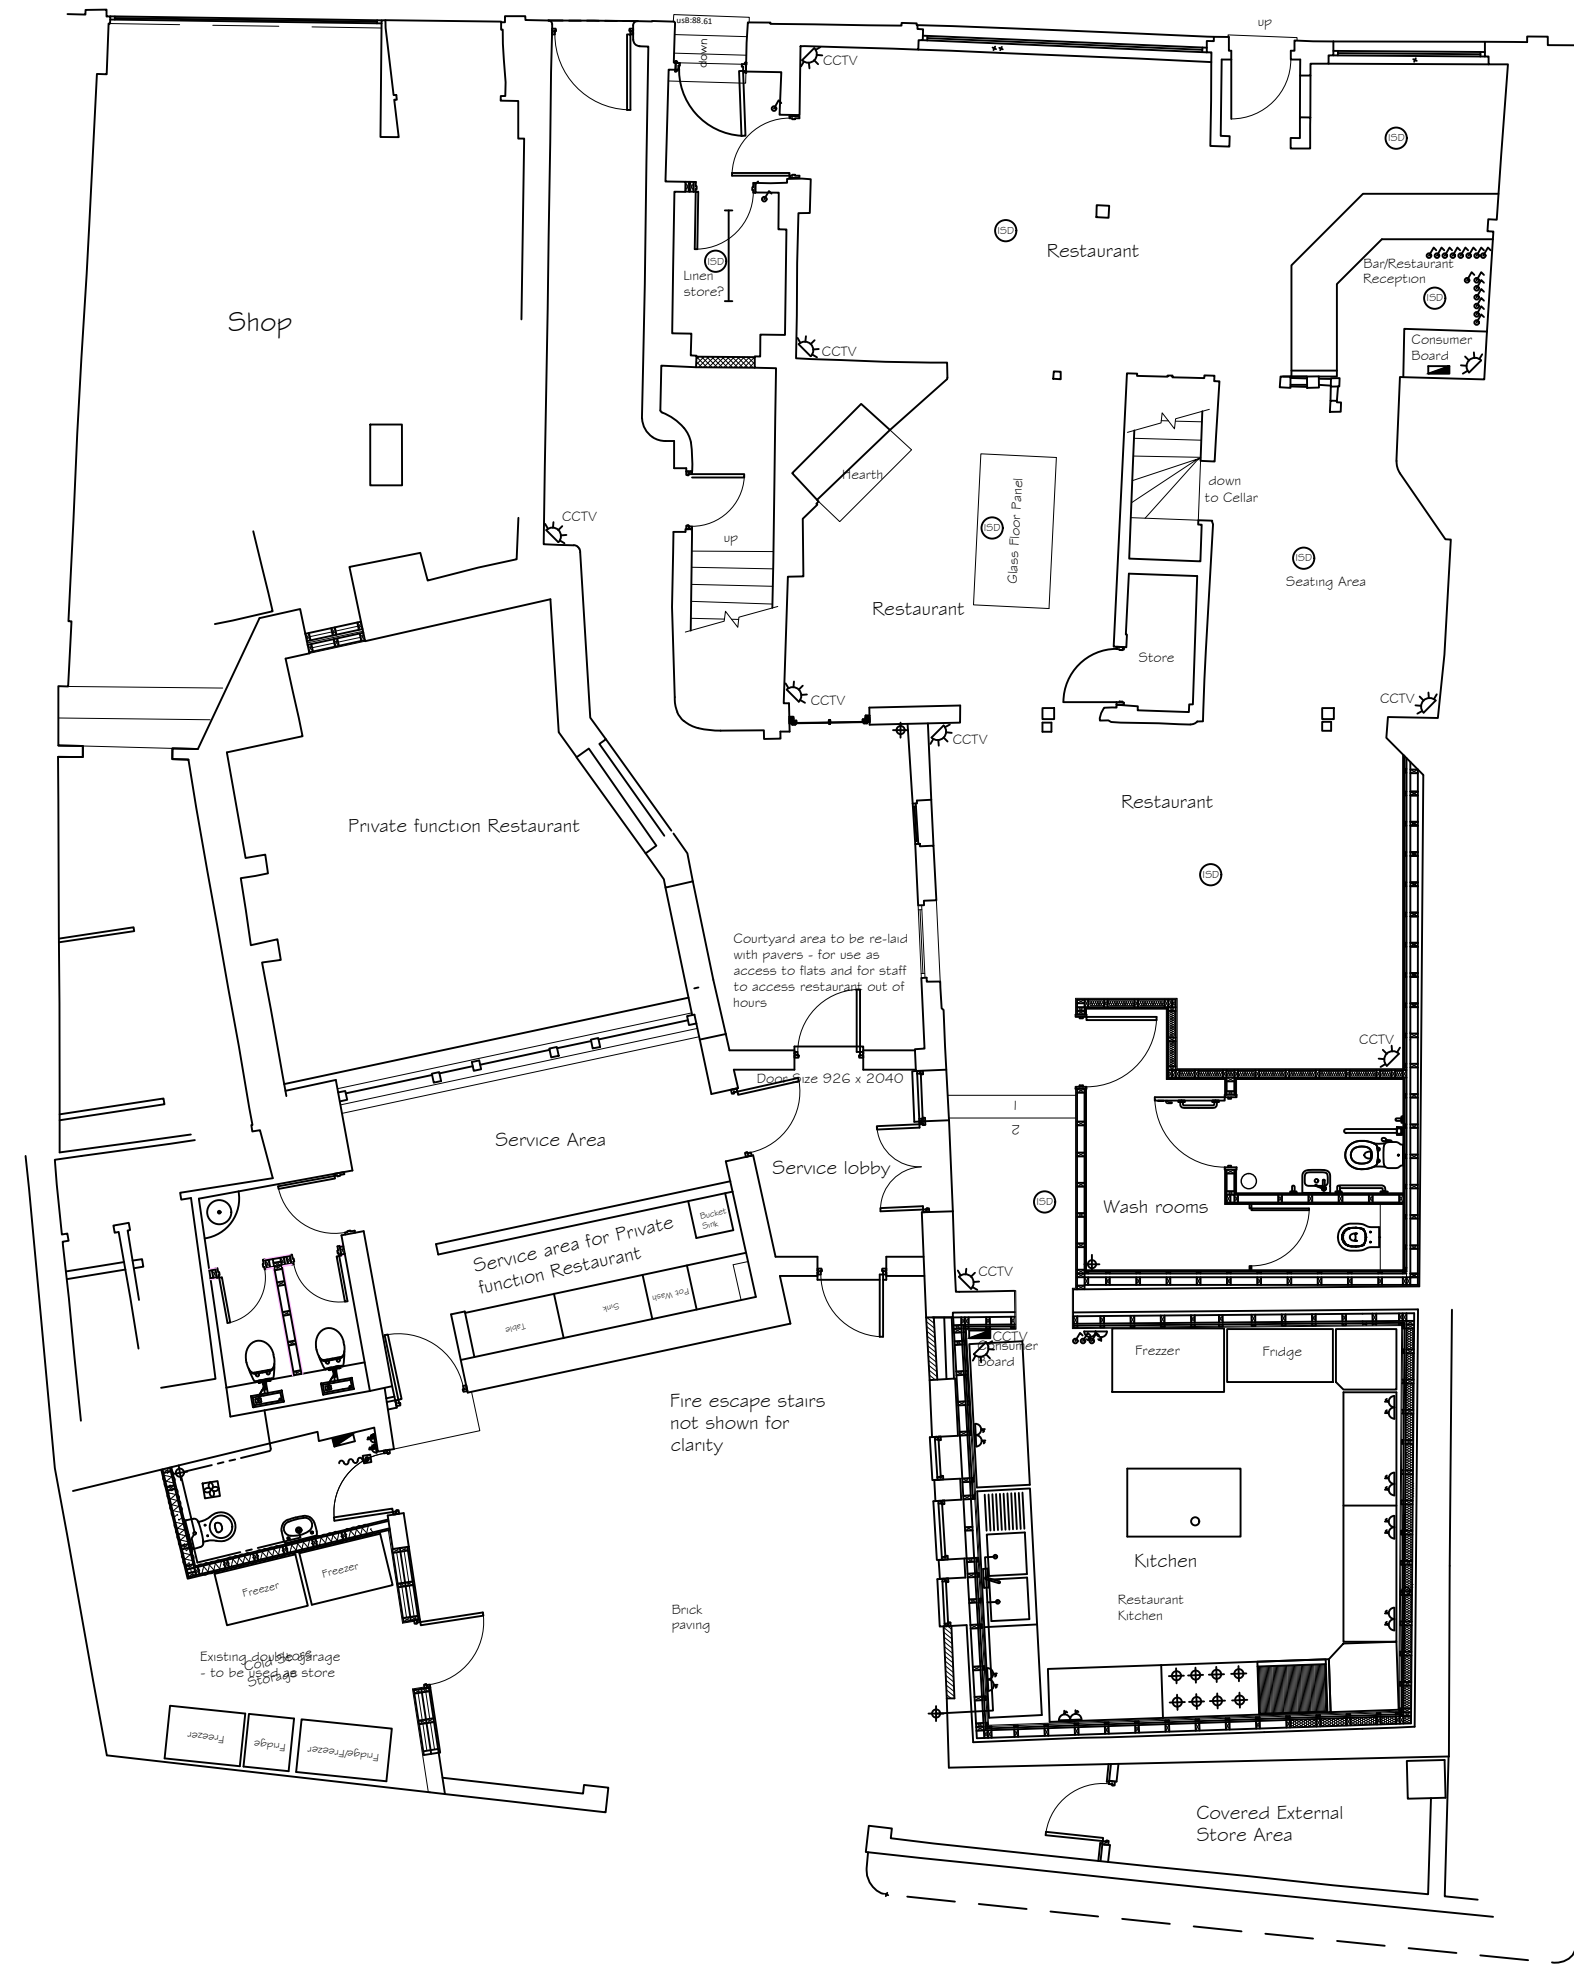

Ground Floor Layout

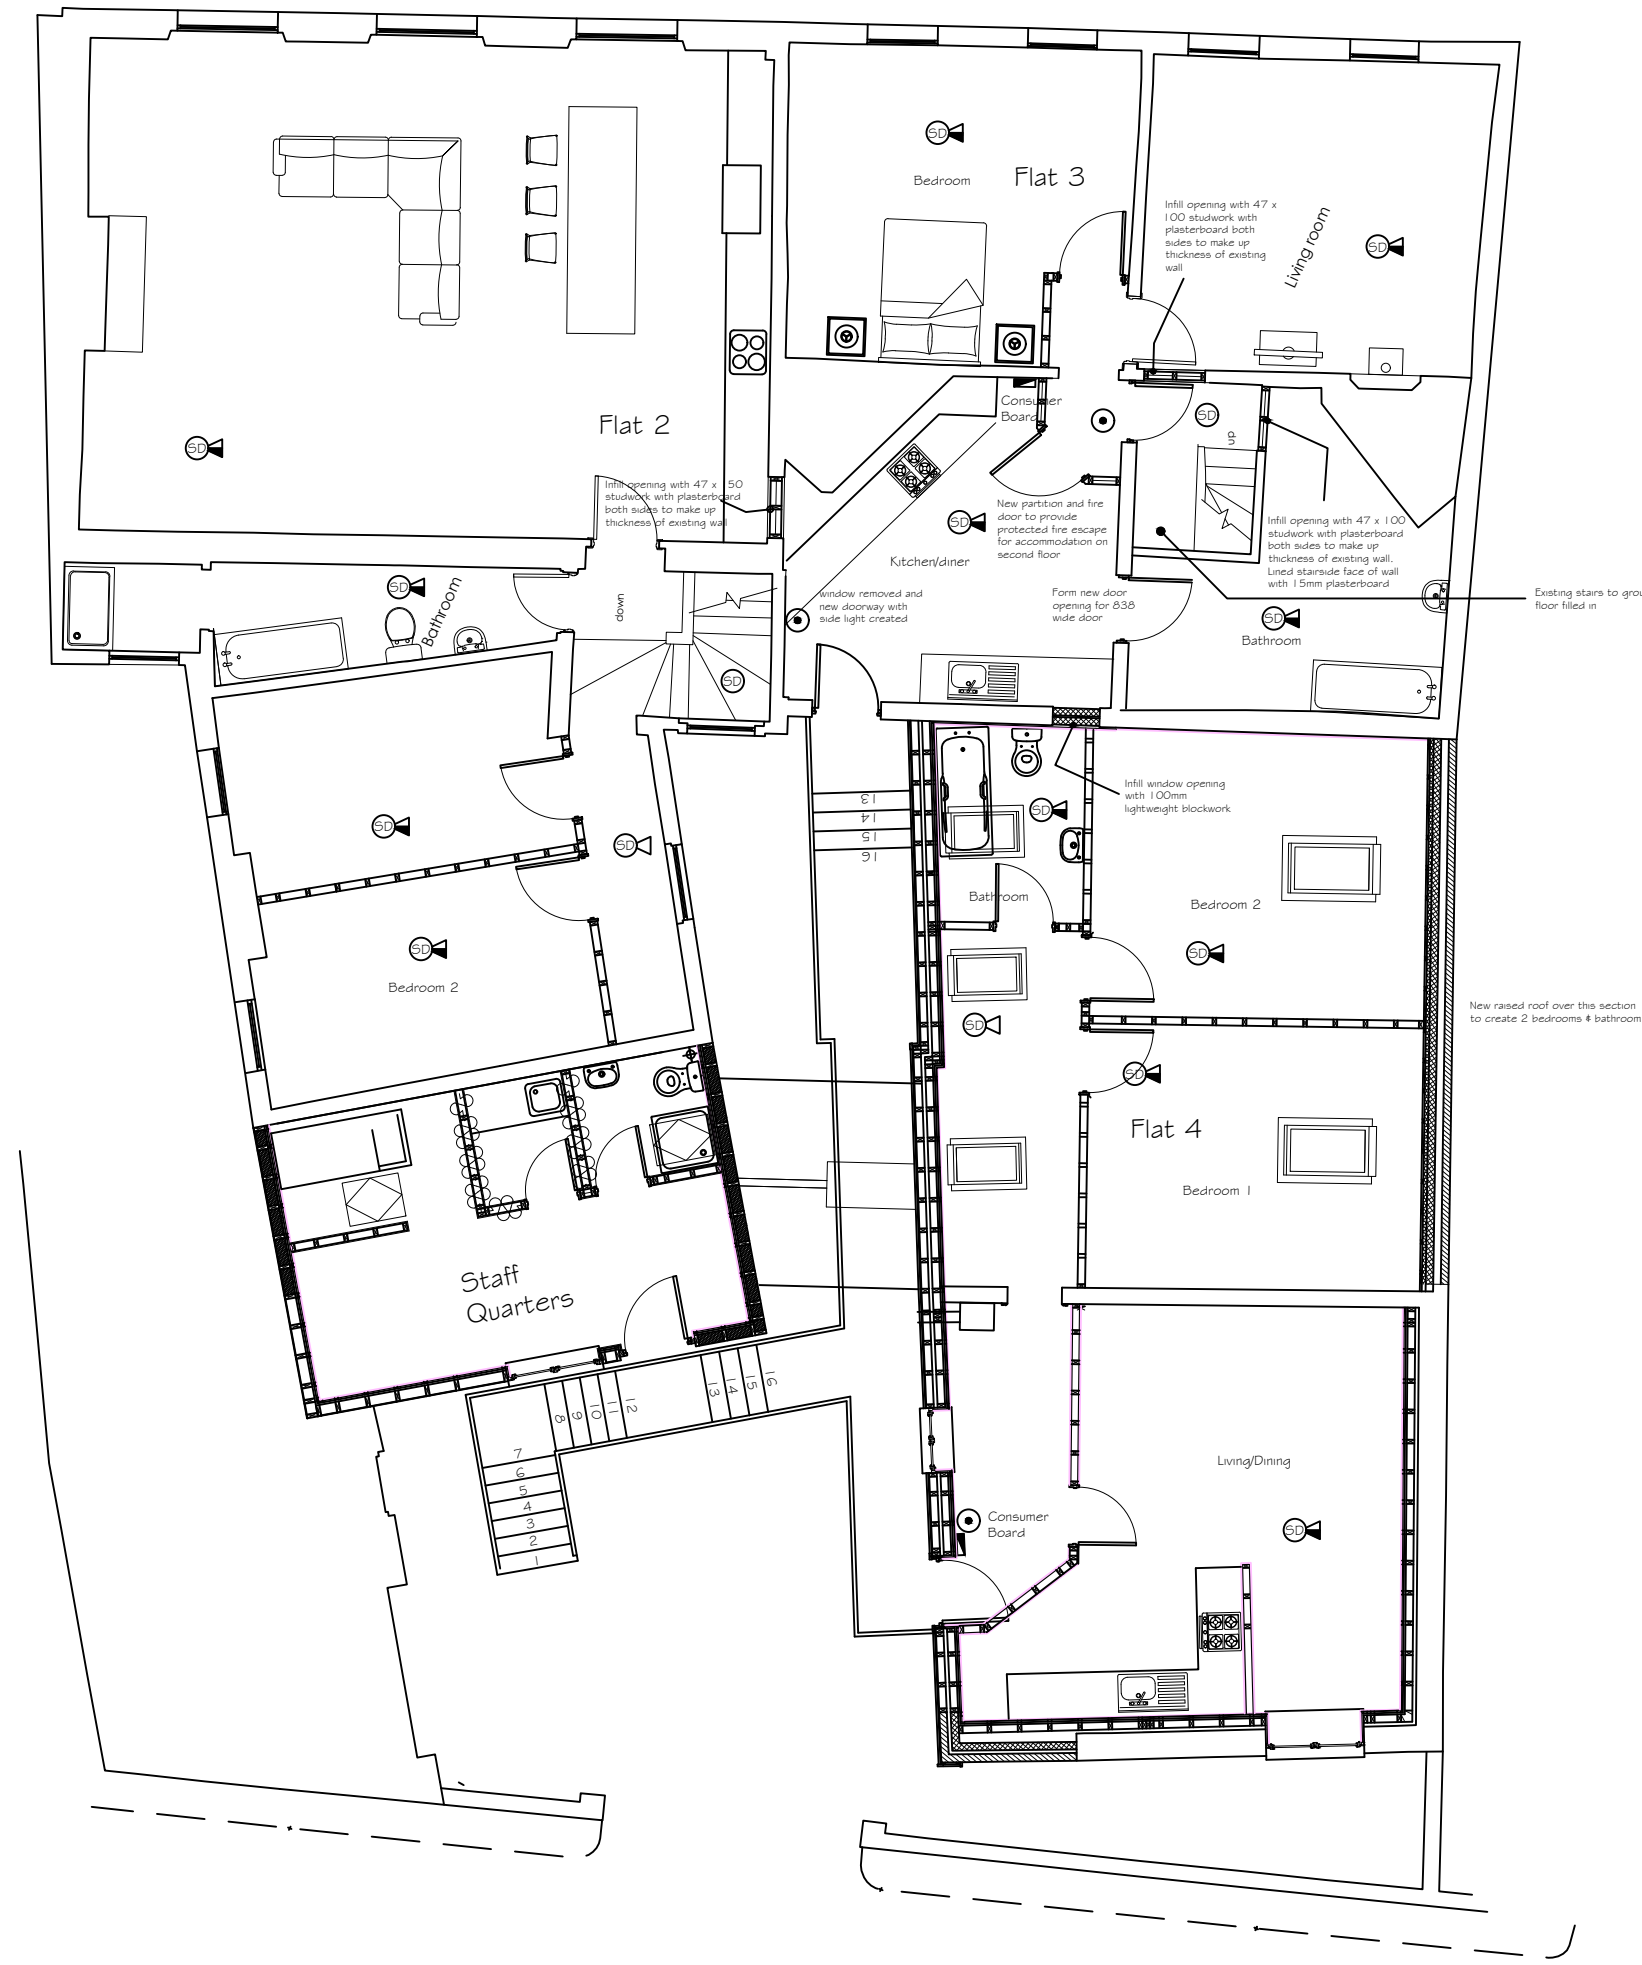


First Floor Layout

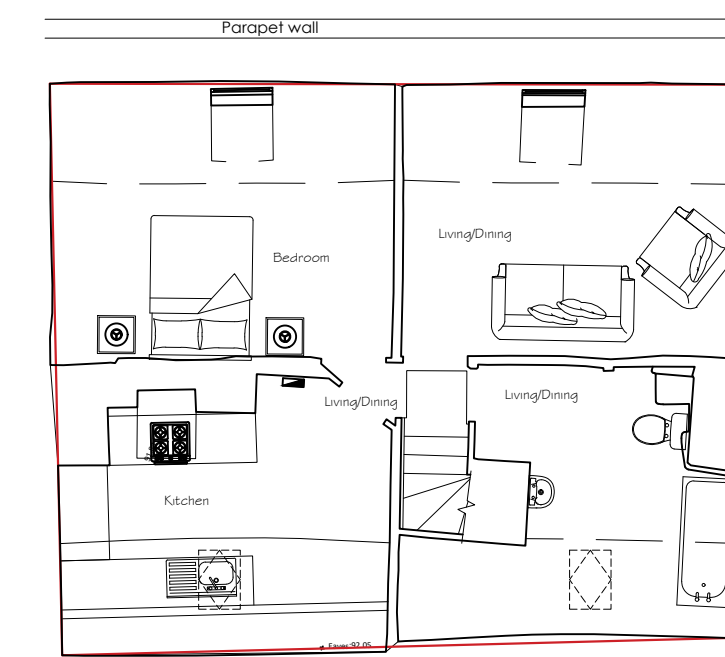

Second Floor Layout

Floor Layouts as Done

A	Date	Revisions
<p>© Copyright: This drawing is copyright, it must not be copied in whole or in part, without the express permission of Inter County Surveys</p> <p>Inter County Surveys</p>  <p>4, Suffolk Road, Andover, Hampshire, SP10 2JD Telephone: (01264) 355760 Fax: (01264) 355760</p>		
Client: MR AHMET TOPCU		
Job Title: 21 - 23 Church Street Basingstoke RG21 7QQ		
Drawing Title: Floor Layouts as Done		
Scale: 1:100 @A1		
Date: June 23		Drawn By:
Drawing No: ICS/1968/58		Rev: