



This is a scaled drawing for planning purposes. Contractor to check all dimensions on site prior to the commencement of the works.

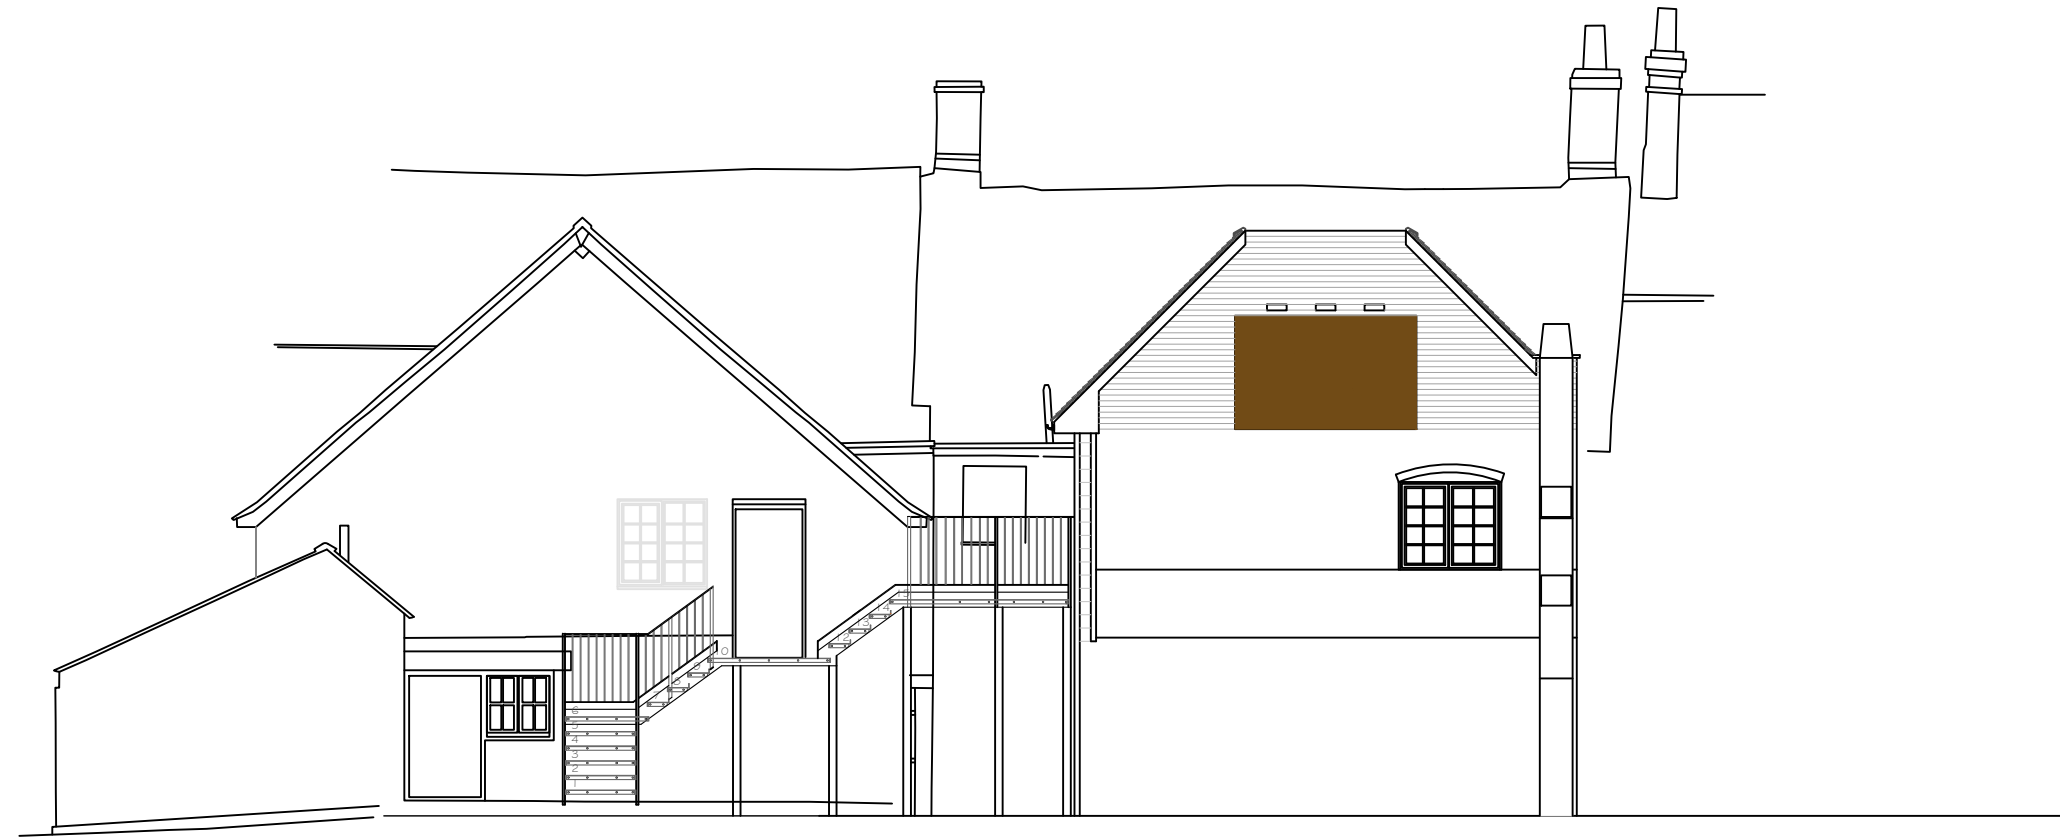


Side Elevation

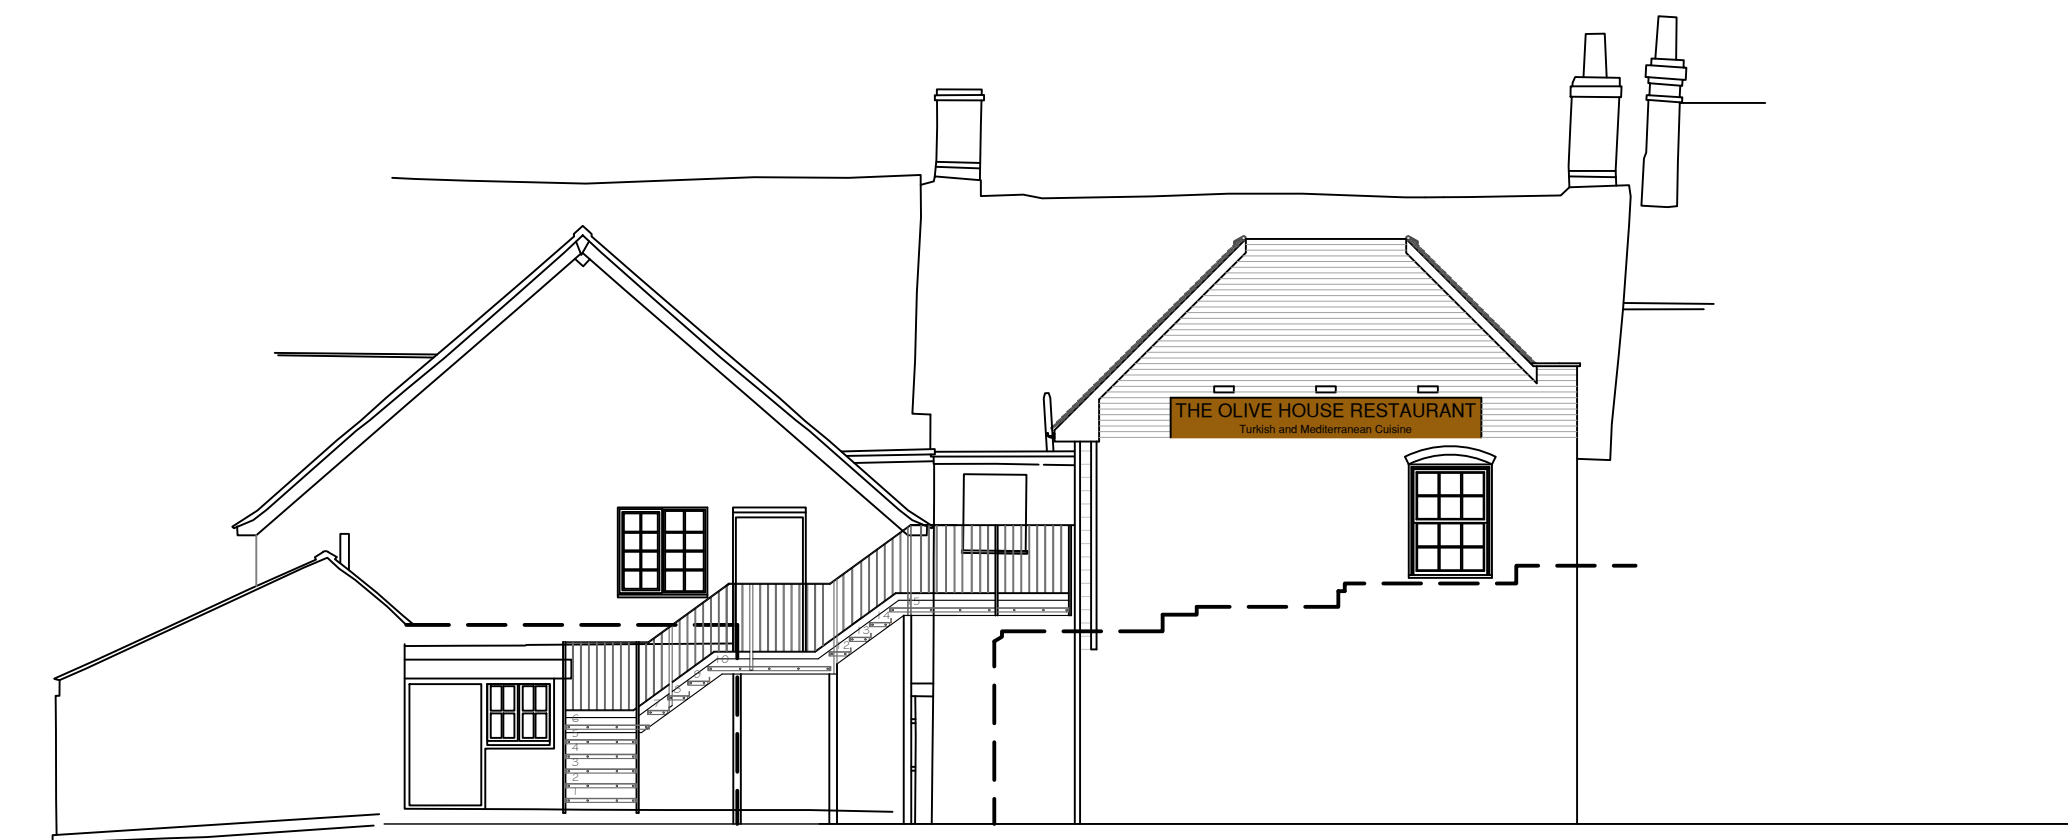

Rear Elevation



Front Elevation

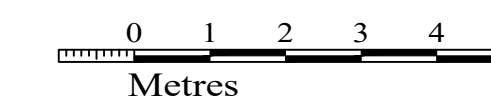

REV		DATE
CLIENT		
PROJECT 21 - 23 CHURCH STREET, BASINGSTOKE		
TITLE AS BUILT ELEVATIONS		
SCALE: 1:100 @ A1 DATE Oct 2023 DWG NO REV		
DRAWN CHD		ELEV-01