



EXISTING 1ST FLOOR

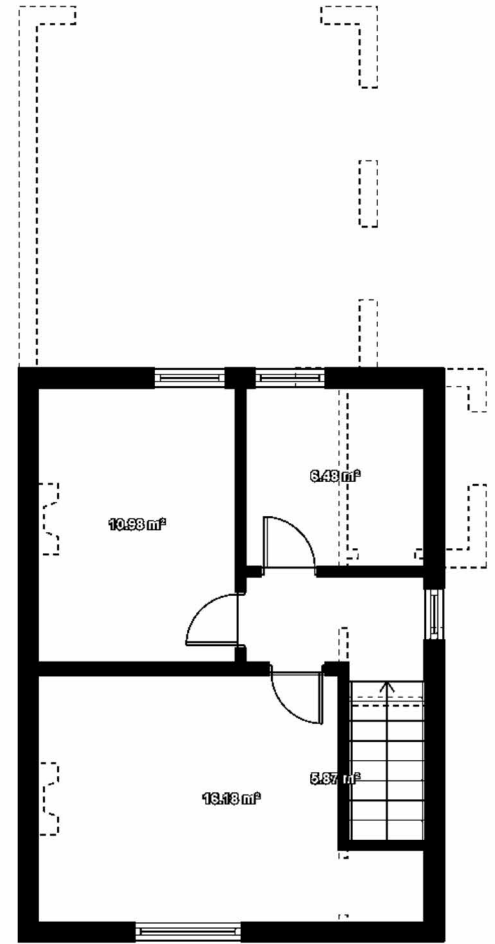


PROPOSED 1ST FLOOR
(NO CHANGE)

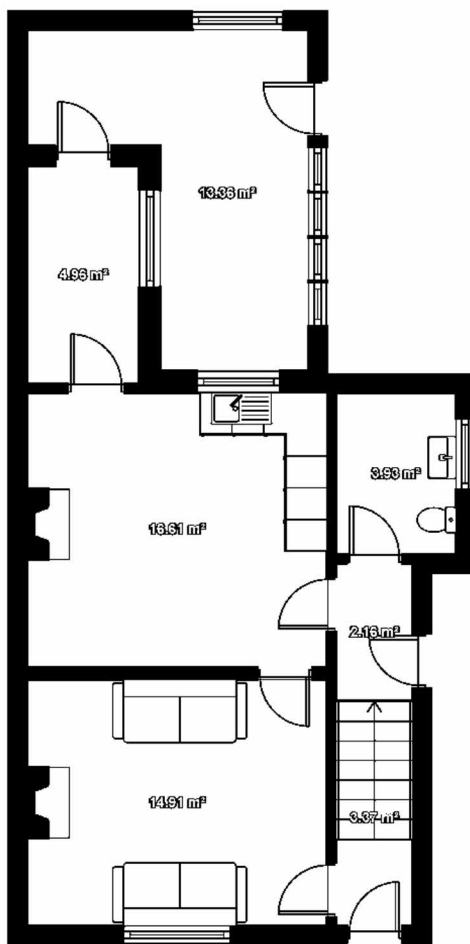


EXISTING GROUND FLOOR

RED LINES INDICATE
EXISTING UTILITY &
CONSERVATORY

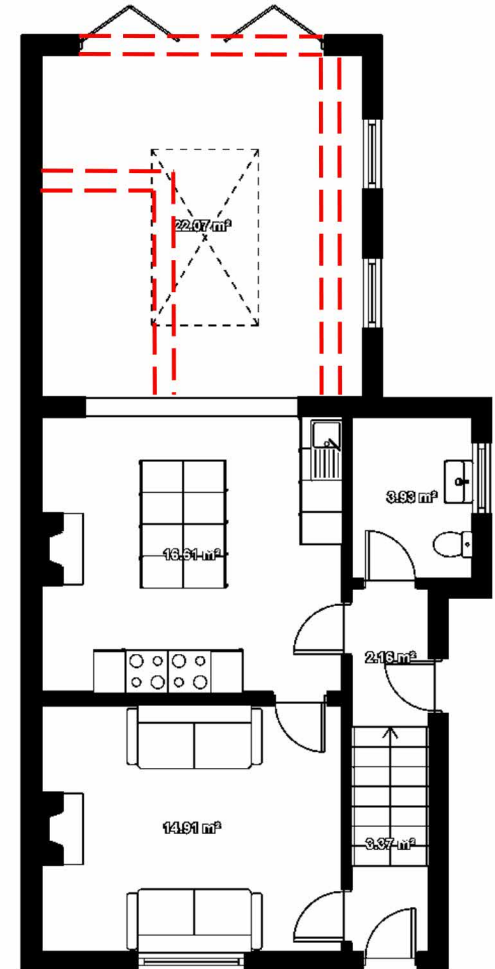

PROPOSED GROUND FLOOR

Toby Trett
62 Lynn Road
Southery
PE38 0HT

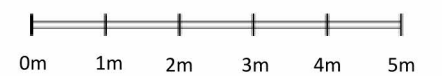

1:100 SCALE

FLOOR PLANS
62 LYNN ROAD
SOUTHERY
PE38 0HT