



add valley roof to no. 12  
ROOF PLAN

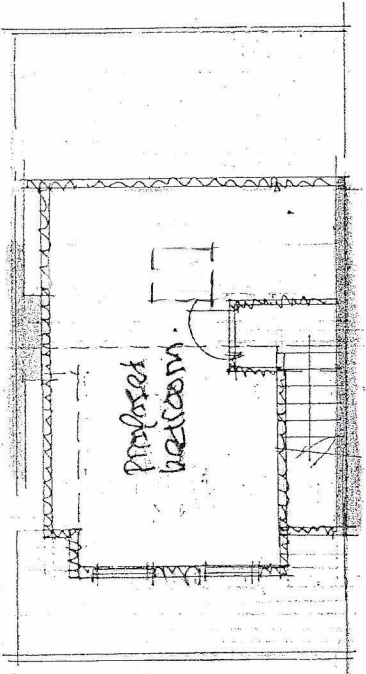

PLAN IN LOFT

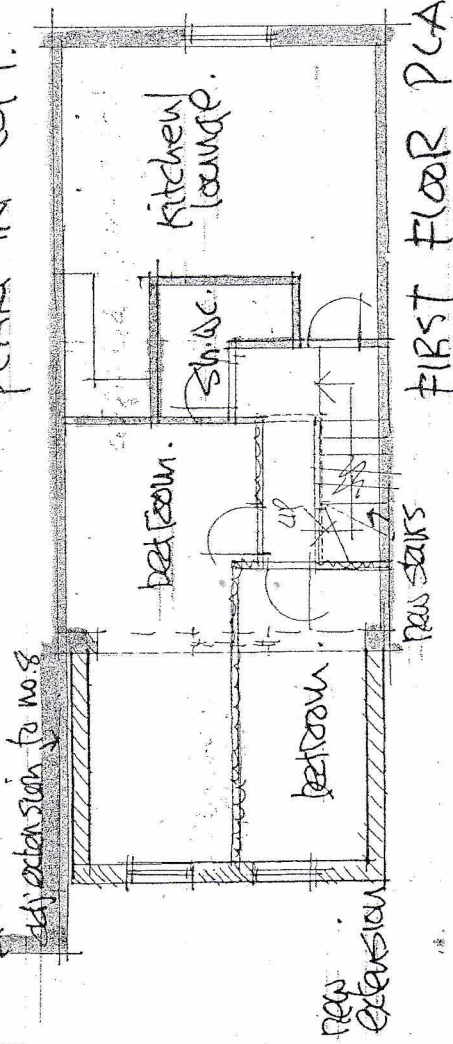

FIRST FLOOR PLAN

Rev. A. April 24 (not velux converted)

scale: 1:50 @ A4	job: 3377
date: July 21	drawn: 22A
client:	

DAVID BARNARD  
Town Planning Consultant + Building Designer  
4 Barber Close, London, N2 1TB  
Tel: 020 8245 1583

10 LIND ROAD SUTTON SM	Retention of existing 4 No. 1st Flats Plans
---------------------------	---

Existing Plans,  
No. 10

PRE-EXISTING AS BUILT.