


REAR ELEVATION

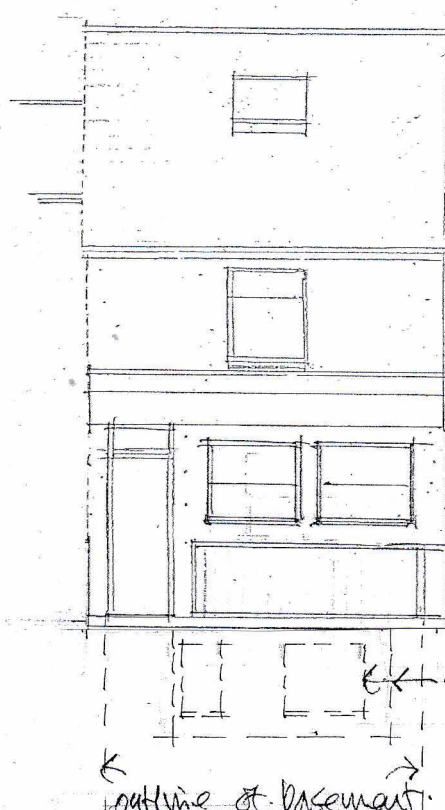

FRONT ELEVATION

new roof with xelux.

outline of wall well + basement windows.

outline of basement.



B. 9th 1st 2nd.
basement front corrected.
A. sept. 22. 22
rear elevation link added.

Existing elevations, no. 10

PRE-EXISTING
NO. 10
AS BUILT.

10	LINK ROAD
SUTTON	SMI
Retention of existing 4 no. 1st floor elevations.	

scale: 1:50 @ A4	job: 3377
date: July 21	dwg. no: 23 B
drawn:	
client:	
DAVID BARNARD Town Planning Consultant + Building Designer 4 Barber Close, London, N21 1BE Tel: 020 8245 1583	