




All Dimensions Shall be Checked on Site by the Contractor Prior to Commencement of Work on Site. Do Not Scale If in Doubt Ask.

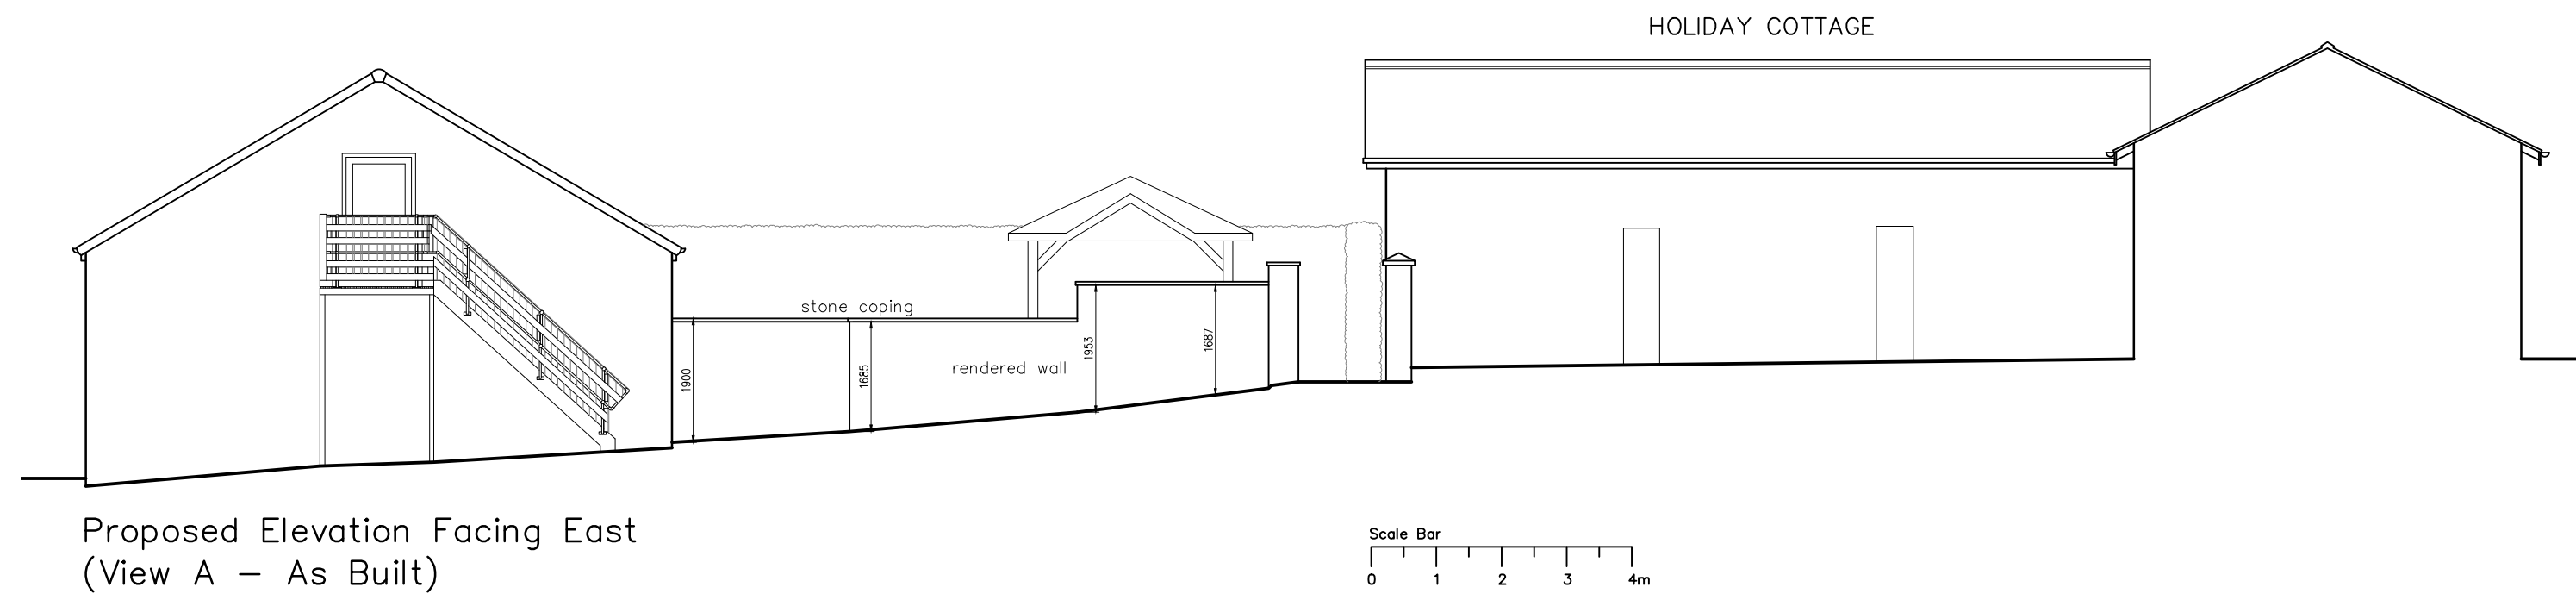


Proposed Elevation Facing East (View A - As Built)

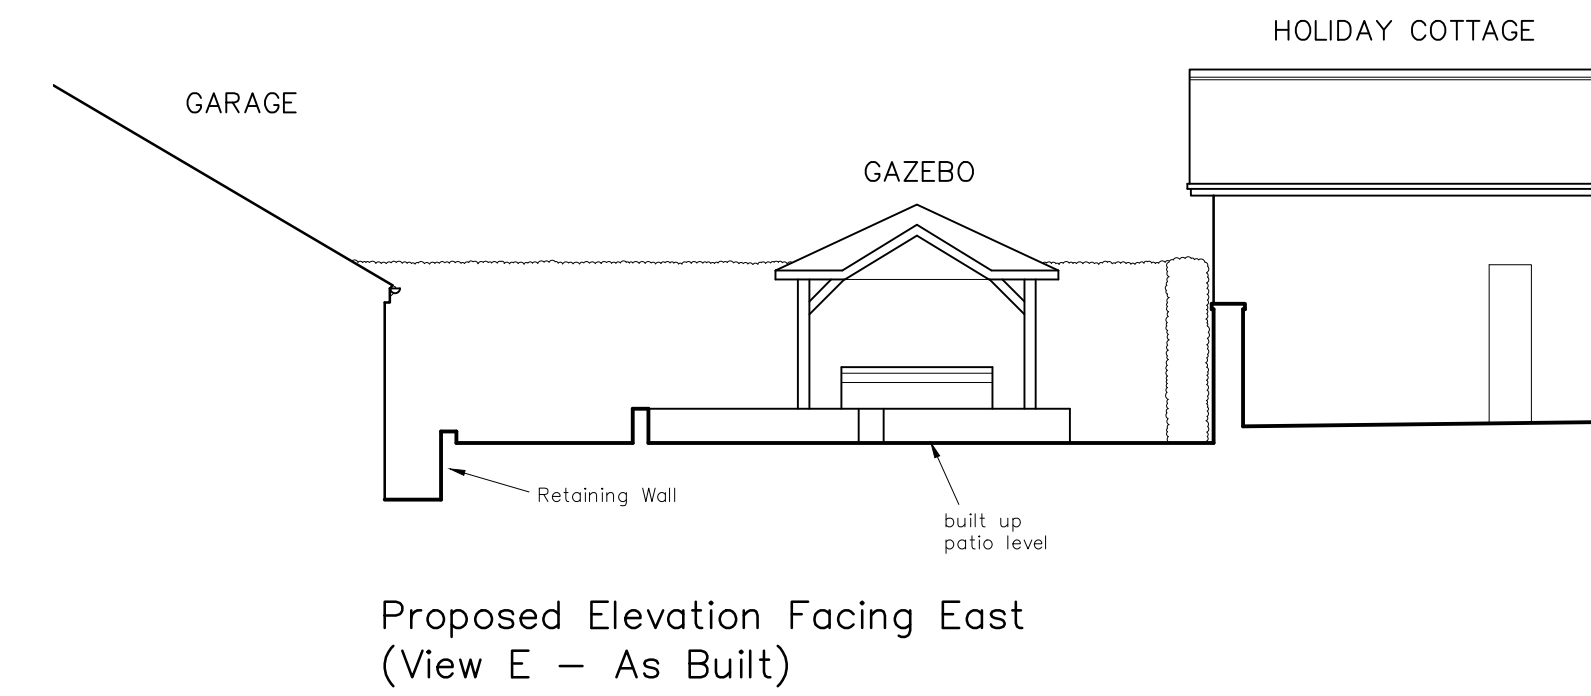


Proposed Elevation Facing East (View E - As Built)

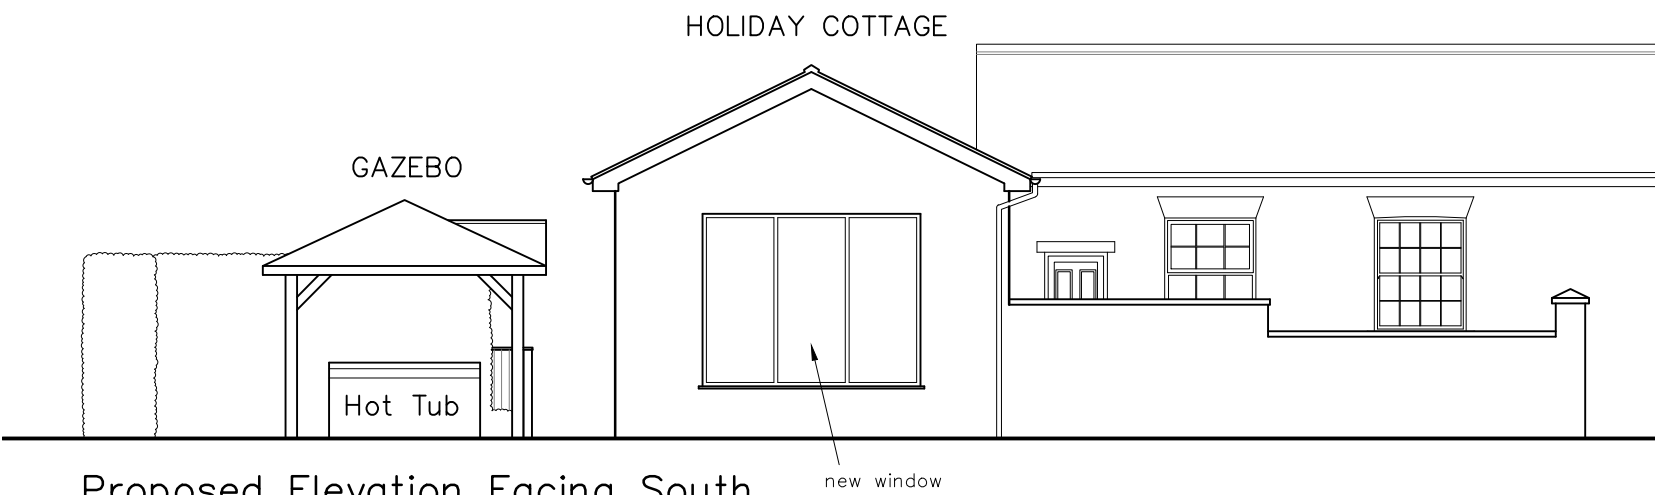


Proposed Elevation Facing South (View B - As Built)

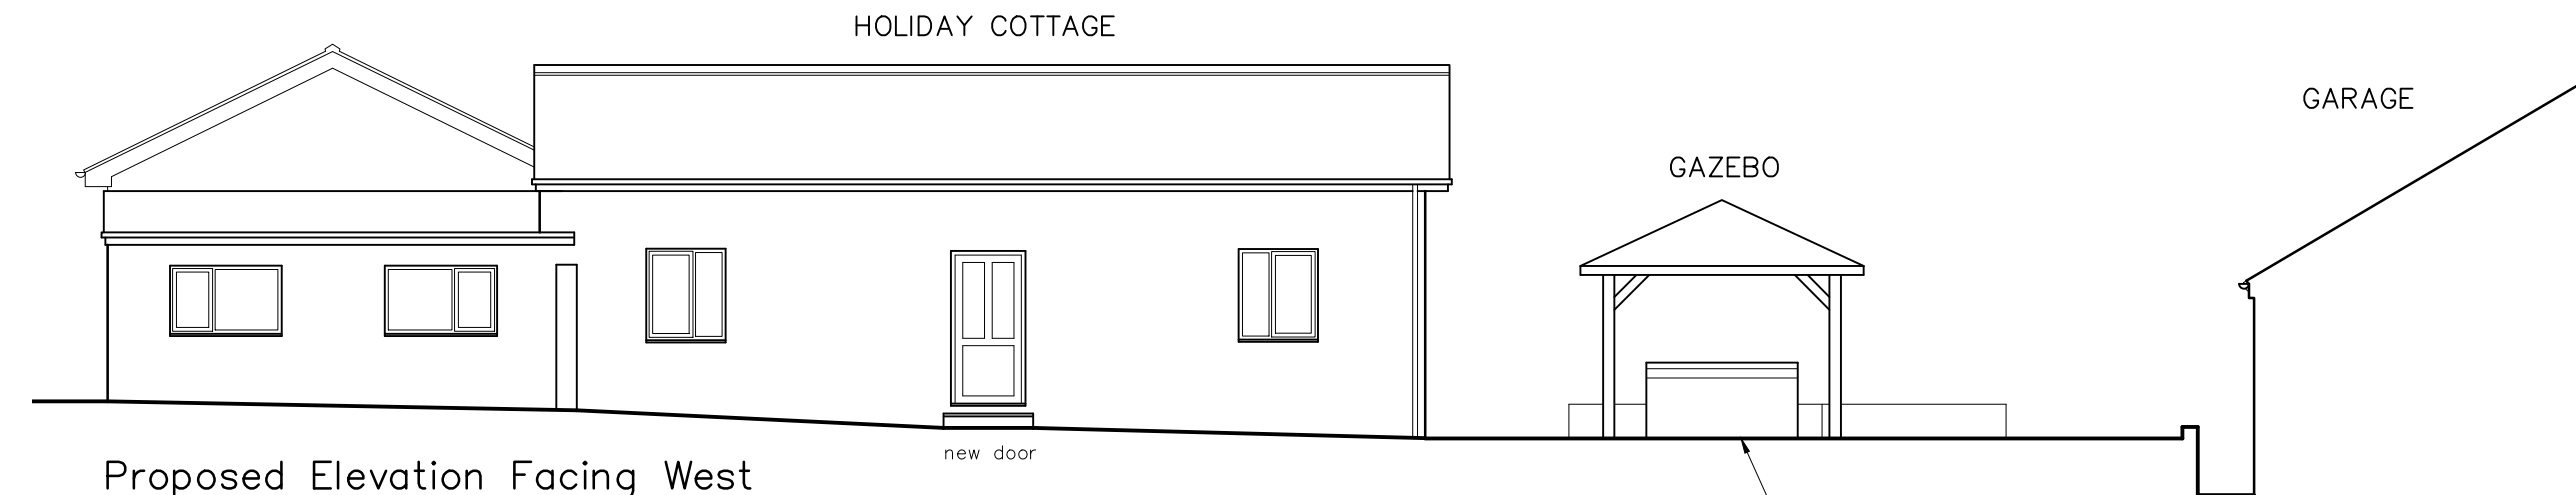


Proposed Elevation Facing West (View C - As Built)

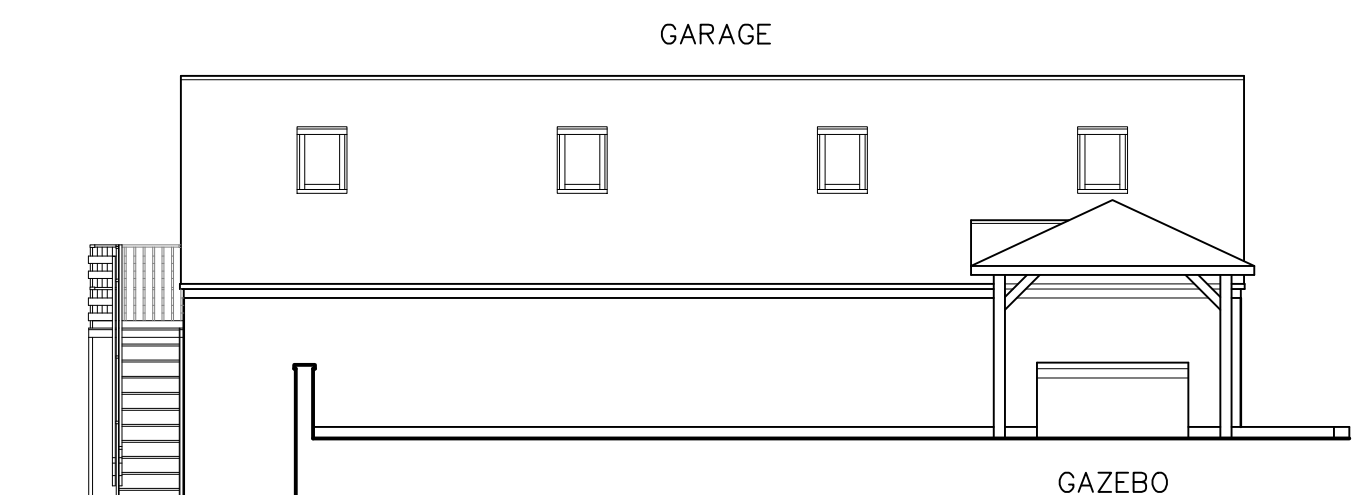

Proposed Elevation Facing North (View D - As Built)

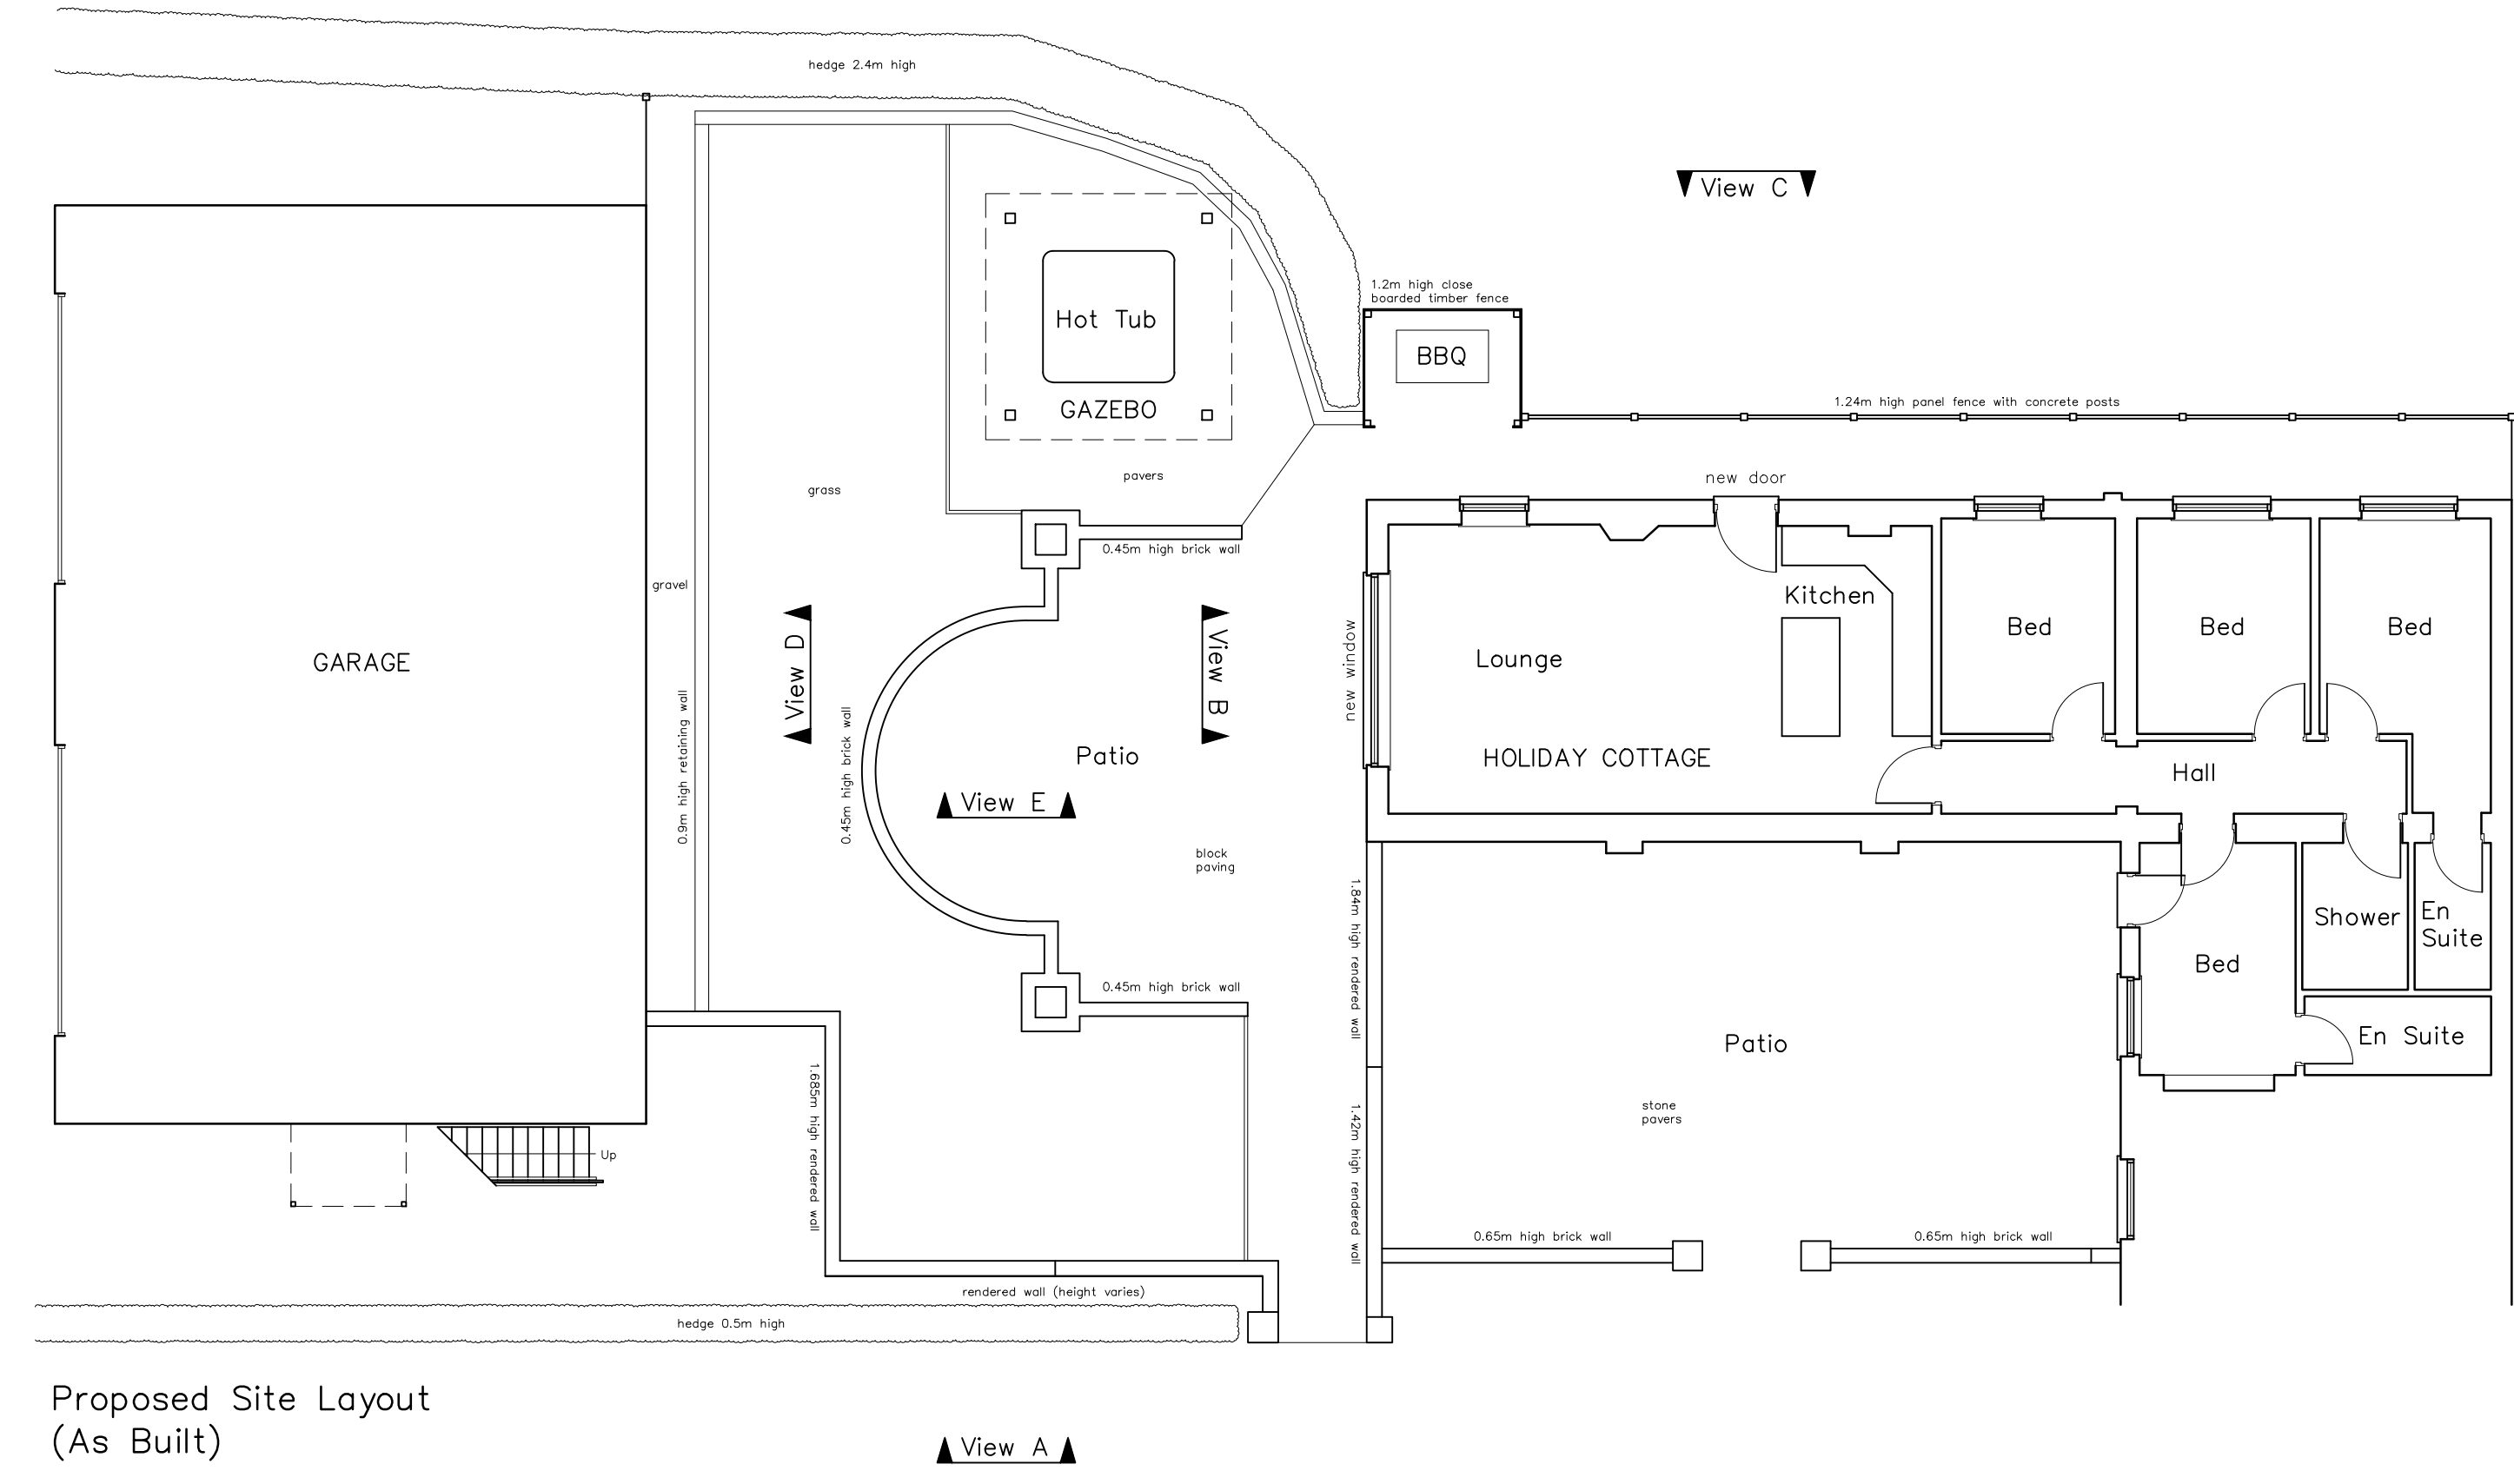

Proposed Site Layout (As Built)

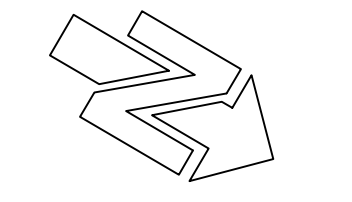

Scale Bar 0 1 2 3 4m

A: Added internal layout 15/03/24

Revisions		Date		
Robert Farrow (Design) Ltd Architecture : Planning : Construction Topographical Surveys Millar House, 32 Northgate, Hessle, East Riding of Yorkshire, HU13 9AA Tel : 01482 640699 E-mail: rfd@farrow.karoo.co.uk				
Client: Mrs. H. Palmer				
Title: Proposed Plan and Elevations Retention of window, door, hot tub/gazebo, patio, boundary walls & external works at: Holiday Cottages, Wold House Wold Road, Nafferton, Driffield, YO25 4LD				
Scale	Drawn by	Drg no.	Date	Contract no.
1:100	SB	2A	Dec23	23085

Scale correct when printed at A1