

Lightbox Architects

1 Kings Meadow
Osney Mead
Oxford
OX2 0DP
t 07901 521084
lightboxarchitects.com


title
extension and alteration to
14 Hill View Road
Oxford
OX2 1BZ
for Sara Mackie

drawing
existing ground and first floor plans


drawing number
HVR14 010

scale at A3
1:100 date
April 2022 drawn by
jmac

RECORD DRAWING

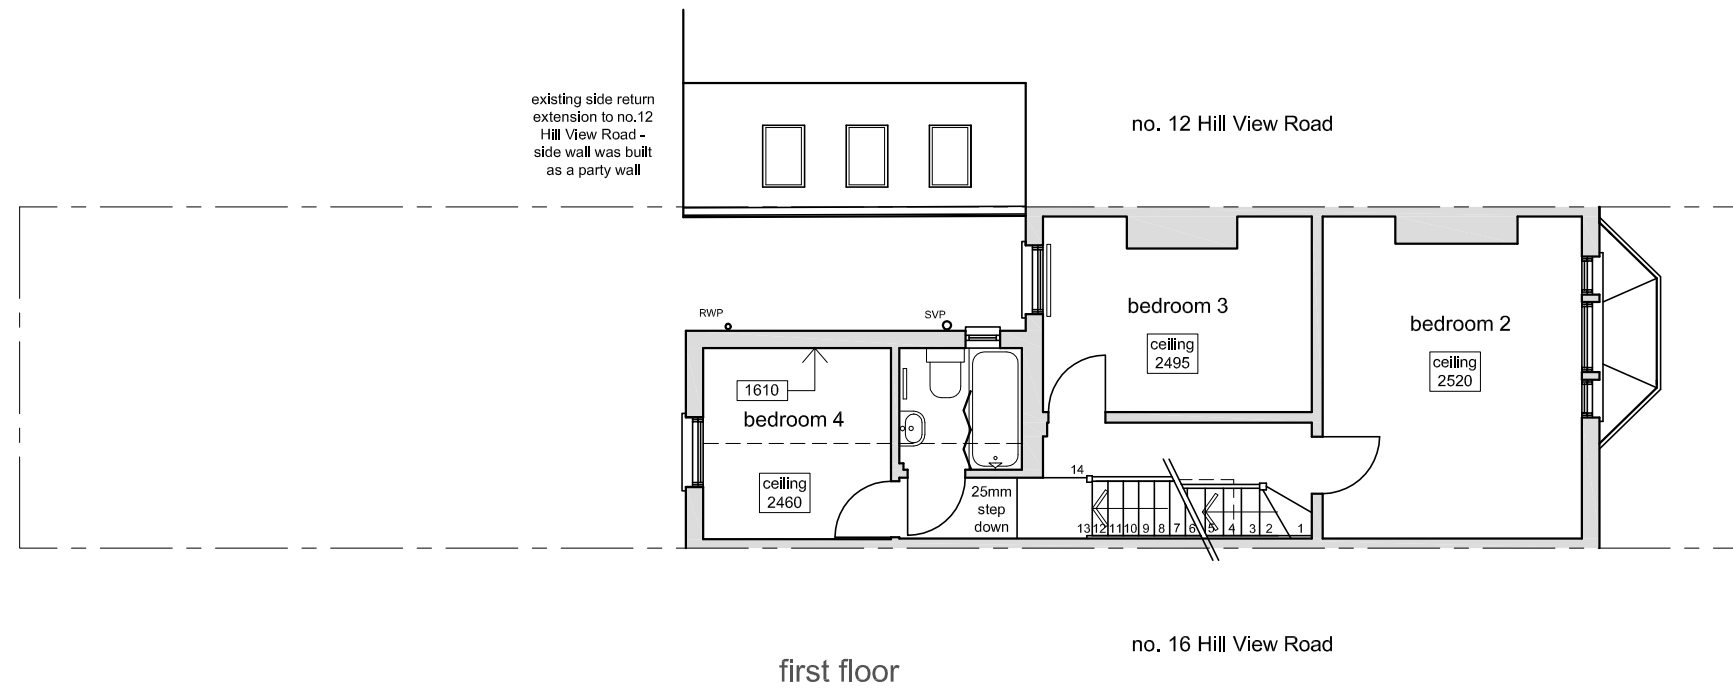

first floor

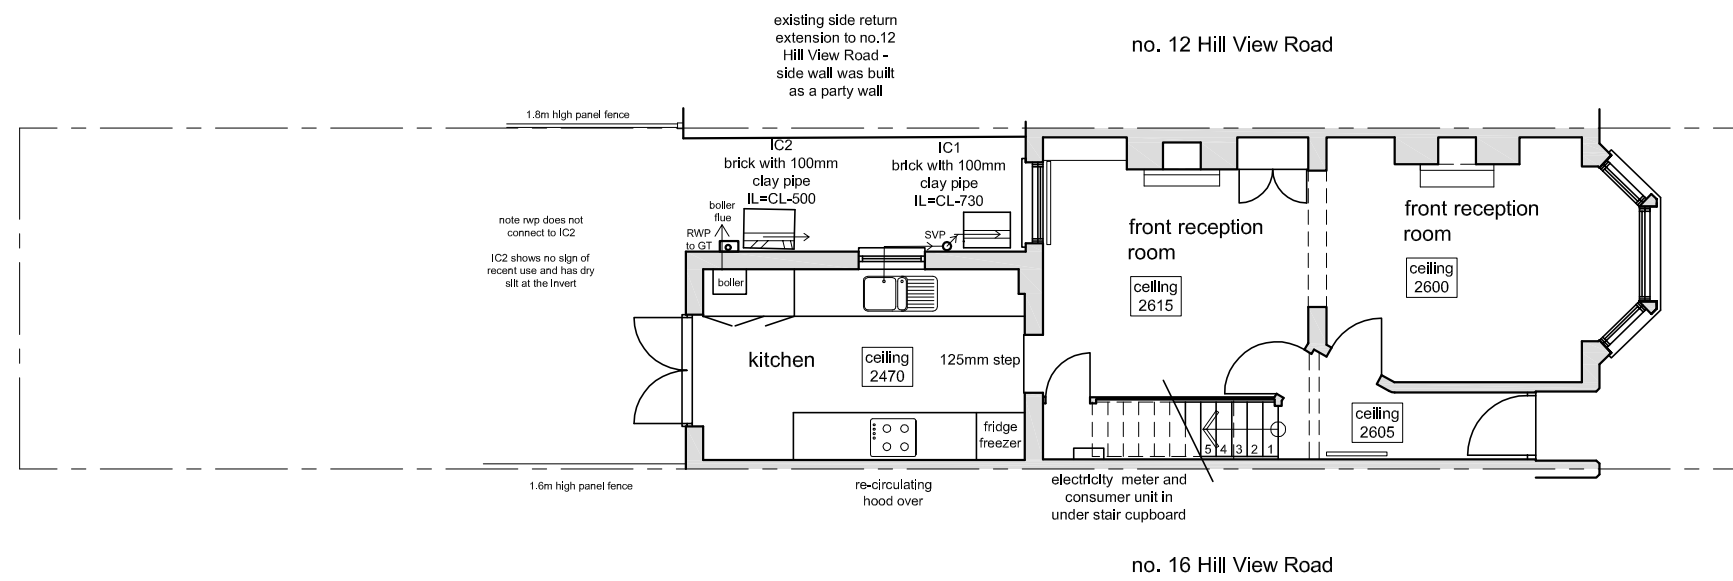

ground floor



notes
do not scale from drawing - use figured dimensions only
any discrepancy or error to be notified to Architect immediately
if in doubt - ask
do not build from any drawing unless marked
FOR CONSTRUCTION