


SINGLE STOREY SIDE
EXTENSION BUILT UNDER
PERMITTED DEVELOPMENT

ORCHARD DR

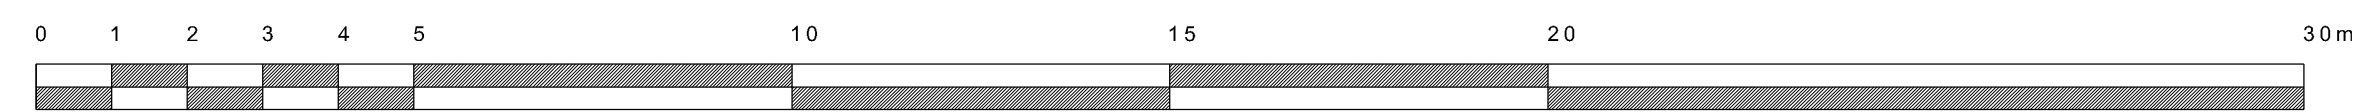

Rev.	Date	Description	Drawn	Checked	Project	Scale	Sheet
B	03.01.24	Revised link to garage and amended roofscape.	AR	JT	Replacement Dwelling, 46 Orchard Drive, Watford WD17 3DY	1:100 @ A1	1 of 3
A	30.11.21	Revised link to garage and amended roofscape.					2 of 3
<p>Thorne ARCHITECTURE</p> <p>The Centre for Innovation Wolverhampton Science Park Cobden Drive, Wolverhampton, WV10 8TL Tel: 01902 717792 Fax: 01902 717793 Email: info@thornearchitecture.co.uk</p>							<p>As Built</p>
Date	Job No.	Dwg No.	Rev.	Proposed Site Plan			
Jul.20	20112	900	B				

The copyright of this drawing and all the works described herein is owned by Thorne Architecture Limited. Do not scale this drawing. Work to figured dimensions only. If in doubt, ask!!!