




Front West Elevation...

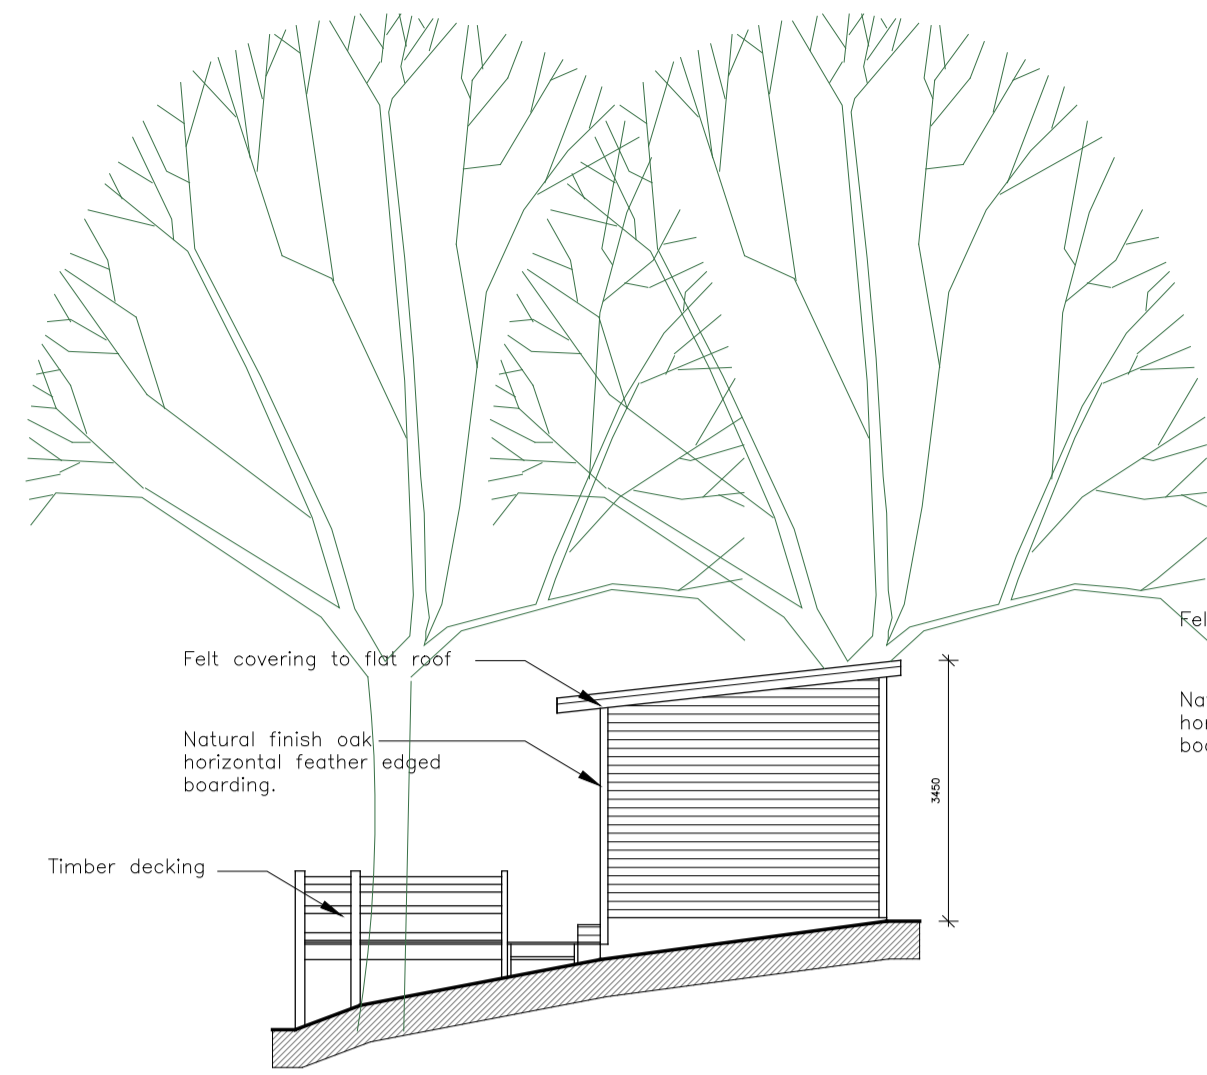


Right South Elevation...

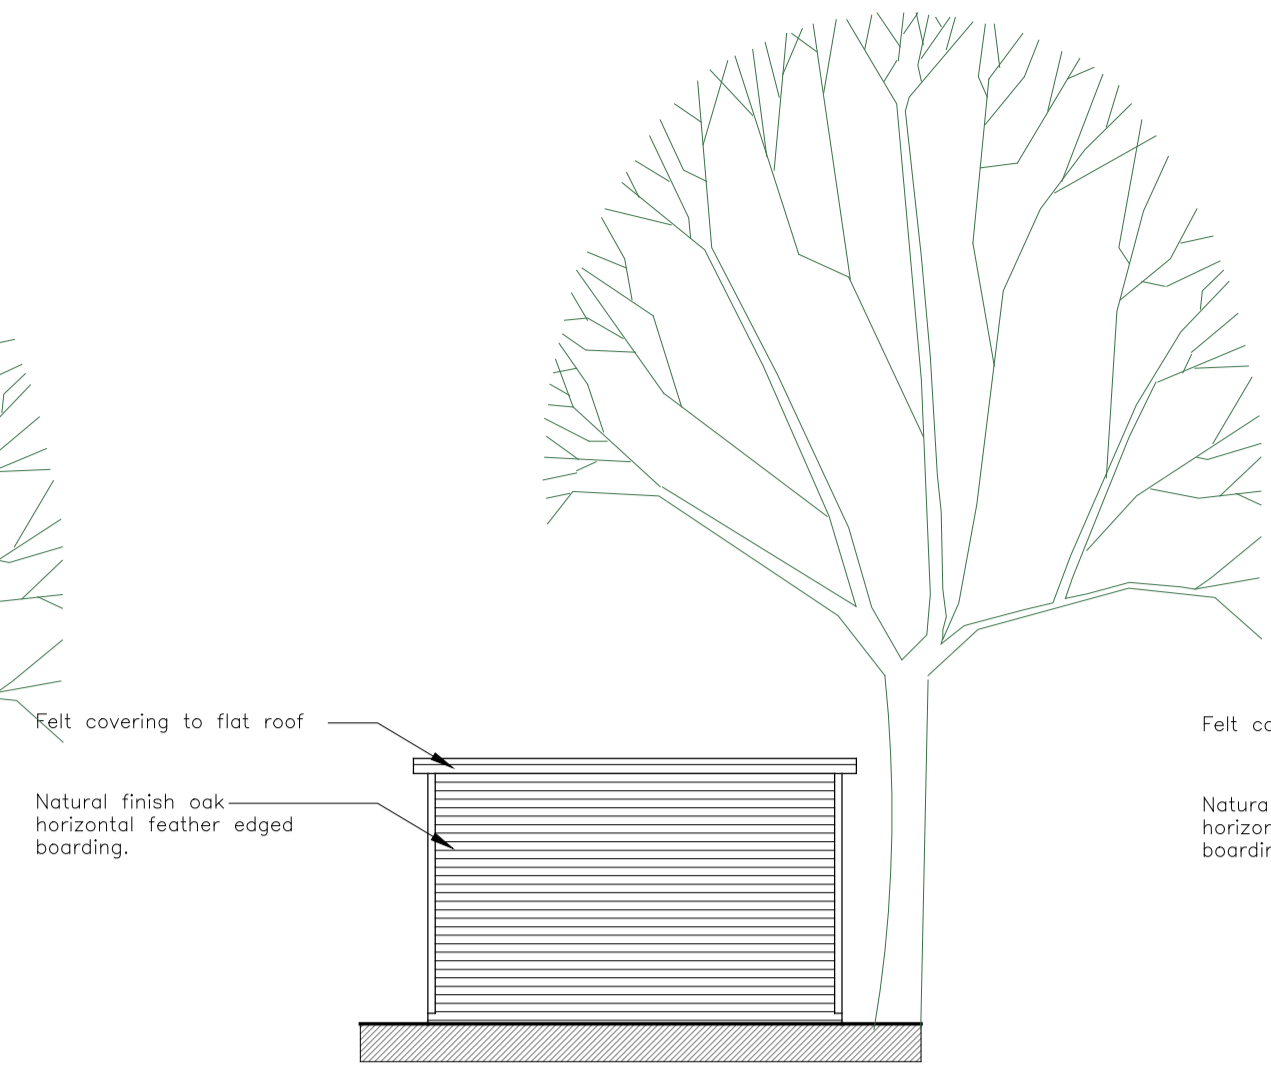


Rear East Elevation...

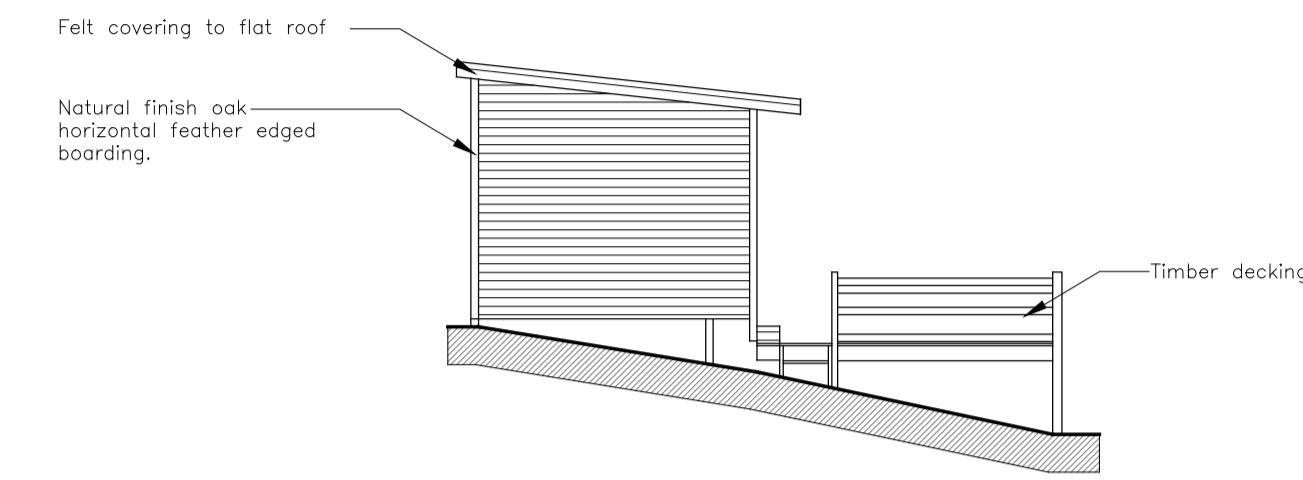



Left North Elevation...

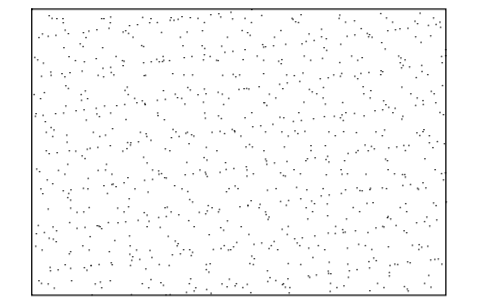

Roof Plan...

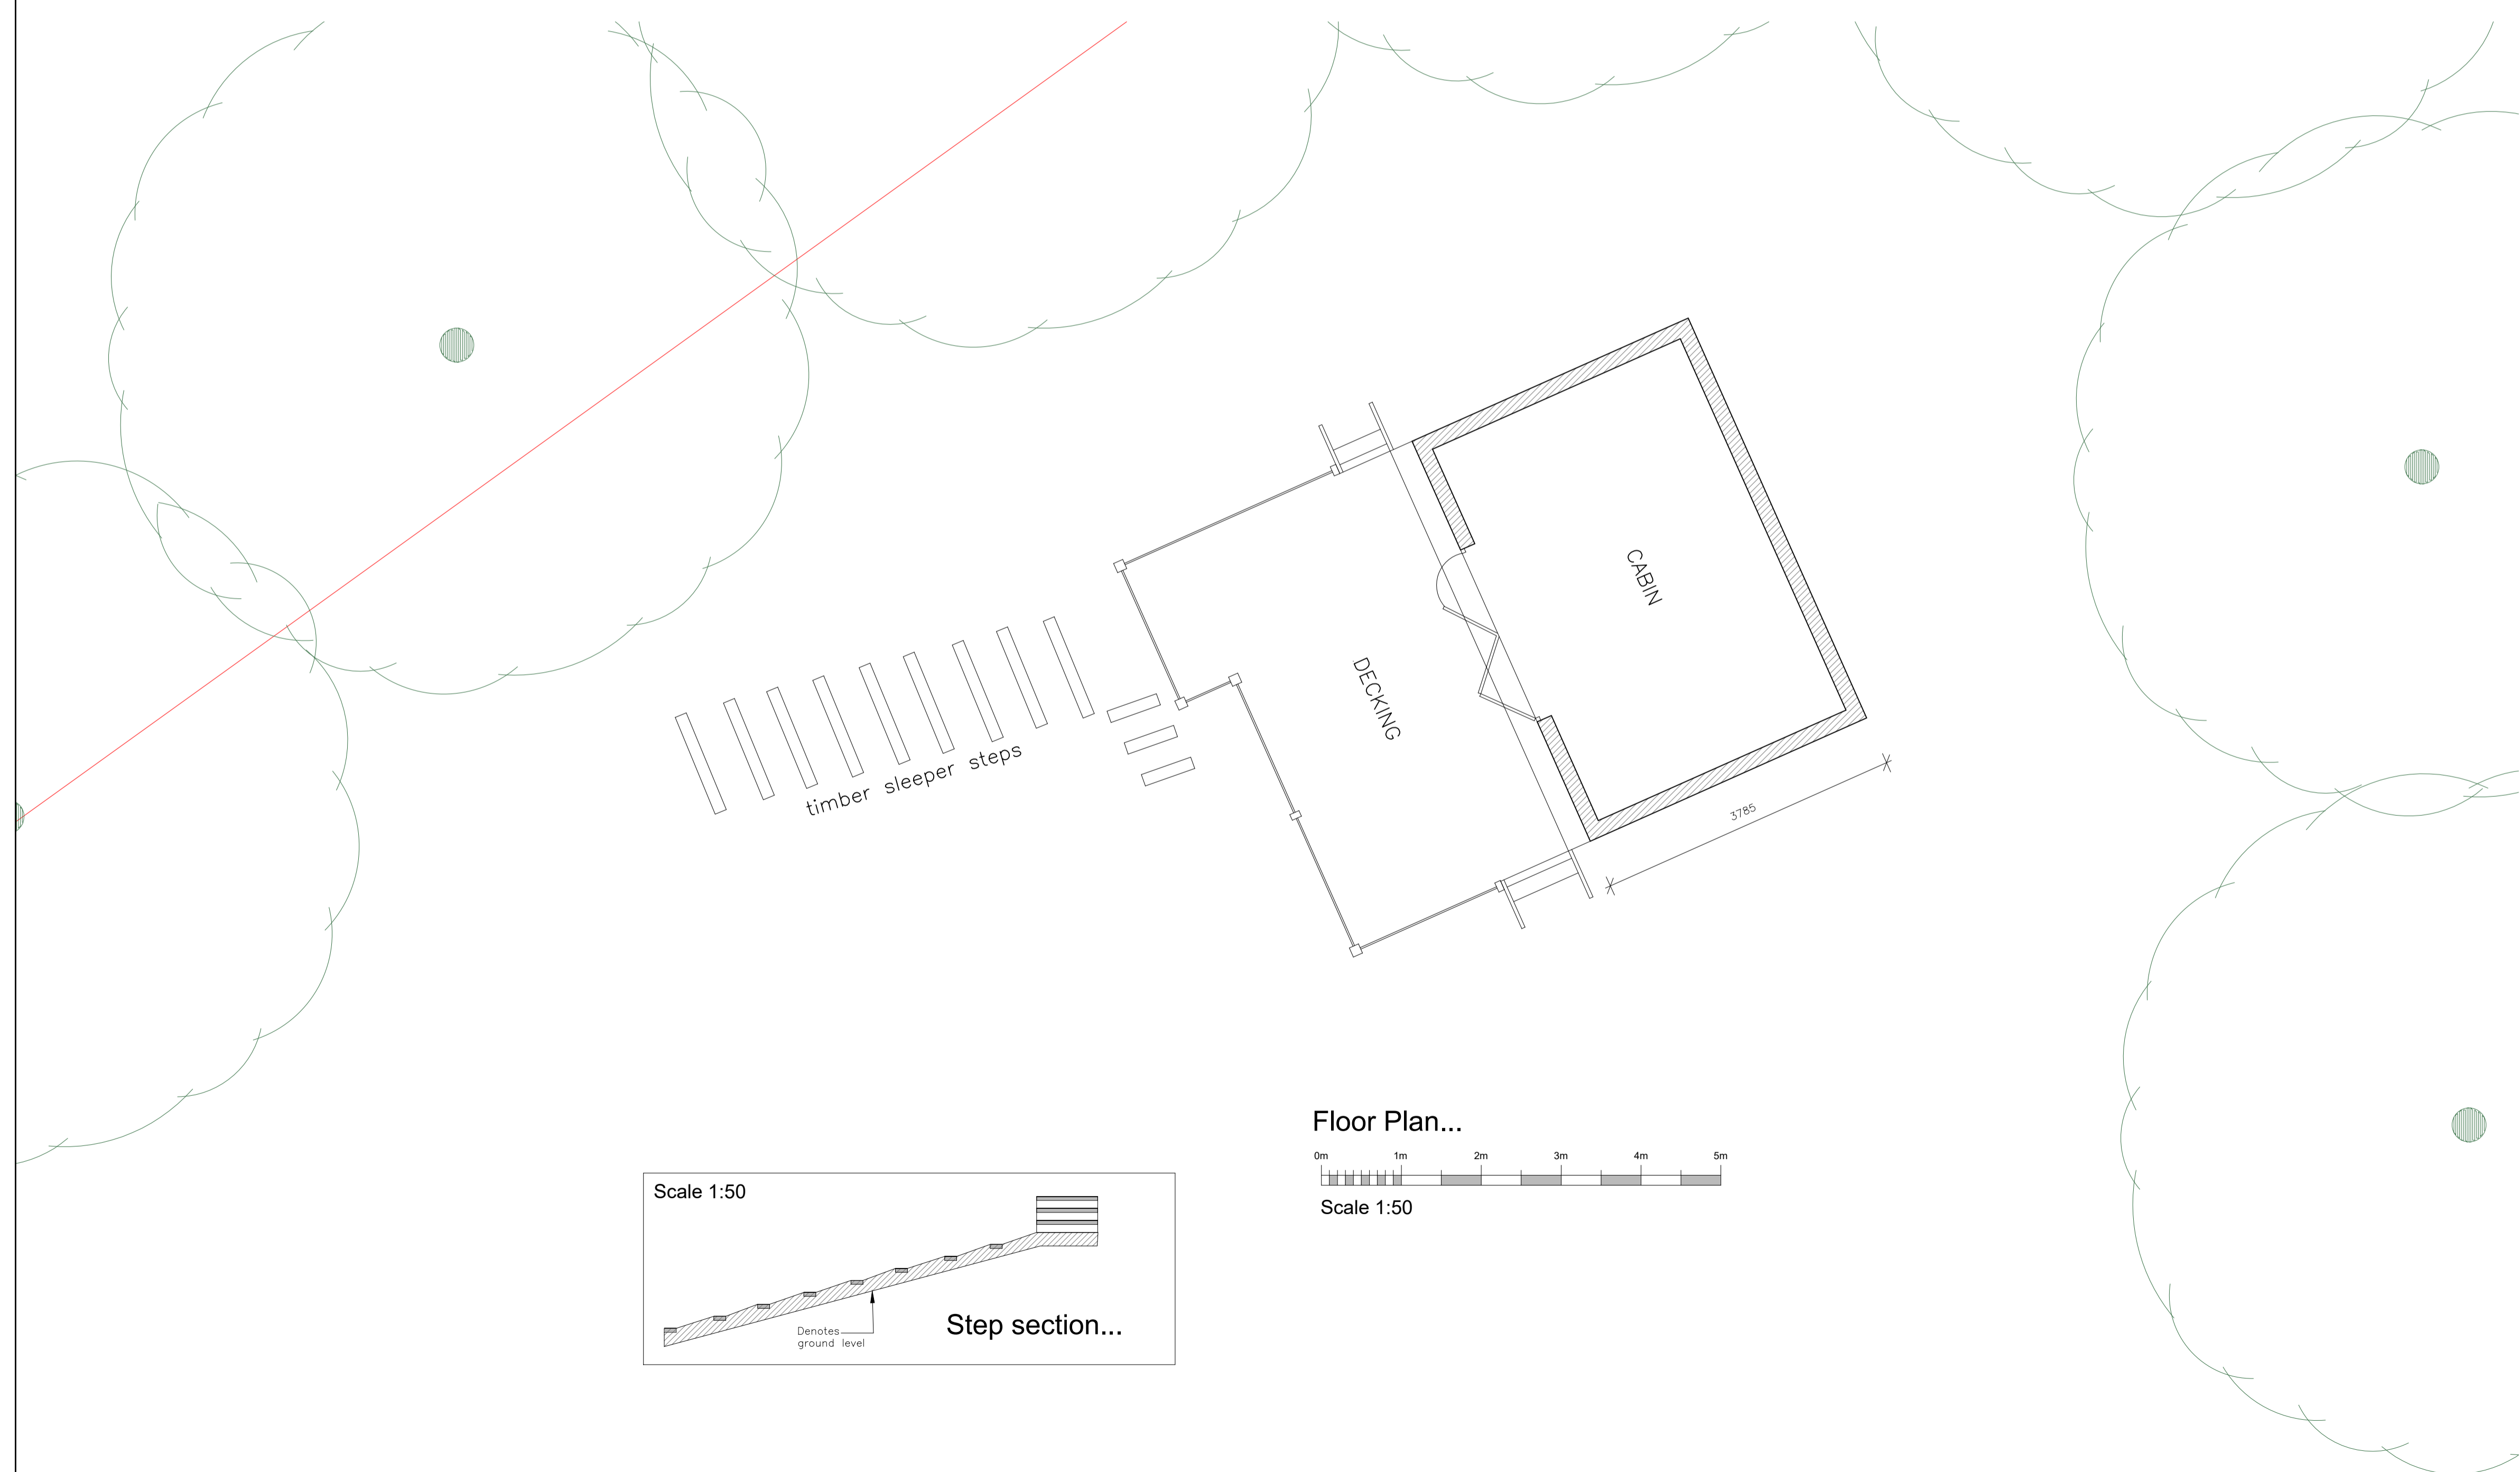

Floor Plan...

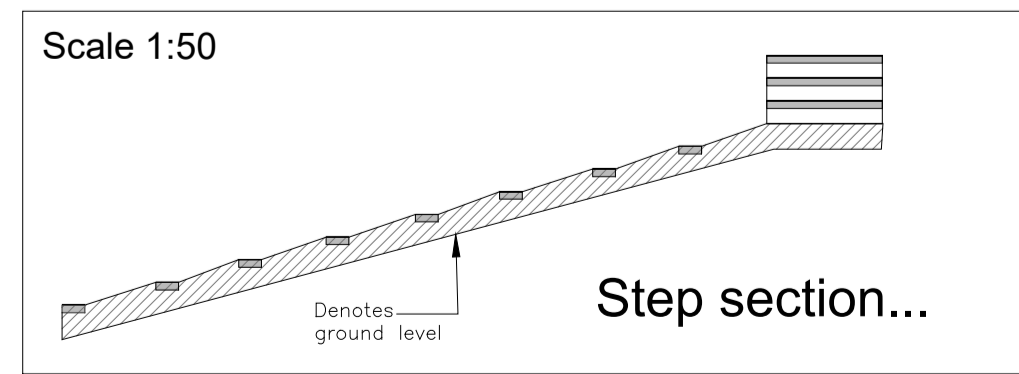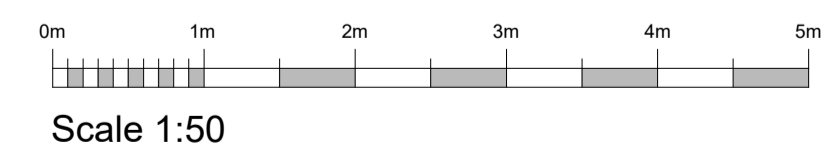

revision	date	amendment	initials

# HARRINGTONS

2006  
building design consultants

48A Hollybush Lane, Sevenoaks, Kent, TN13 3TL tel: 01732 742200  
email: info@harringtons2006.co.uk

project: 51 Greenhill Road, Otford, Kent, TN14 5RR  
proposed development at...  
client: Mr Steve Herbert

51 Greenhill Road  
Otford  
Kent  
TN14 5RR

drawing title: PLANNING....  
Plans and Elevations as constructed

date: Mar 2024  
drawn: bi

scale: 1:50 1:100 @A1  
drawing no.

03/2024/01B