





NOTES AND REVISIONS

ALL DIMENSIONS SHOWN ARE APPROXIMATE AND WILL VARY DEPENDANT ON CONSTRUCTION DETAILS AND ACTUAL MATERIALS SHOWN. DIMENSIONS SHOWN ARE FOR PLANNING PURPOSES ONLY AND ARE NOT TO BE USED FOR ORDER OF DIMENSION CRITICAL FIXTURES AND FITTINGS. ALL DIMENSIONS SHOULD BE CHECKED ON SITE.

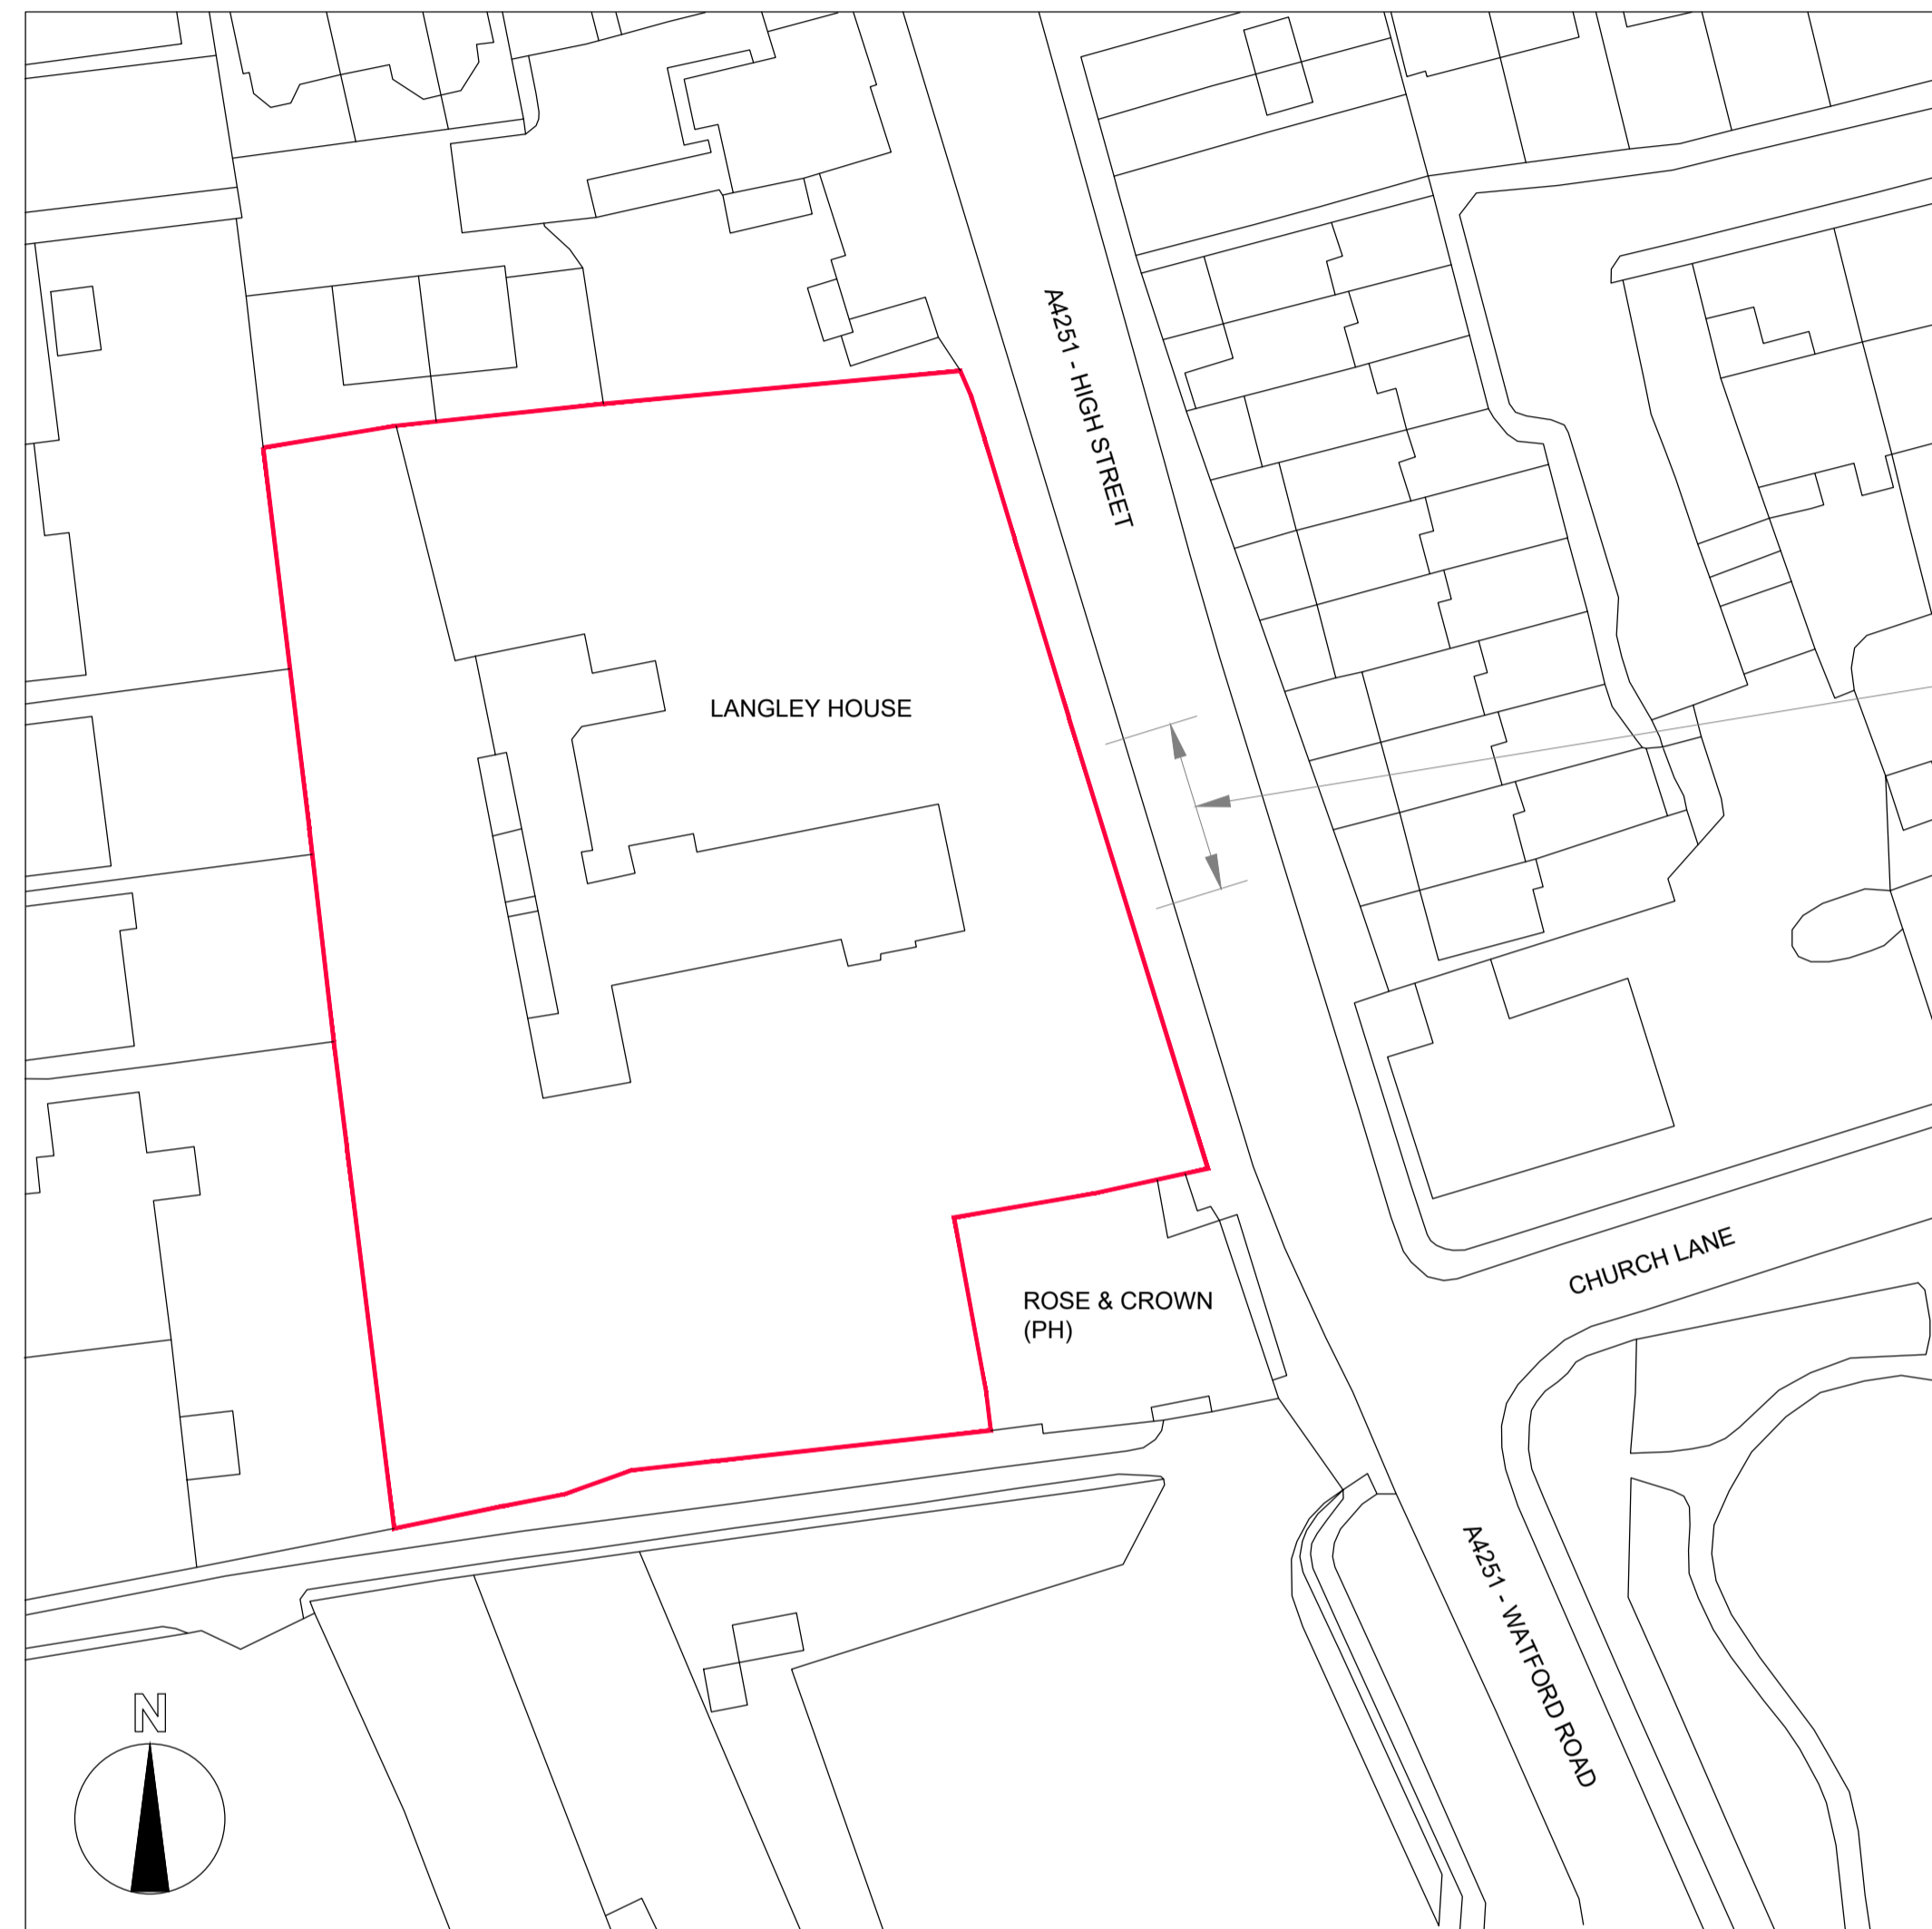


SITE LOCATION PLAN
SCALE 1:1250


SECTION OF WALL
INFILLED

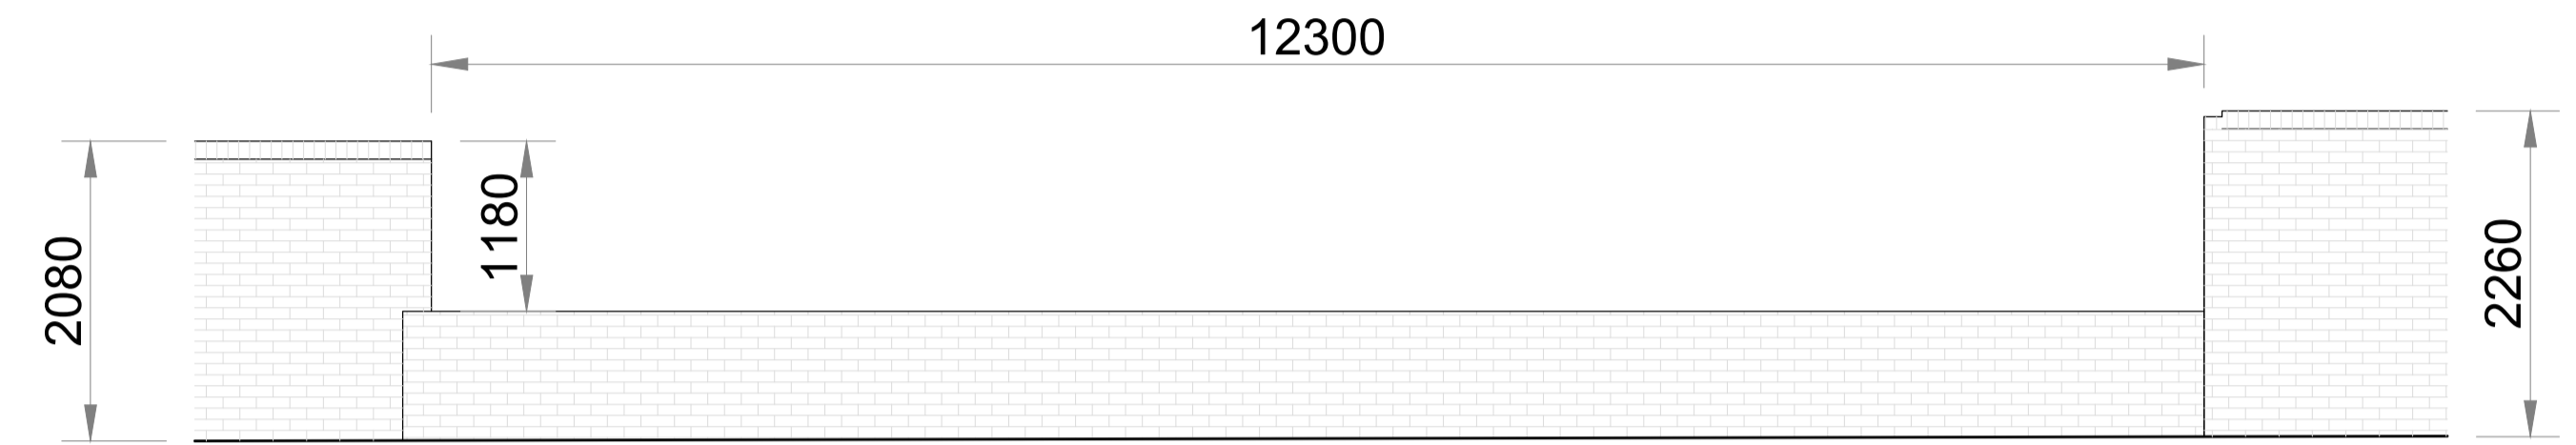

ELEVATION ON SECTION OF INFILLED WALL - EXISTING
SCALE 1:100

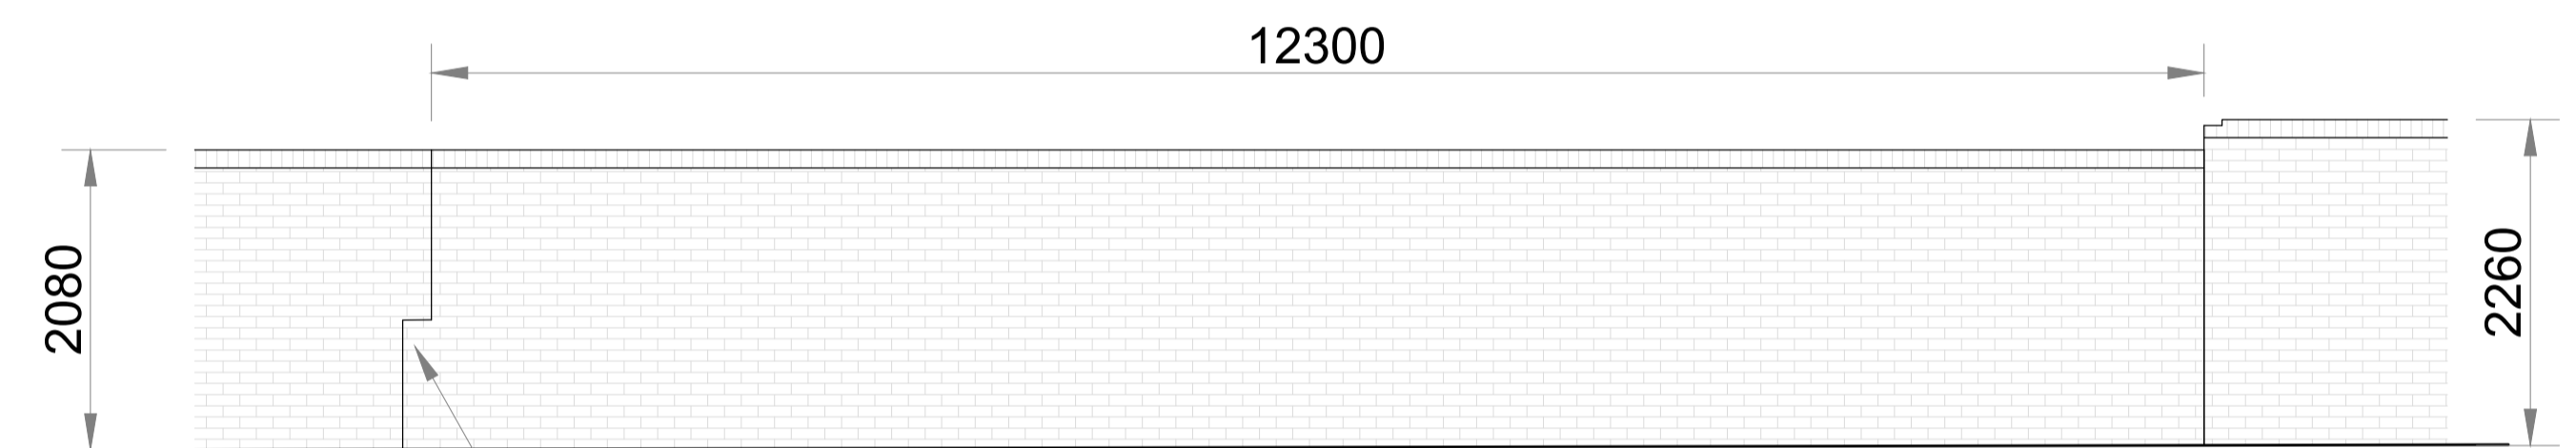

ELEVATION ON SECTION OF INFILLED WALL - AS BUILT
SCALE 1:100

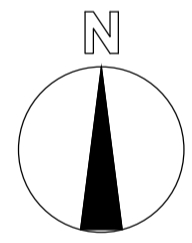

REV	DATE	REMARKS
-	-	-

STATUS **PLANNING**

TITLE **GENERAL ARRANGEMENT**

PROJECT **SECTION OF WALL INFILLED**

- ©THE COPYRIGHT OF THIS DOCUMENT REMAINS WITH RPP PROJECTS LTD
- ALL NEW WORKS TO COMPLY WITH BUILDING REGULATIONS.
 - ALL WORK TO BE CARRIED OUT & SUPERVISED BY COMPETENT PERSONS.
 - ALL DIMENSIONS IN MM AND TO BE CHECKED ON SITE PRIOR TO COMMENCEMENT OF WORKS.
 - EXISTING BOUNDARY LINES TO BE CONFIRMED ON SITE PRIOR TO COMMENCEMENT OF WORKS. CLIENT TO SERVE PARTY WALL ACT NOTICE BEFORE COMMENCEMENT OF WORKS.
 - ALL EXISTING FOUNDATIONS, WALLS, BEAMS, FLOORS, ROOFS ETC ASSOCIATED WITH THE NEW CONSTRUCTION WORKS TO BE EXPOSED AND INSPECTED PRIOR TO COMMENCEMENT ALL TO THE SATISFACTION OF THE LOCAL BUILDING AUTHORITY.
 - # STRUCTURAL ENGINEERS DESIGN RELATING TO STRUCTURAL ELEMENTS CONTRADICTS ARCHITECTS DRAWING & SPEC ENGINEERS DESIGN PREVAILS.
 - ALL MATERIALS TO MATCH EXISTING UNLESS OTHERWISE STATED.

SITE **LANGLEY HOUSE,
HIGH STREET,
KINGS LANGLEY,
WD4 9HT**

DATE **18/03/24** SCALE **1:100 UNO**
DRAWING No. **0324 - 01** REVISION **-**

