



Ceiling ht
2240mm

Elevation A

Elevation B

Scale

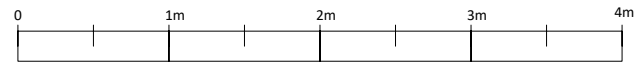

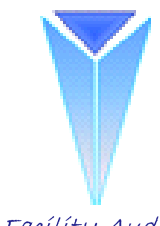				3A Bathway London SE18 6LN	
				TITLE Basement Entry Hall Layout & Elevations As Built	
SIZE	CAGE CODE	DWG NO	REV		
A3		30297-201			
SCALE	1:50	SHEET			