
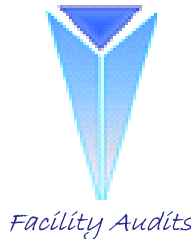


Scale

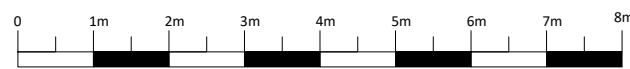

Facility Audits

3A Bathway
London SE18 6LN

TITLE
Basement after Conversion
Layout As Built

SIZE A3	CAGE CODE	DWG NO 30297-101	REV
SCALE 1:100	SHEET		