

Bedroom 2

Ceiling ht
2240mm

Ceiling ht
2240mm

Cupboard 1

Kitchen

Ceiling ht
2240mm



Cupboard 2

Ceiling ht
2763mm

Bedroom 3



Ceiling ht
2763mm



Elevation D

Elevation E

Scale

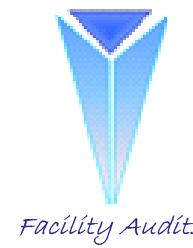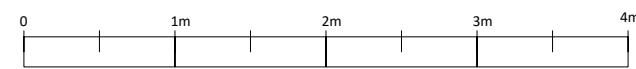

Facility Audits

3A Bathway
London SE18 6FU

TITLE
Basement Kitchen & Bedroom
Layout & Elevations
As Built

SIZE A3	CAGE CODE	DWG NO 30297-203	REV
SCALE 1:50	SHEET		