
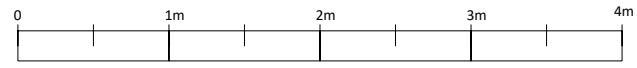


Elevation D

Elevation E

Scale

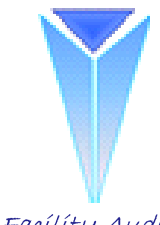

				<b>3A Bathway London SE18 6LN</b>			
				TITLE <b>Basement Kitchen &amp; Bedroom Layout &amp; Elevations As Built</b>			
SIZE	CAGE CODE	DWG NO	REV				
<b>A3</b>		<b>30297-203</b>					
SCALE	1:50			SHEET			