


This confidential drawing and the copyright is the property of MD Designs and is neither to be copied in any way nor disclosed to any third party without the express and written consent of MD Designs. This drawing is to be read strictly together with the Specification and the Employer Requirement Schedule. Any conflict between the Specification and any drawings shall be referred to MD designs for decision.


The Contractor, and all specialist Sub-contractors are to check all levels, dimensions and features on site prior to performing any element of work or installations. Any and all discrepancies are to be reported immediately to MD Designs for decision.

PLANNING & BUILDING CONTROL PERMISSION TO BE OBTAINED PRIOR TO COMMENCEMENT OF WORK ON SITE CLIENT & CONTRACTOR TAKE FULL RESPONSIBILITY FOR WORK COMMENCED PRIOR TO LOCAL AUTHORITY APPROVAL


DO NOT SCALE FROM THIS DRAWING

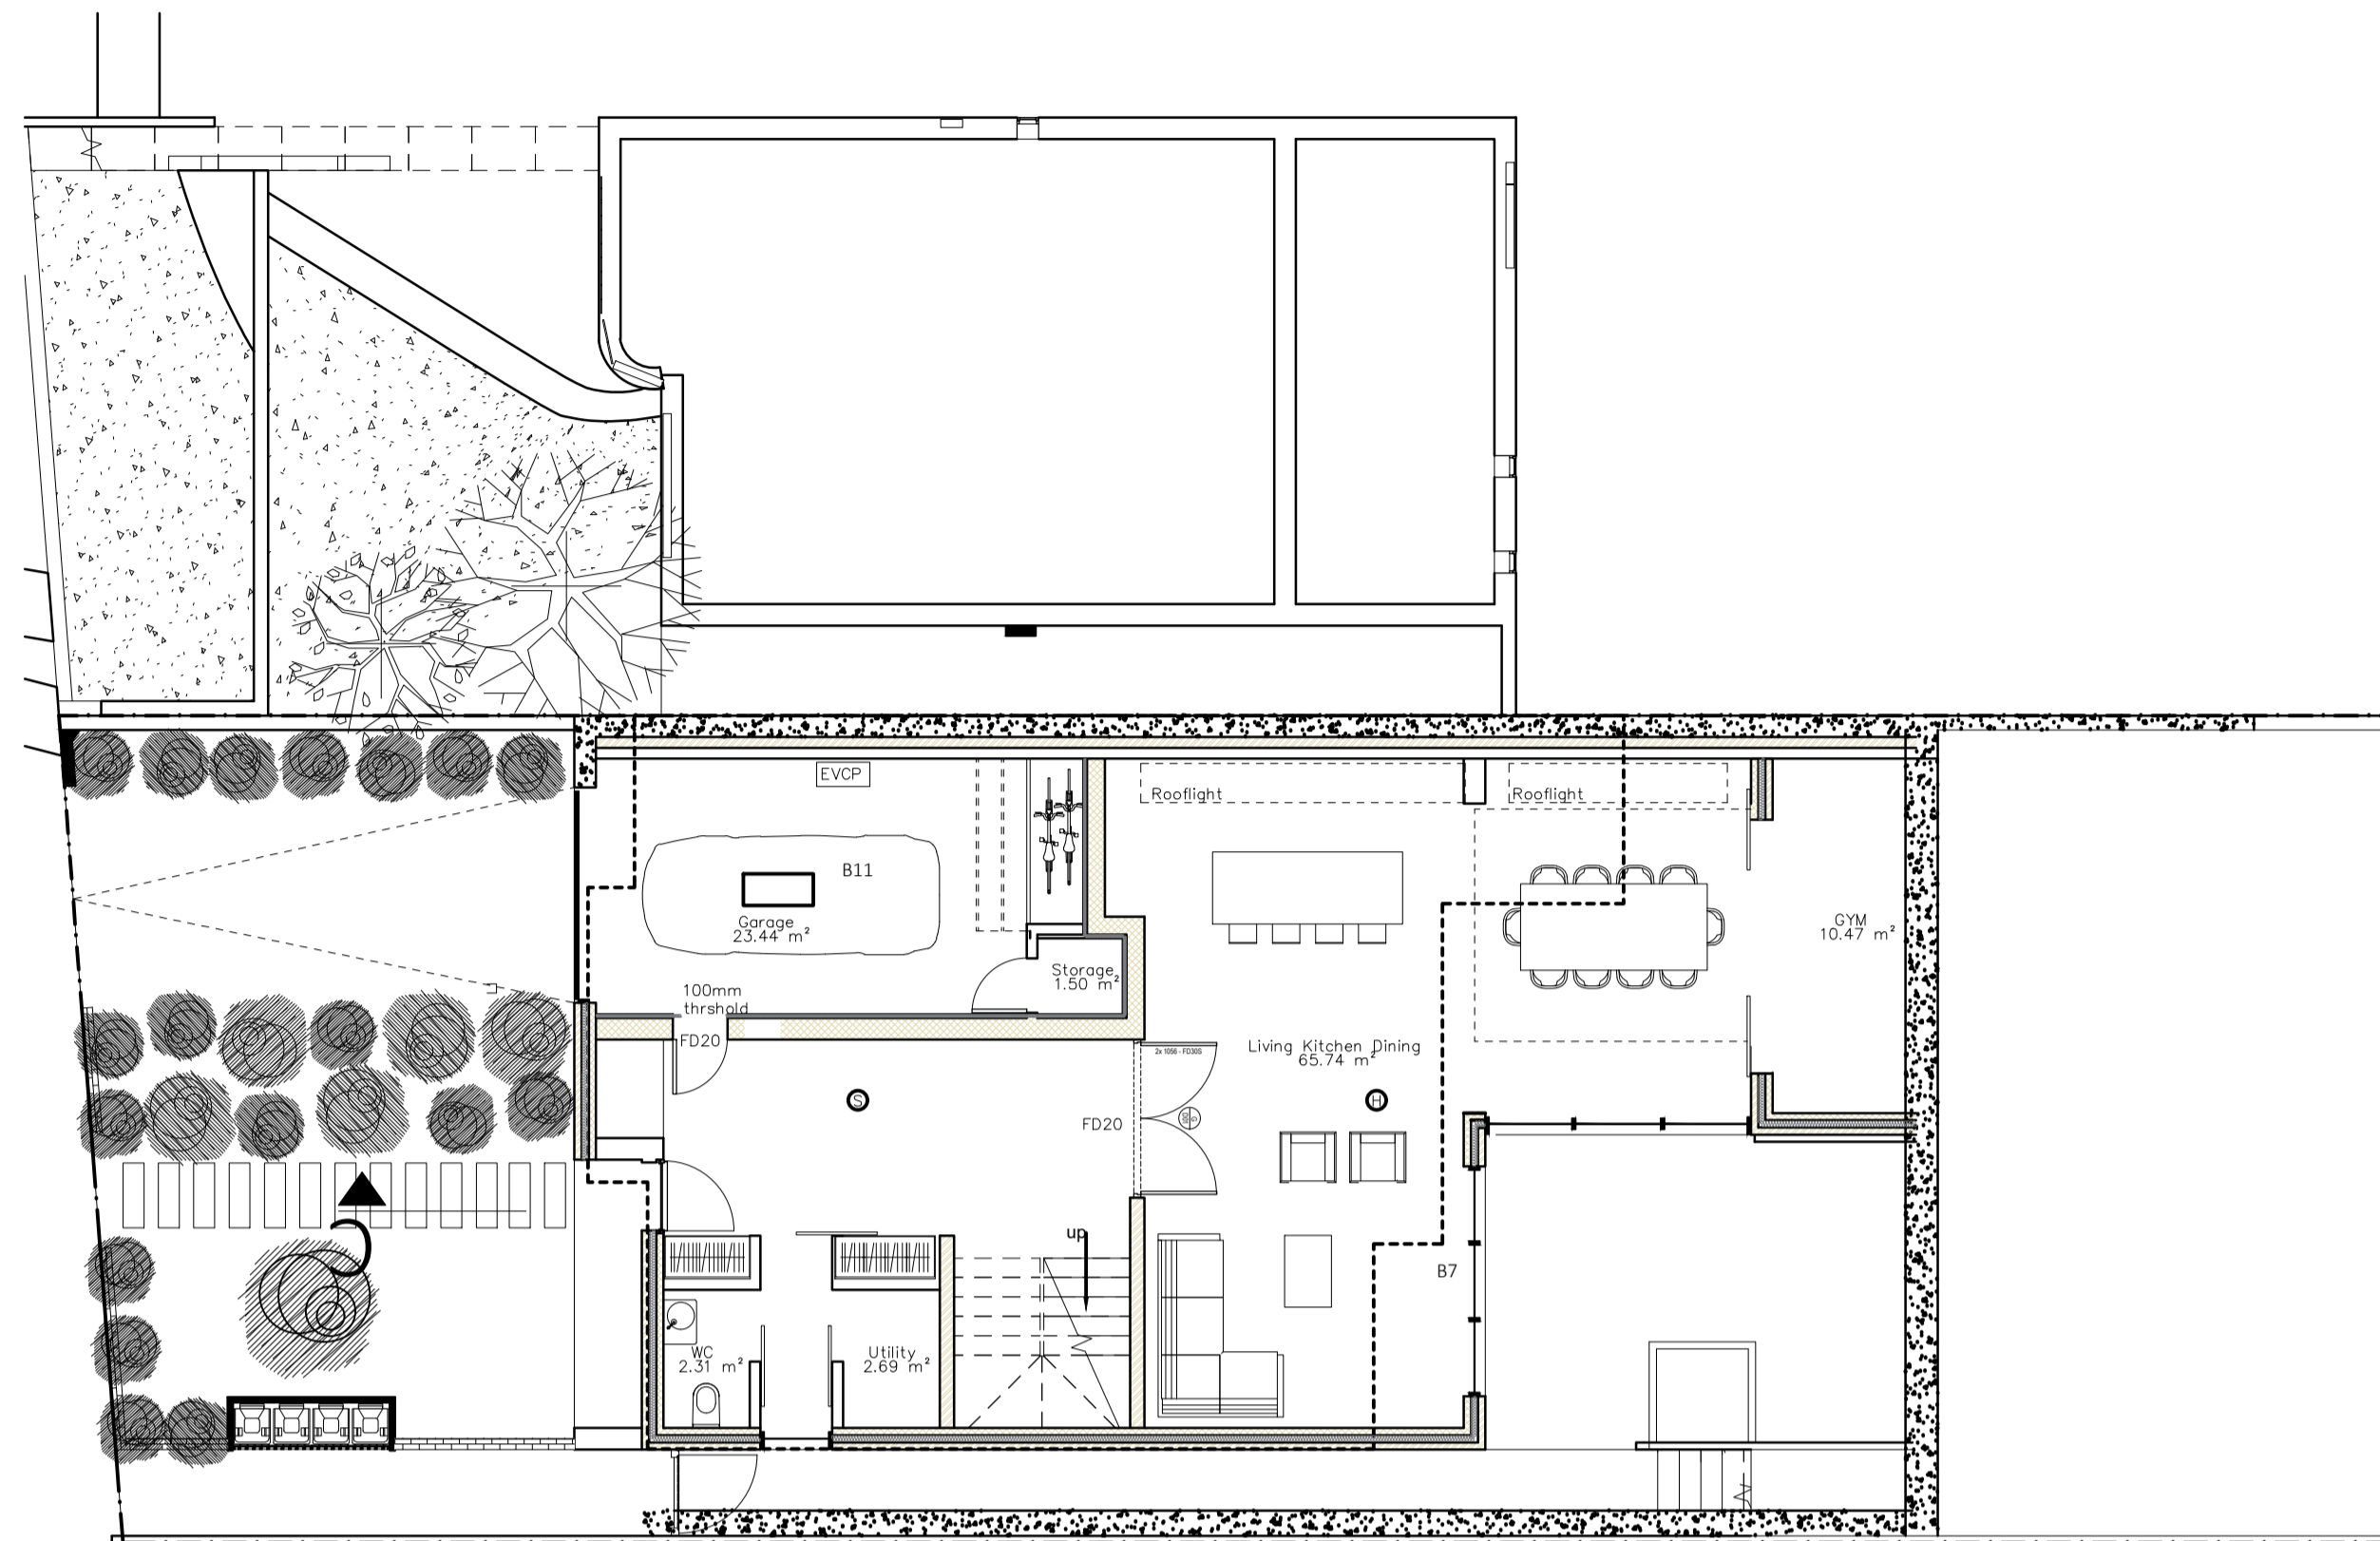


AS BUILT LOWER GROUND FLOOR

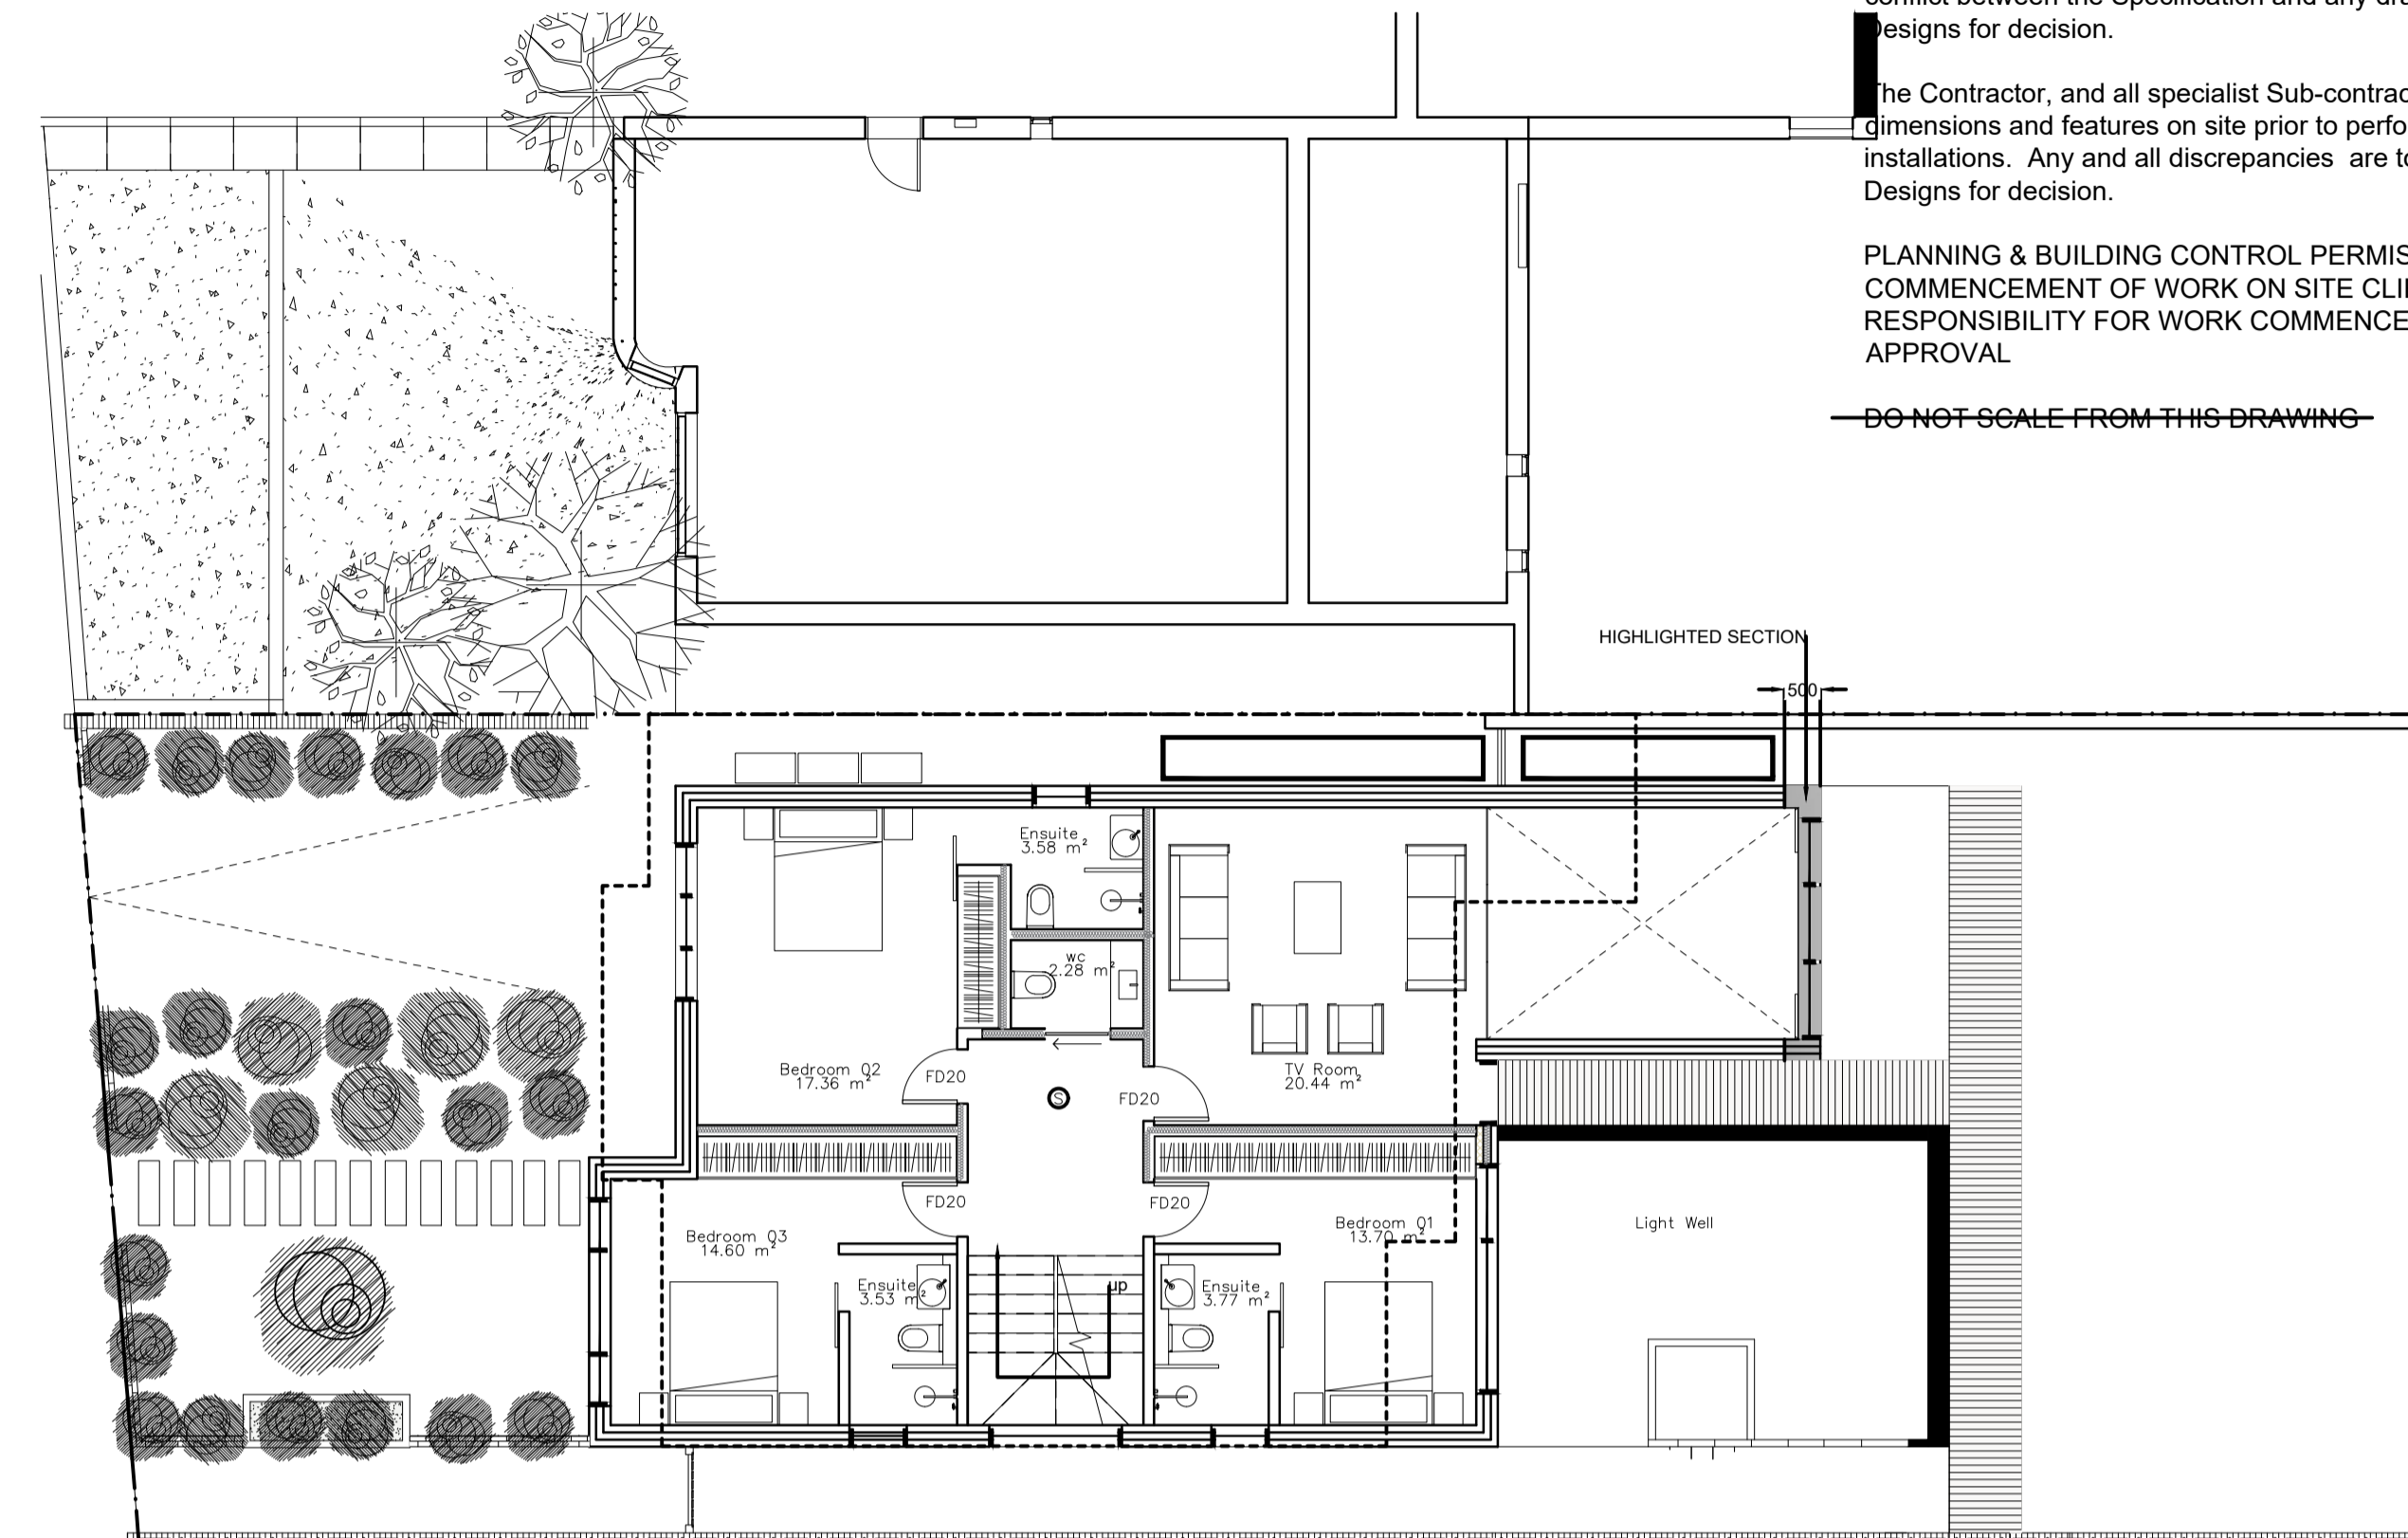


AS BUILT UPPER FLOOR

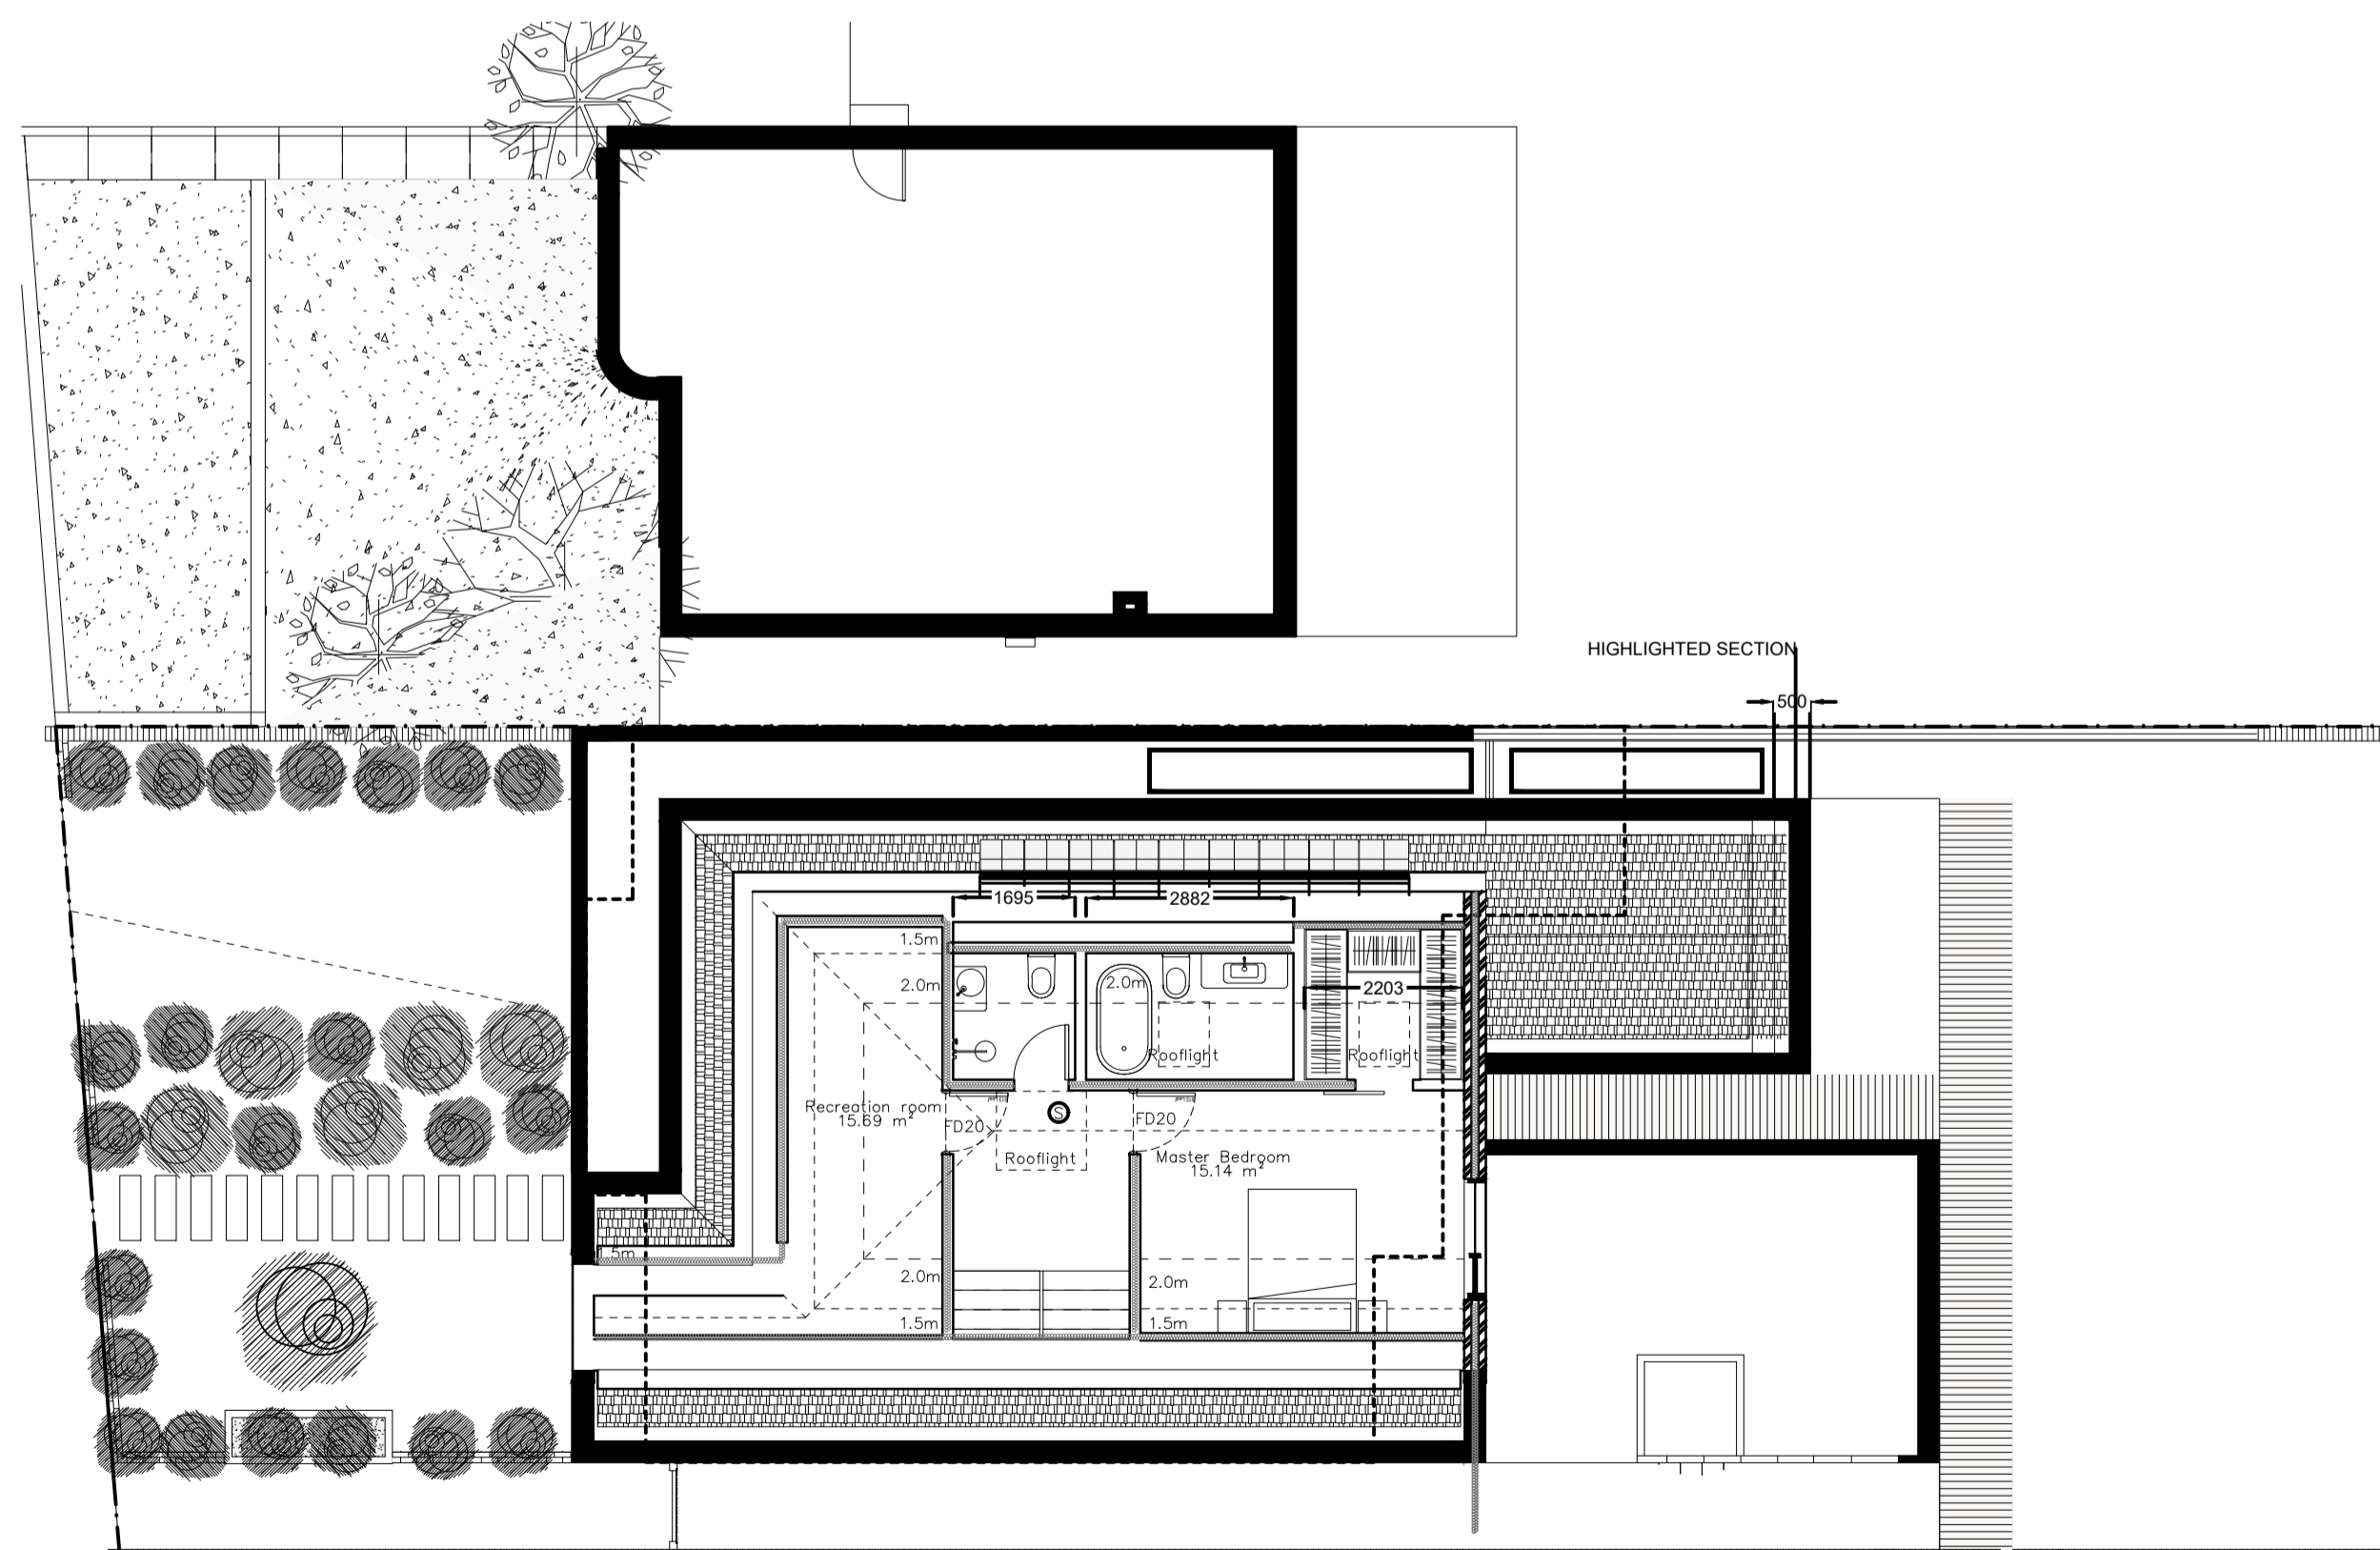

AS BUILT LOFT FLOOR

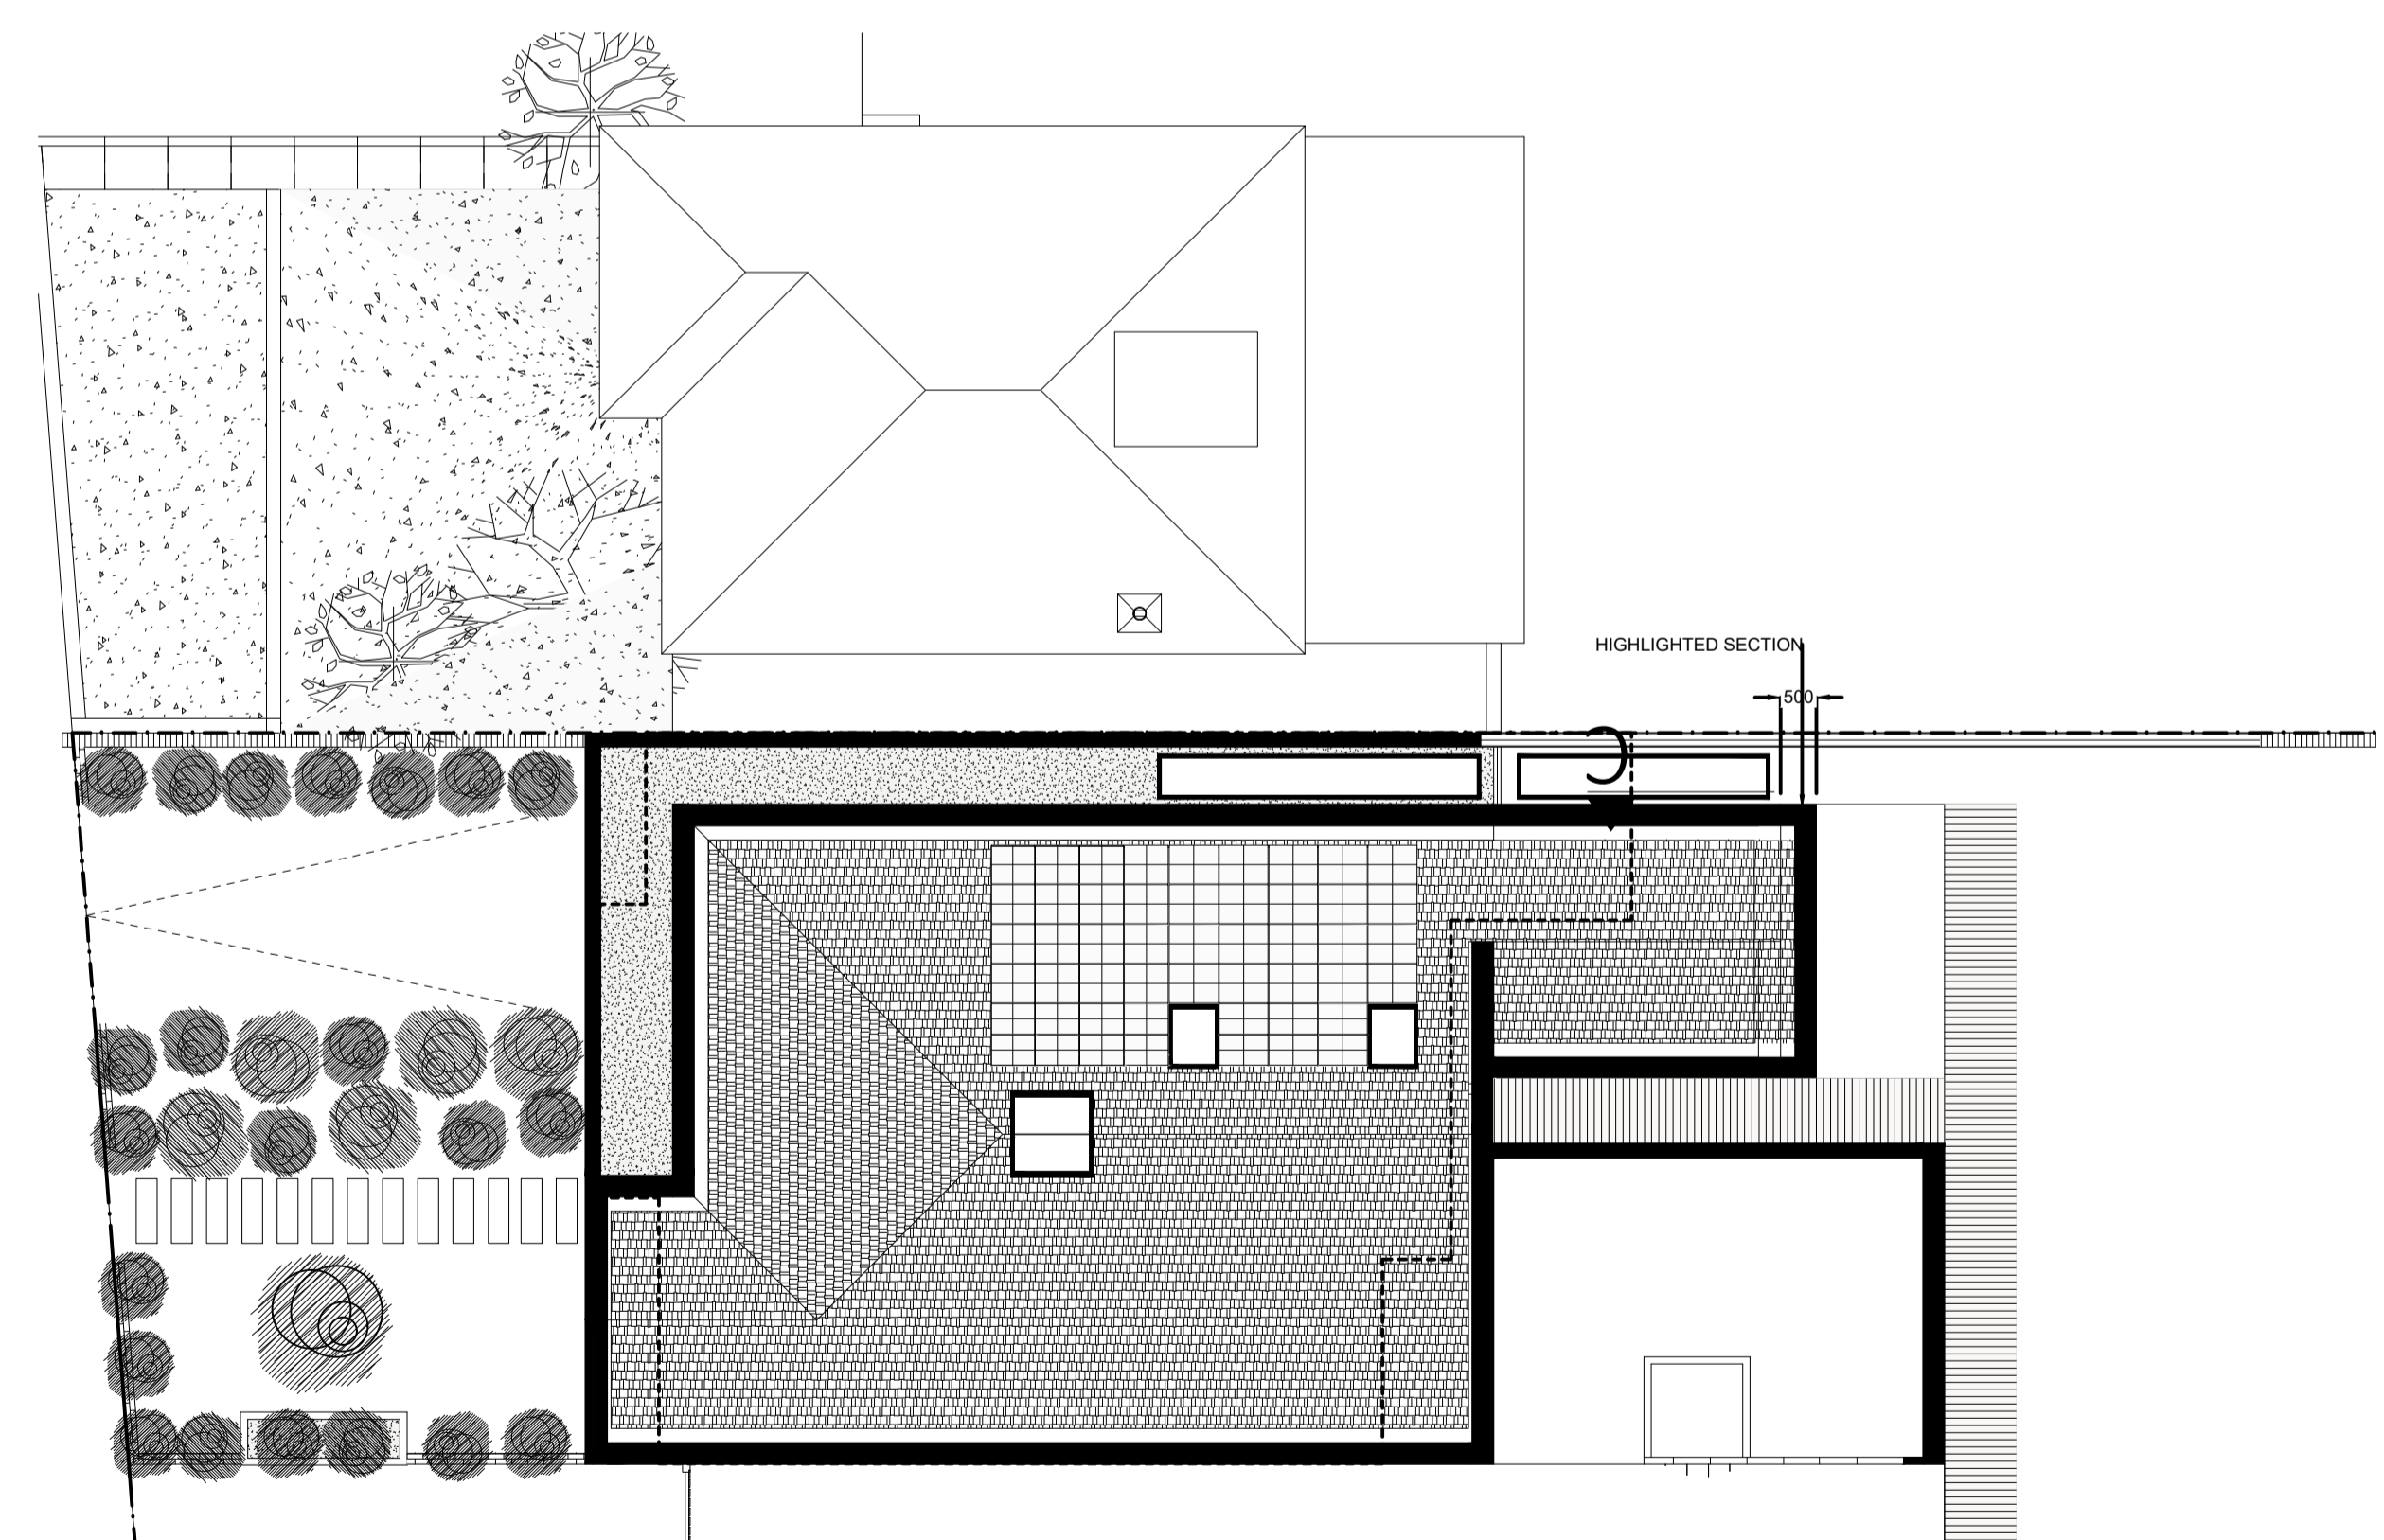

AS BUILT ROOF PLAN

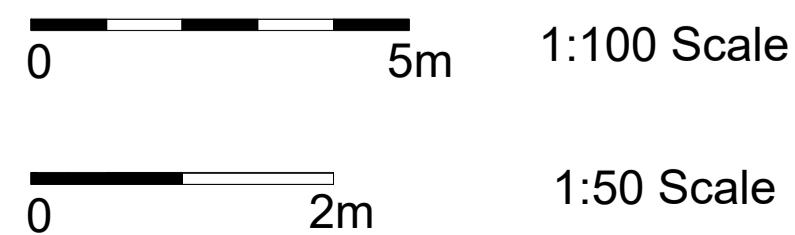

1:100 Scale
1:50 Scale

Where new work is on/near boundary line/party wall the property owner is to serve party wall notice to the adjoining property/land owner in accordance with the requirements of the 'Party Wall etc.' Act 1996.

CLIENT Vav Investments Ltd
LOCATION 73 King Edward Road Barnet EN5 5AU

Proposal As Built Floor Layouts

Date:	15 April 2024
Scale:	A1@1:100
Dwg:	53/24 2
Drawn by:	md

Rev Details Date

MD DESIGNS
9 Jepps Close, Goffs Oak
Herts, EN7 6UT
01992 630 520

